



S.S. "QUEEN LOUISE"

SKETCH SHOWING ADDITIONAL STIFFENING
IN WAY OF BRIDGE DK.

SCALE $\frac{1}{4}" = 1 \text{ FT.}$

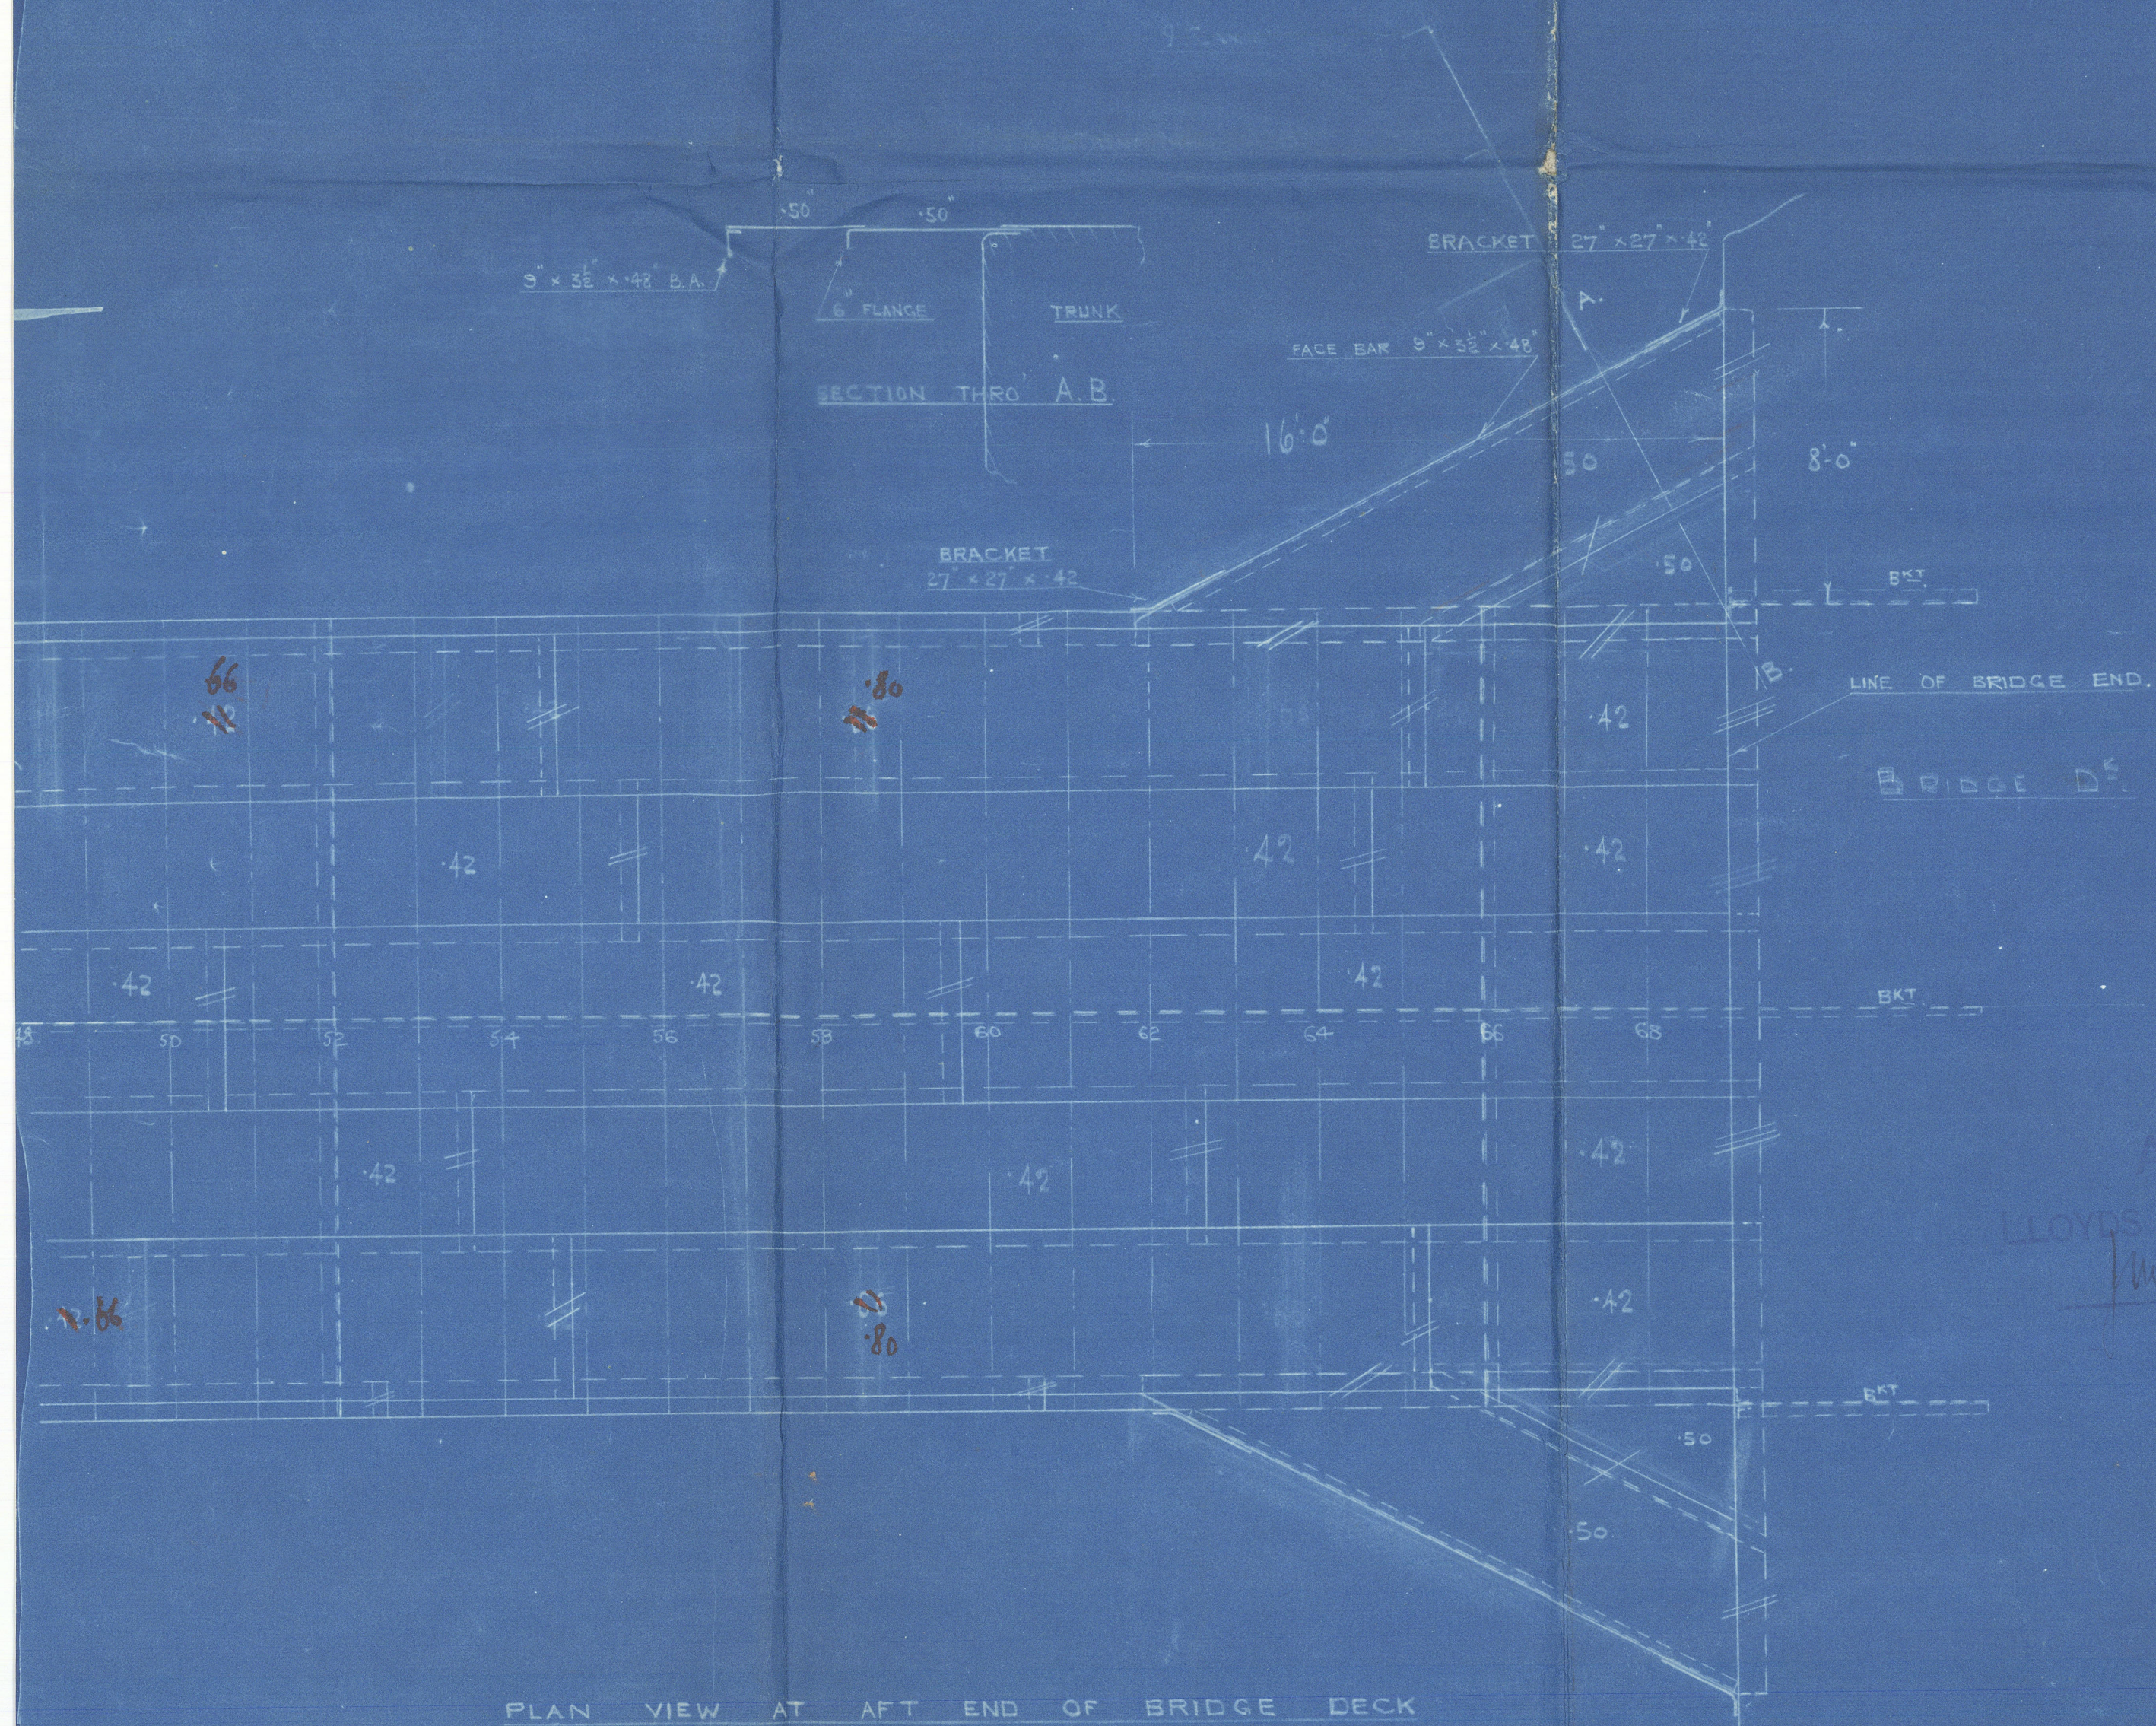


APPROVED BY
LLOYD'S REGISTER OF SHIPPING
Montgomery
S.S. 01

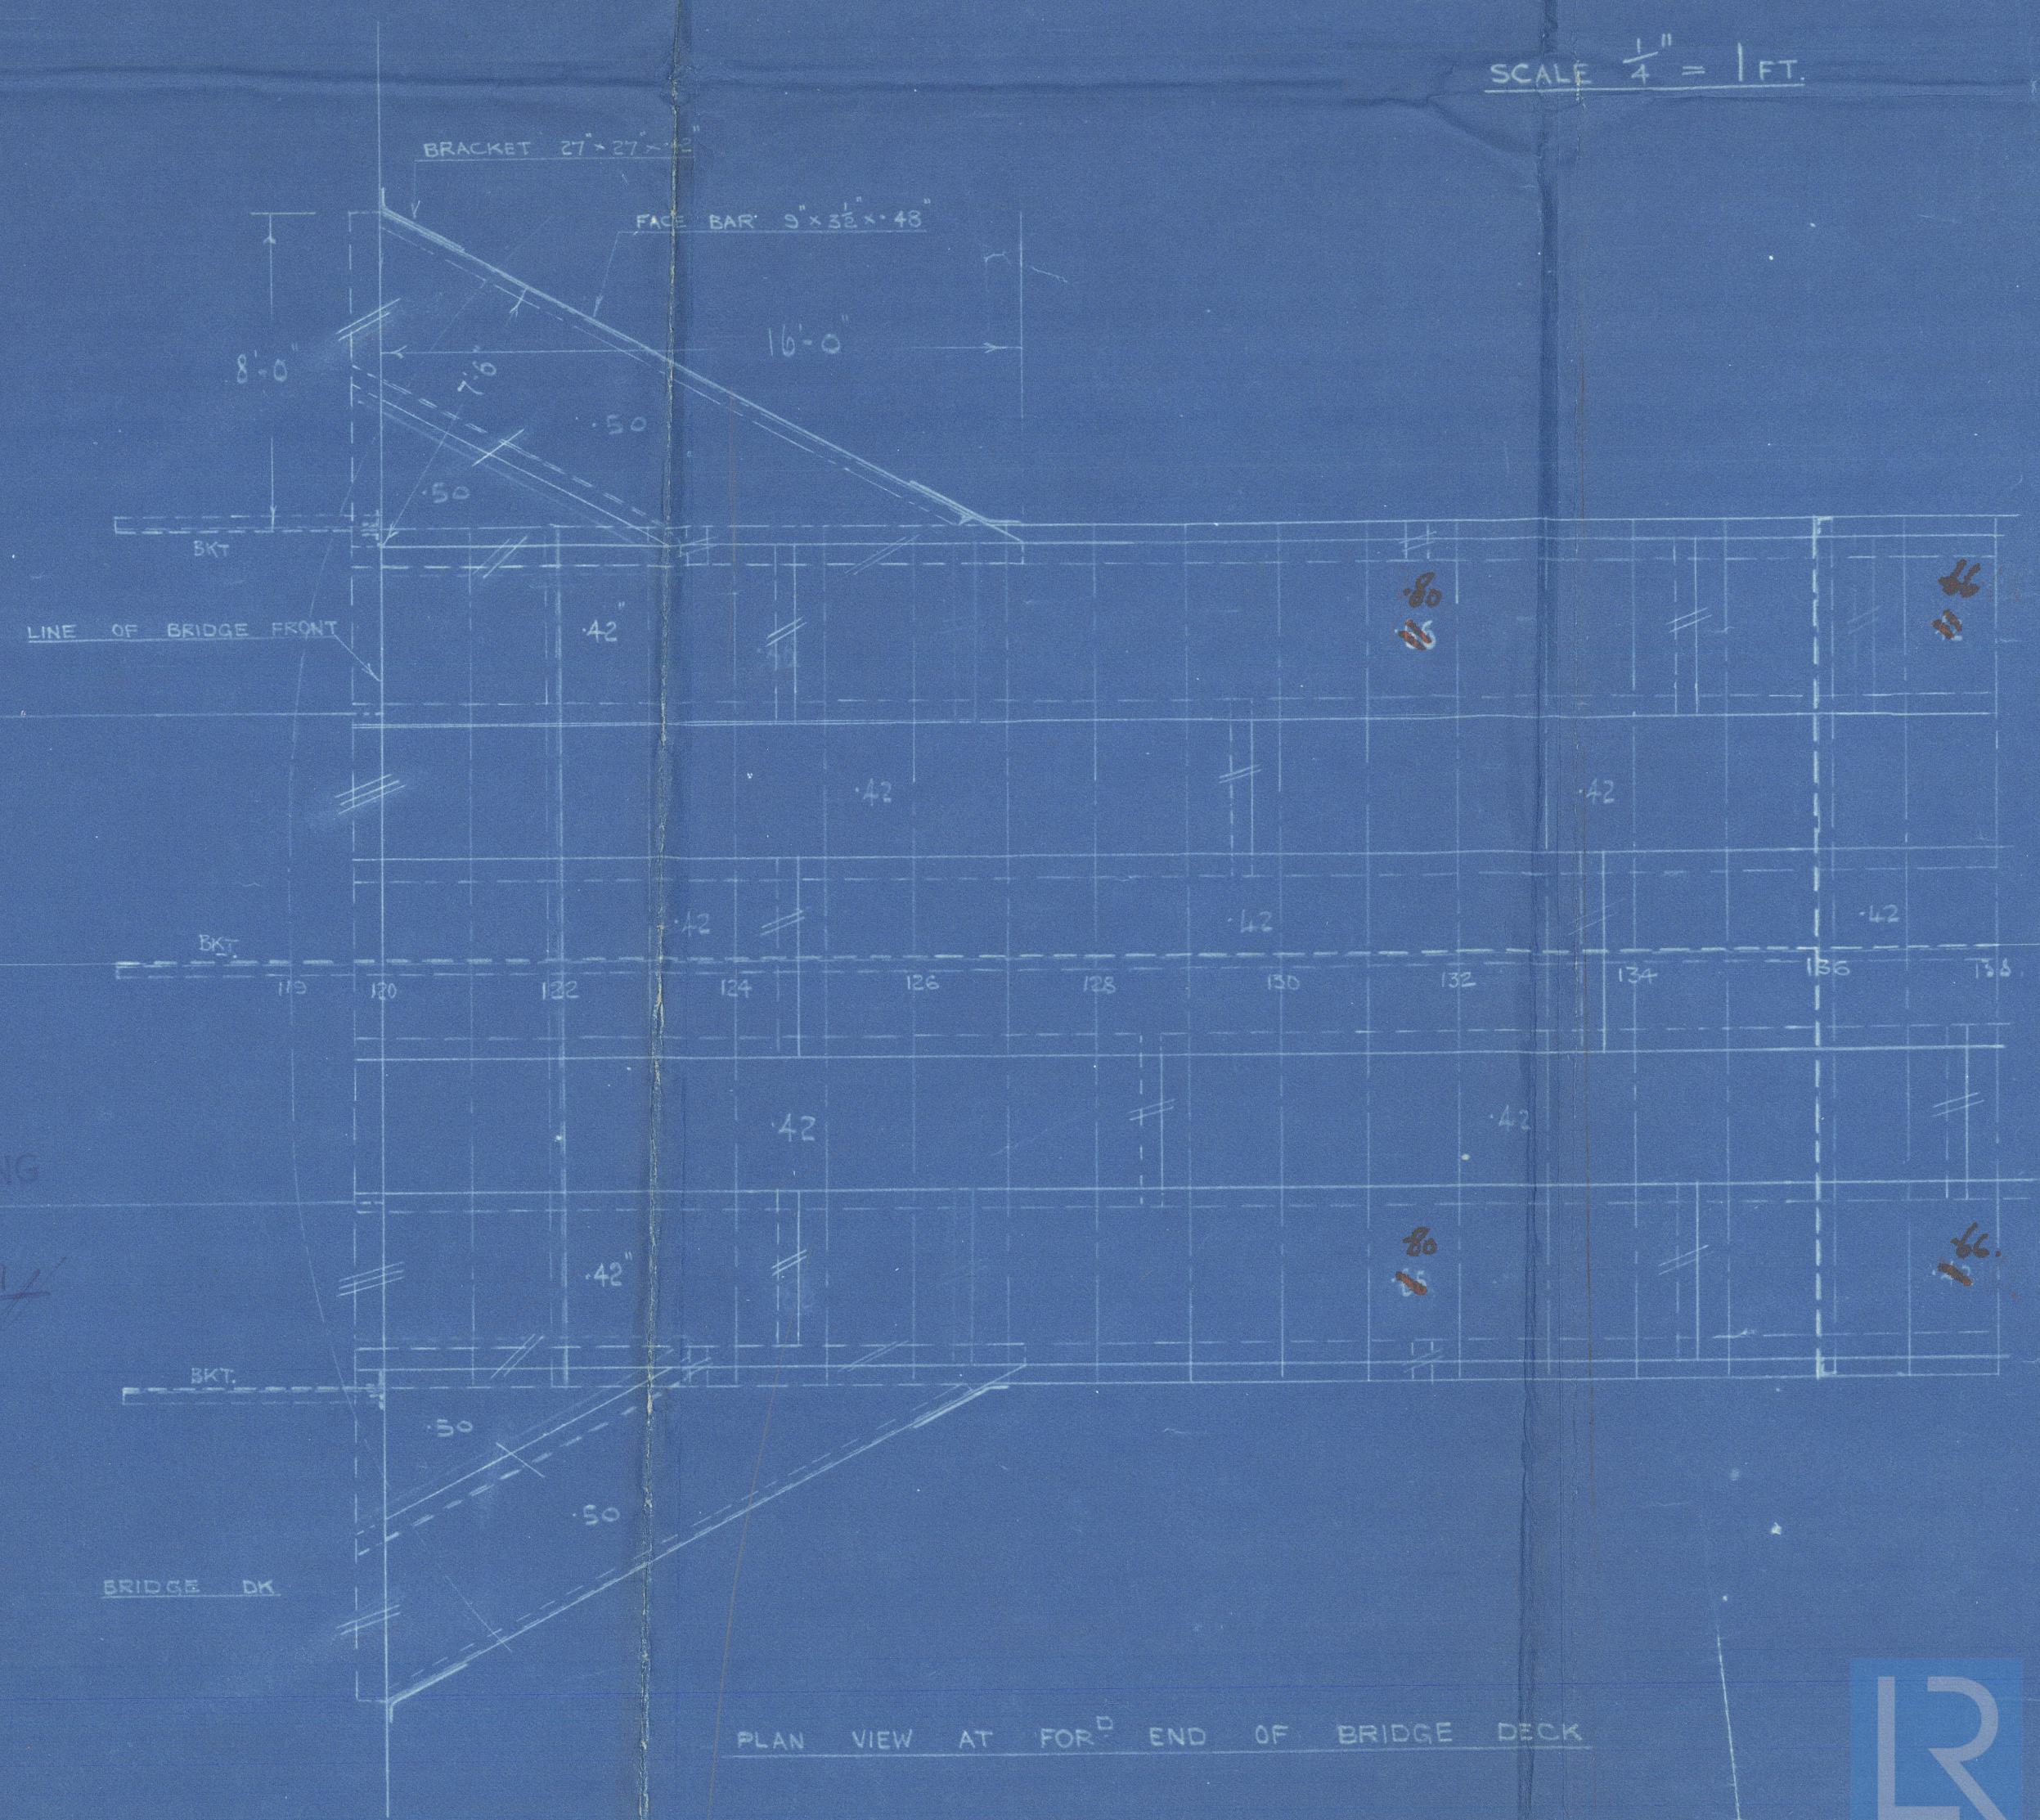

QUEEN LOUISE

ADDITIONAL
STIFFENING IN
WAY OF BRIDGE DK.

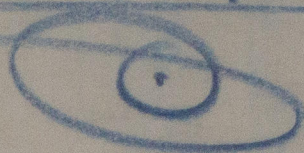

Gl. Pkt No. 41423.

RETAKE

RETAKE



© 2020

Lloyd's Register
Foundation

W632-0109