

YARD NOS 172-3.


GENERAL IRONWORK.

SCALE: 1/2" = 1 FOOT.

2/10/18


AFT END OF BOILER CASING.

LOOKING FOR?

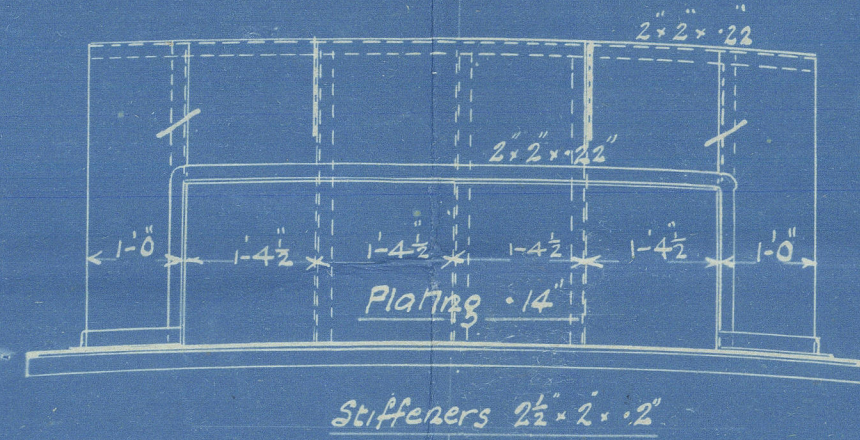


FOR? END OF BOILER CASING.

LOOKING AFT.

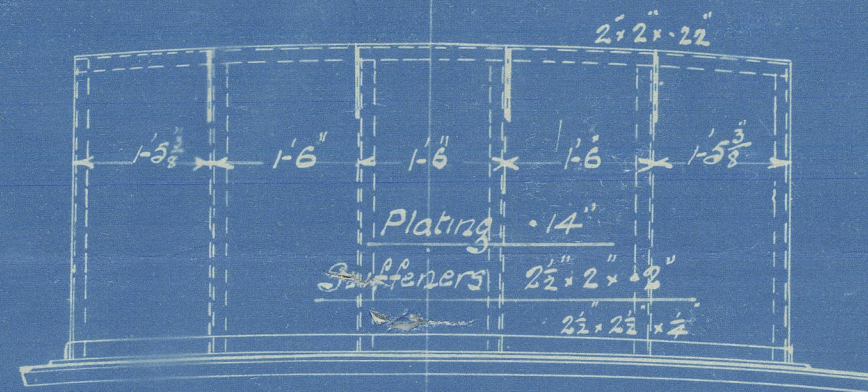


BUNKER SIDE PLATING.

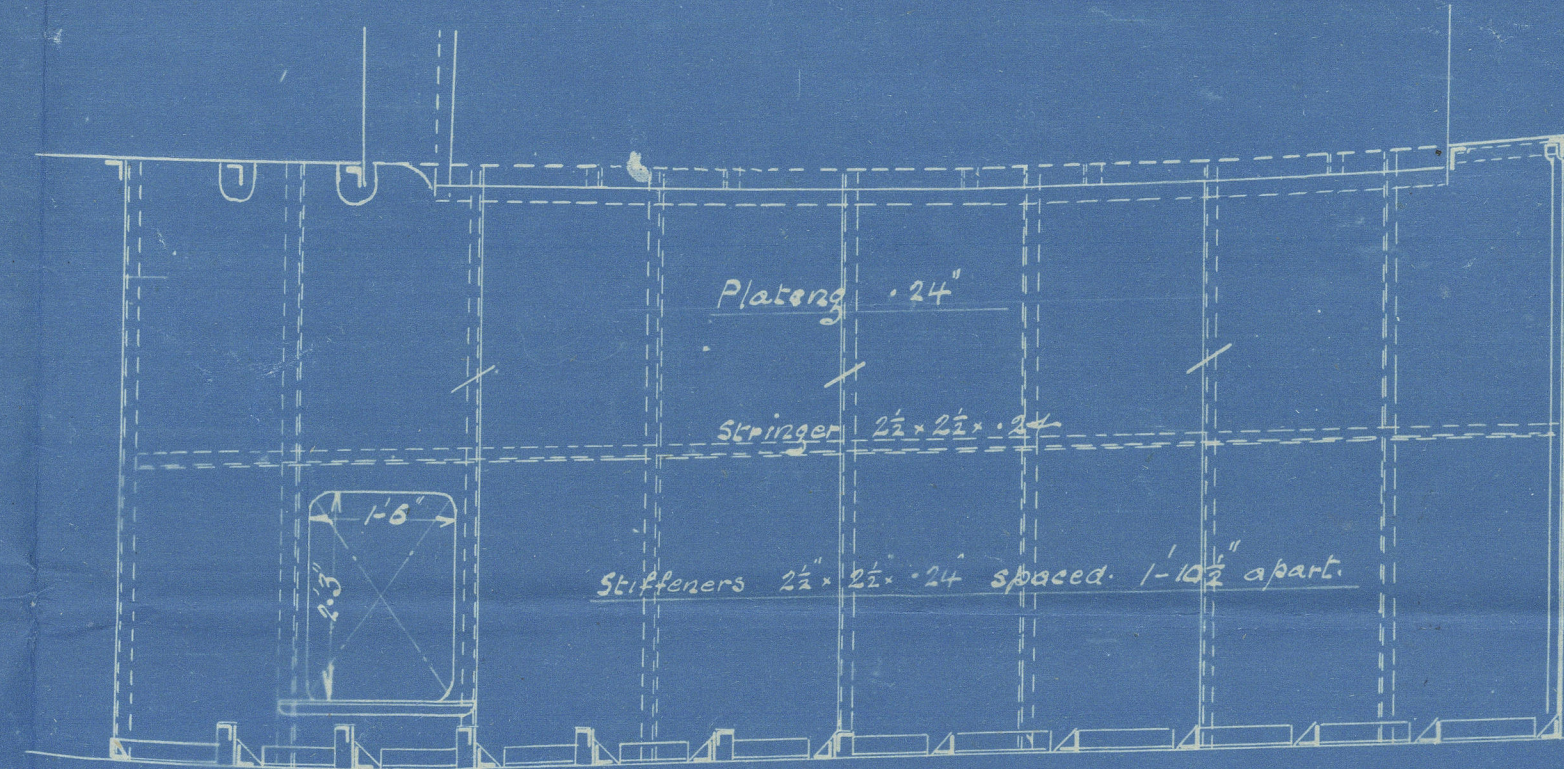


BUNKER END PLATING.

LOOKING AFT.

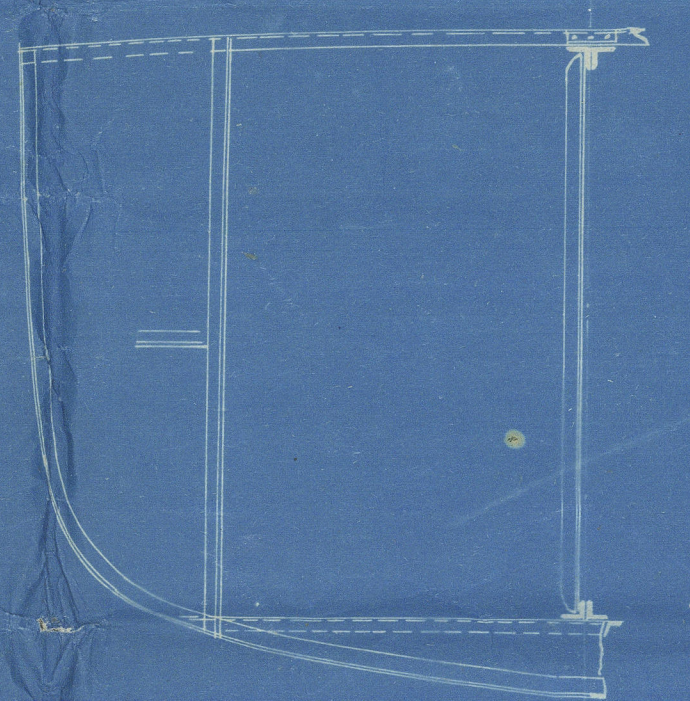


AFT END OF ENGINE CASING.

LOOKING FOR?

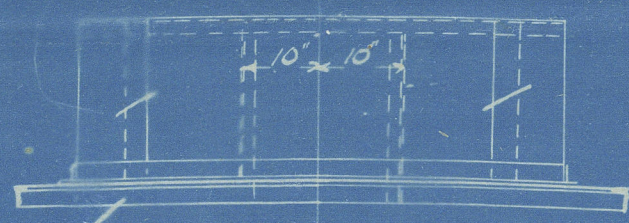


ENGINE AND BOILER CASING.

LOOKING TO PORT.

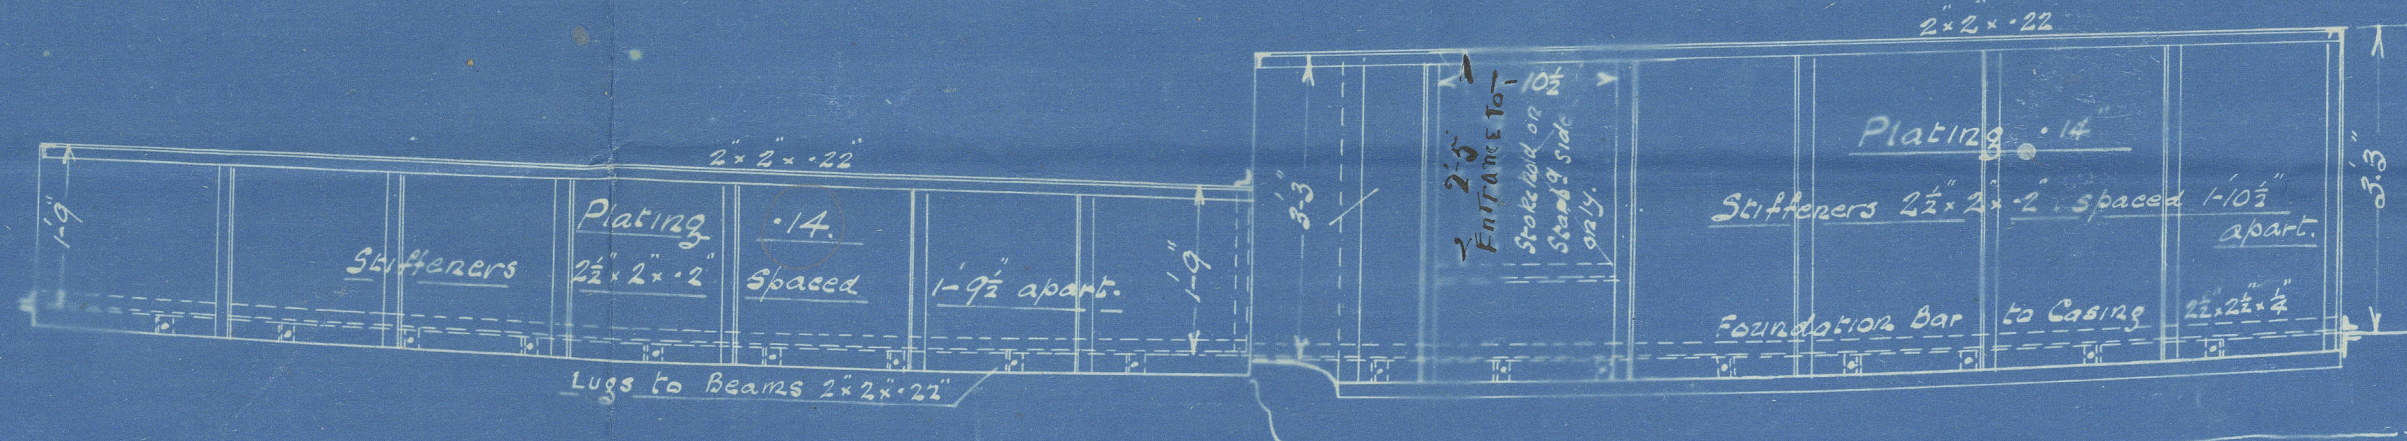

ELEVATION FROM CENTRE-LINE.


LOOKING TO PORT.

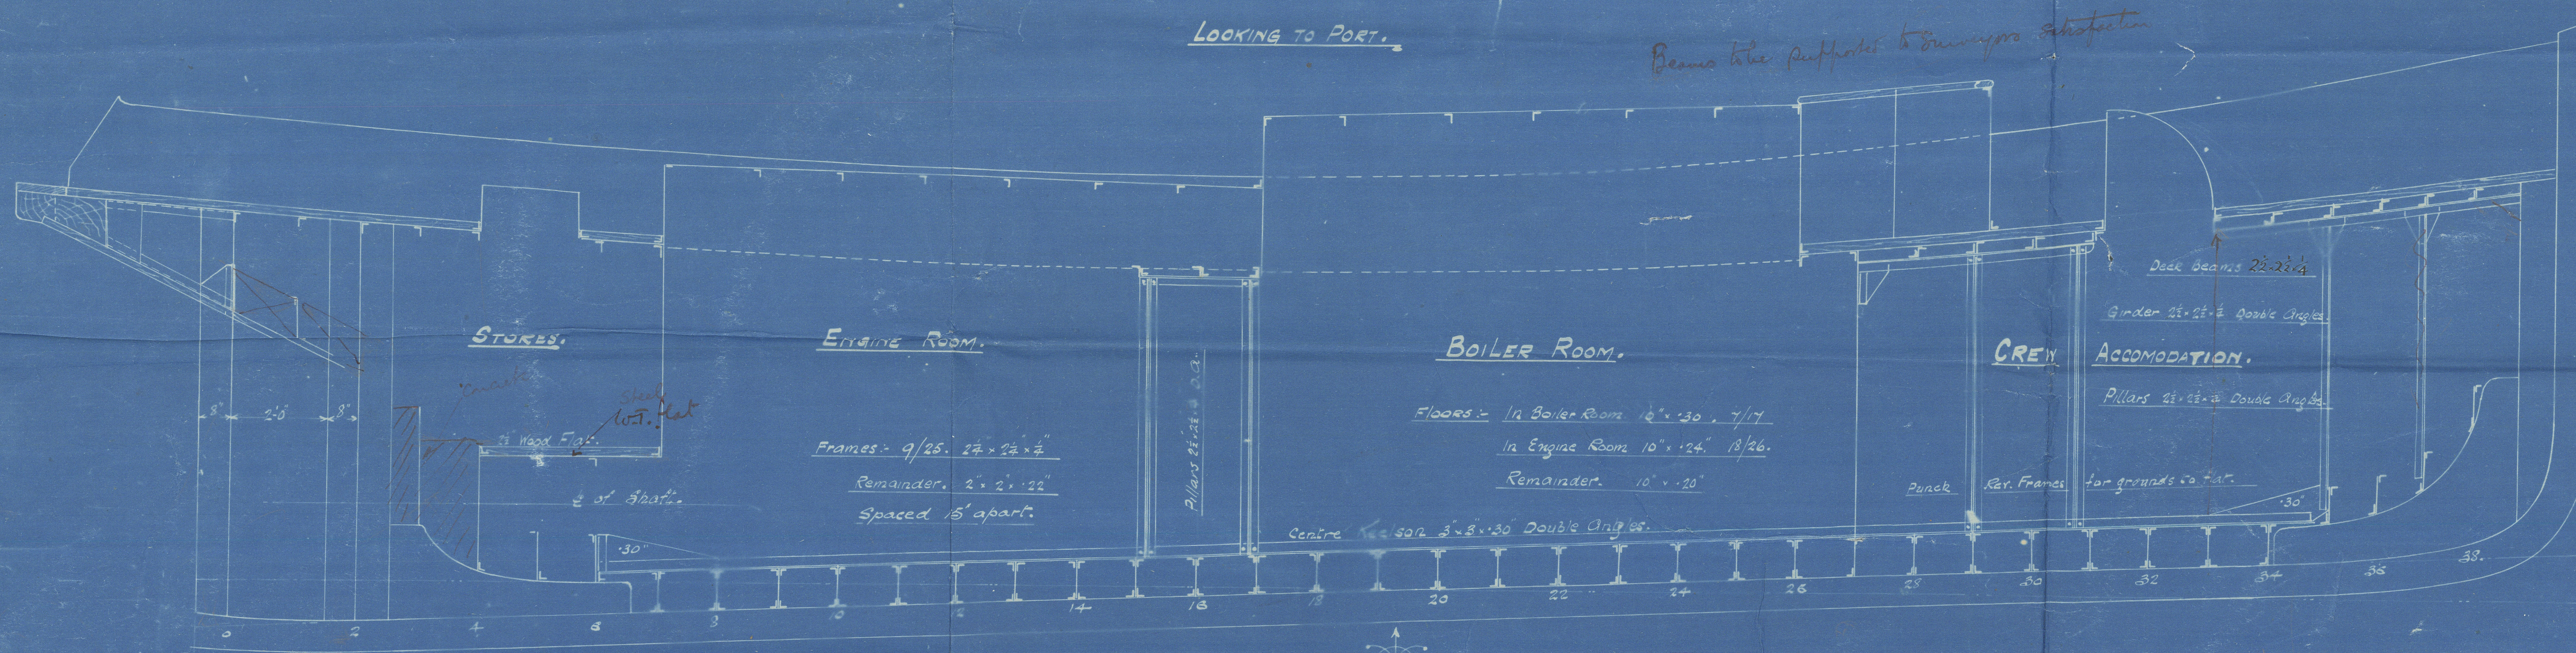

Beams like stiffeners to dimensions indicated

BULKHEAD FR. 27.


LOOKING FOR?

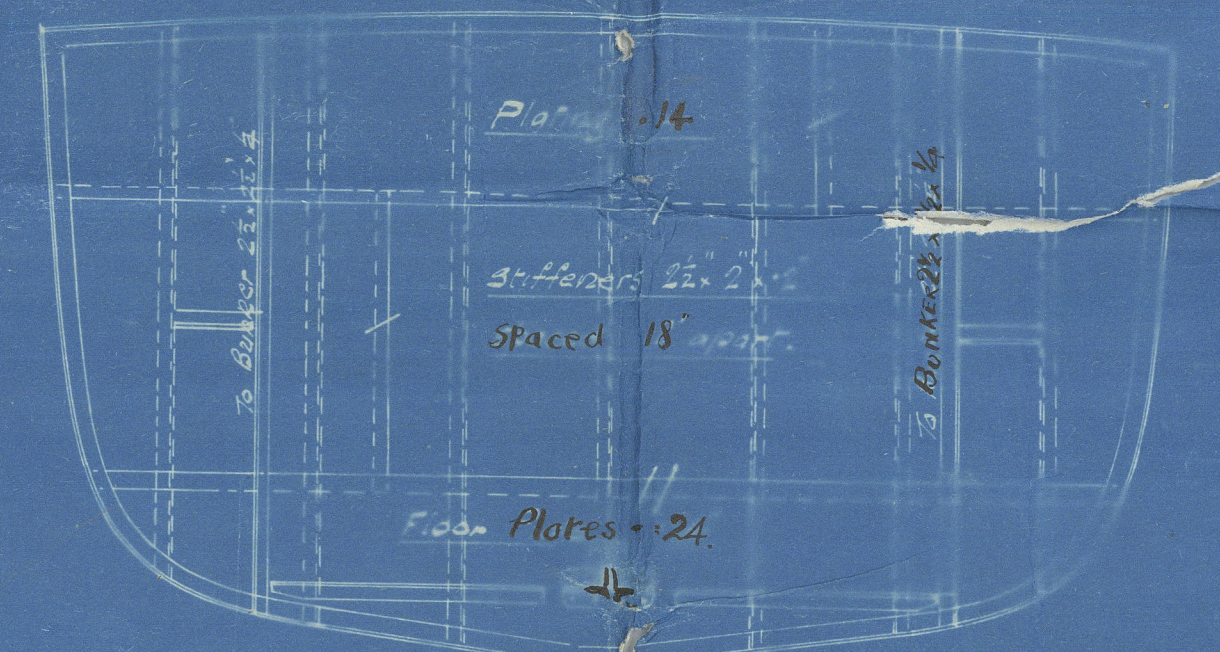

Brackets 9x2 at Heads
Sheet of Stiffeners


BULKHEAD FR. 7.

LOOKING AFT.

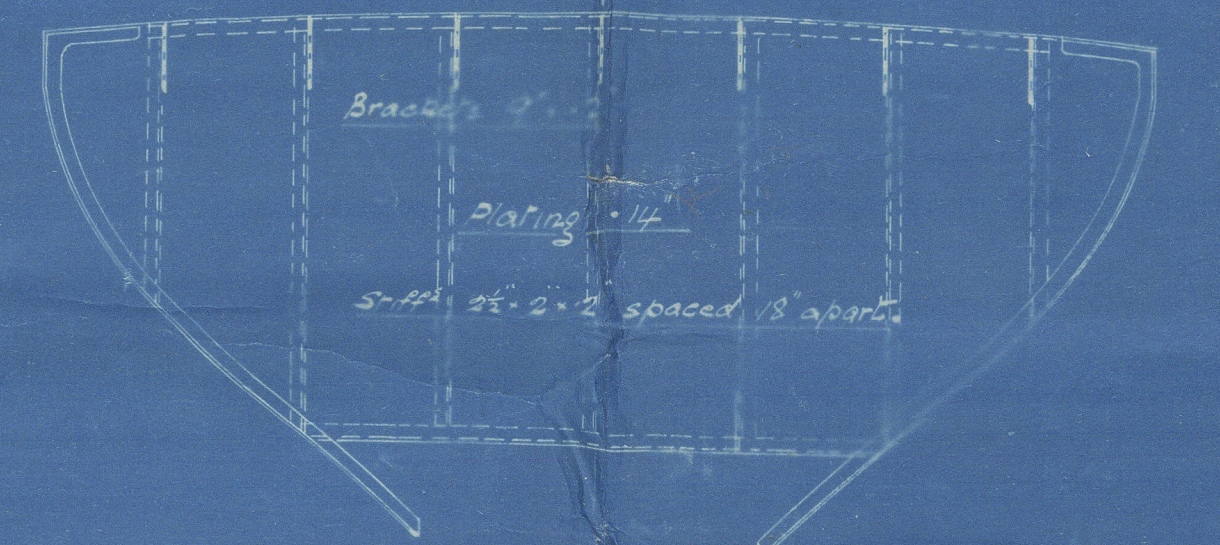


BULKHEAD FR. 4.

LOOKING AFT.

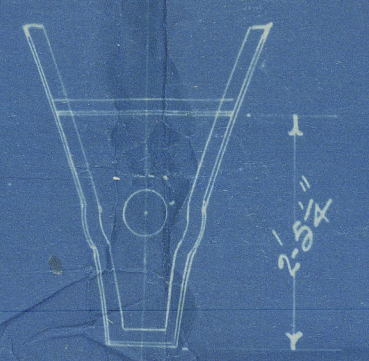

DECK AND CASING PLAN.

Configuration using
1/2" stiffeners to dimensions indicated

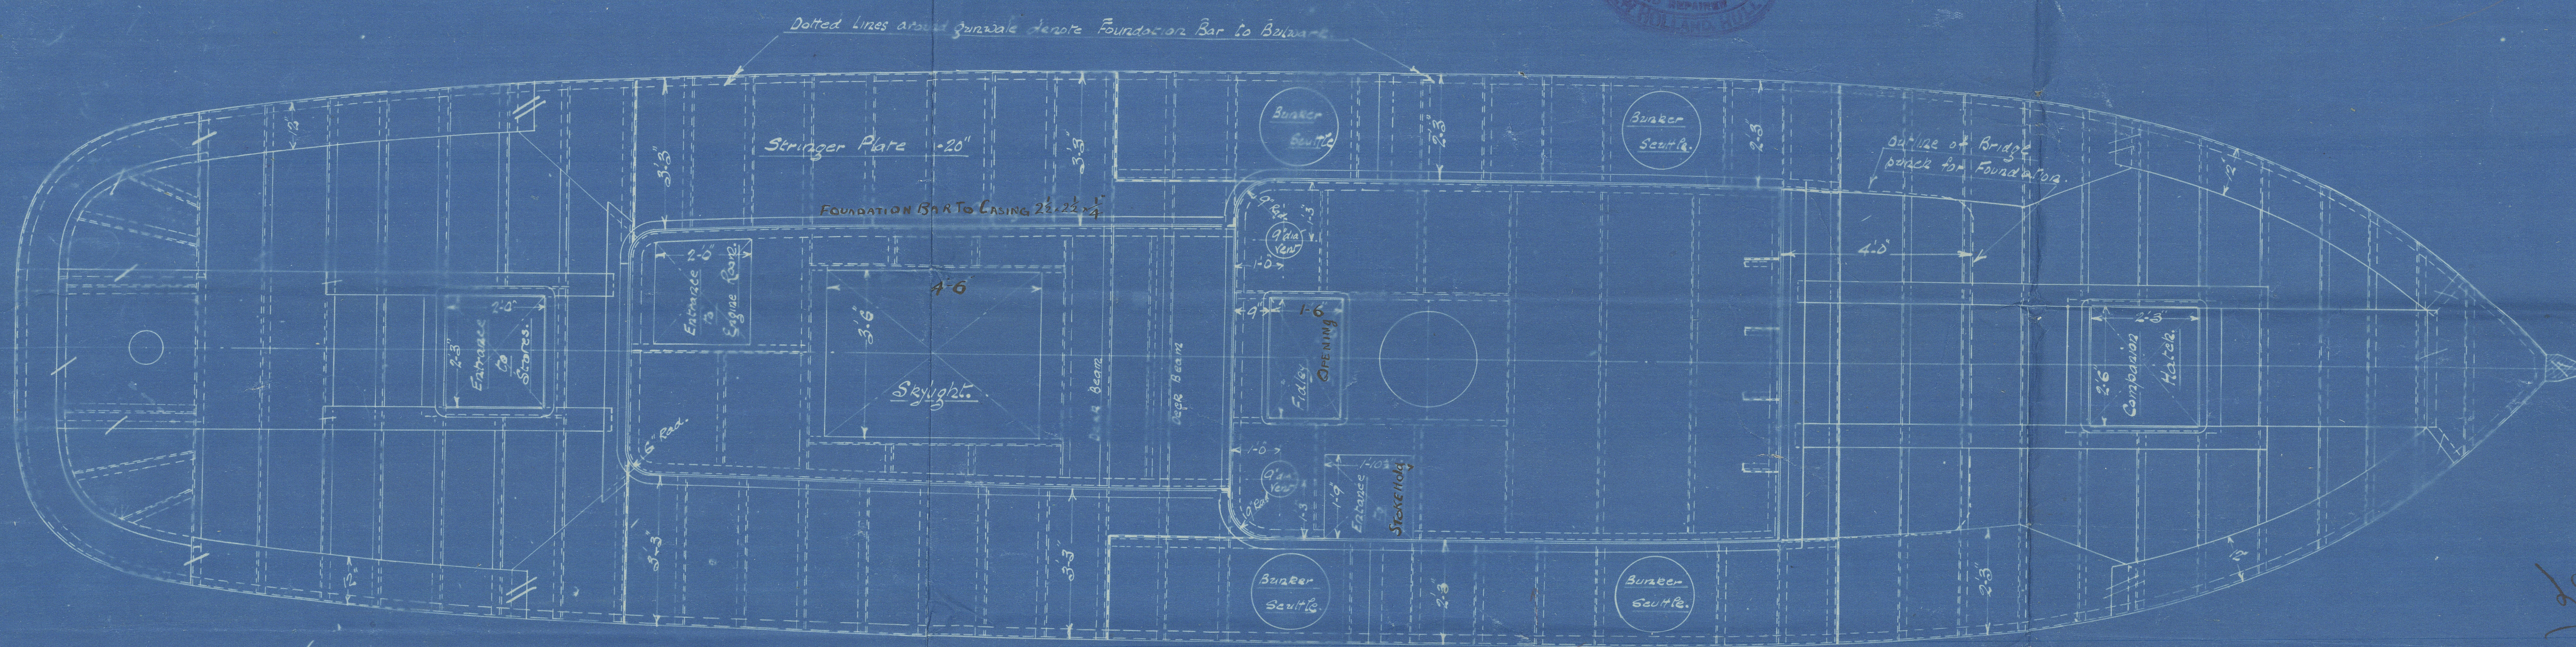

DRAWING NO 544.

Wood Lugs

No 172 + 173

172/3

Building at J Hunter & Son

Beverley

App'd Plan of
Ironwork

1/2y Jams Hull Rpt No 31635



© 2020

Lloyd's Register
Foundation