


WORKING PRESS. 130 LBS PER SQ IN

TEST PRESS 260 " " "

BOILER NO 3972


" " 3973

14/10/18


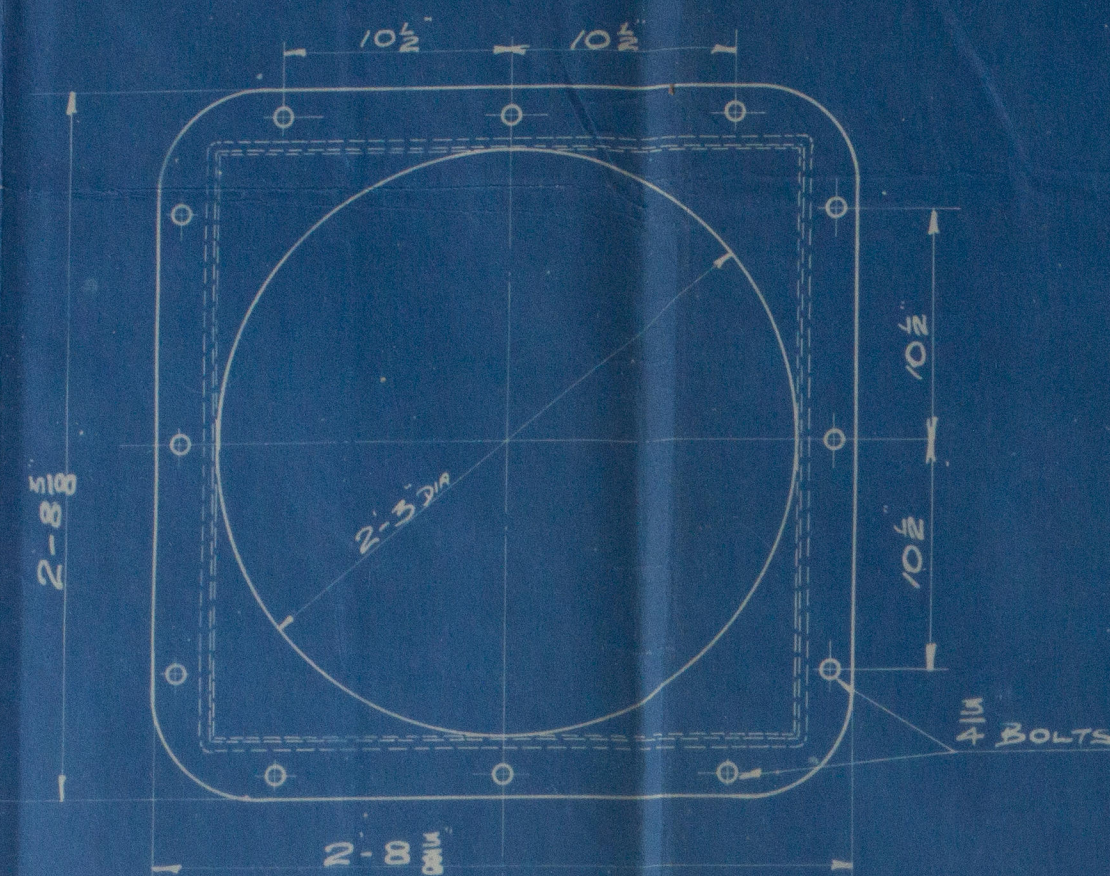


CHIMNEY 12-0 LONG 2-3 DIA  
1/8" PLATE

LONGITUDINAL SEAM OF SHELL

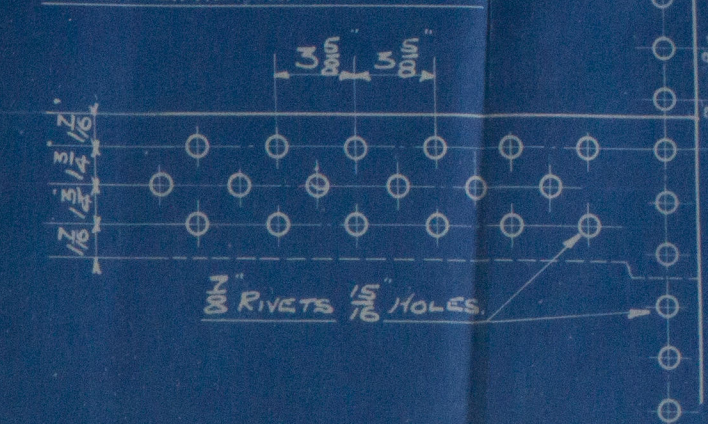

CIRCUMFERENTIAL SEAMS

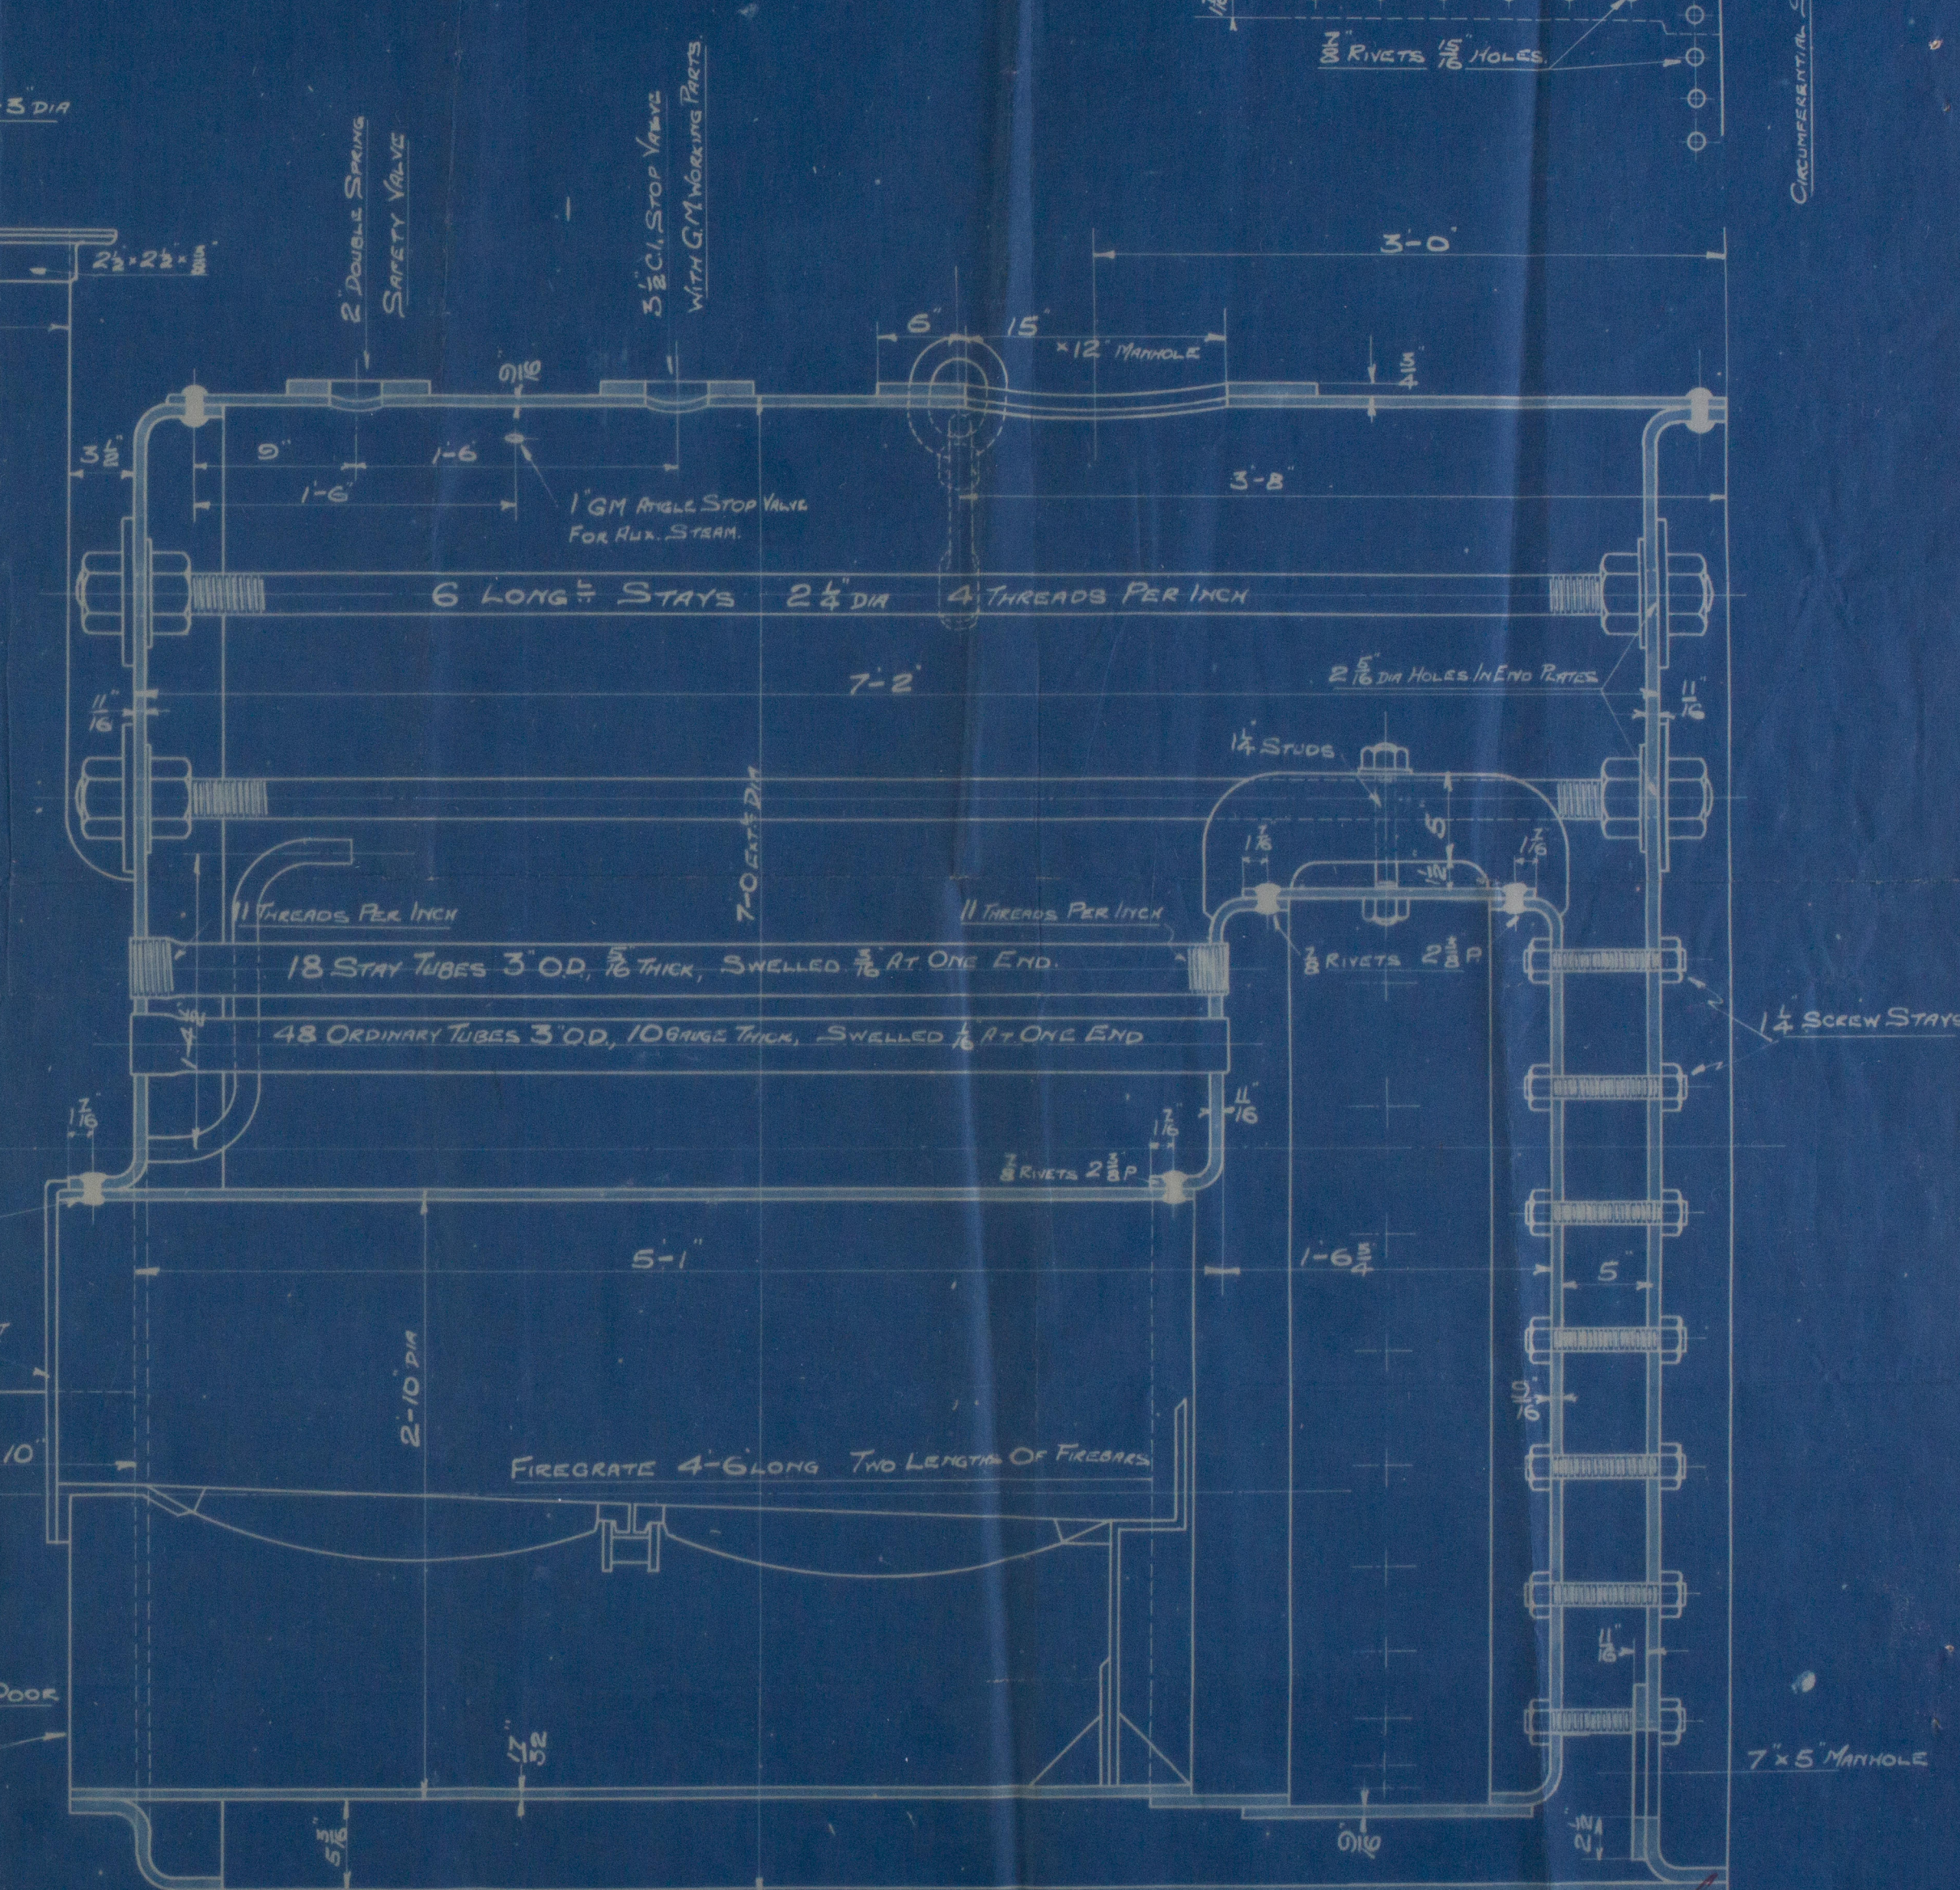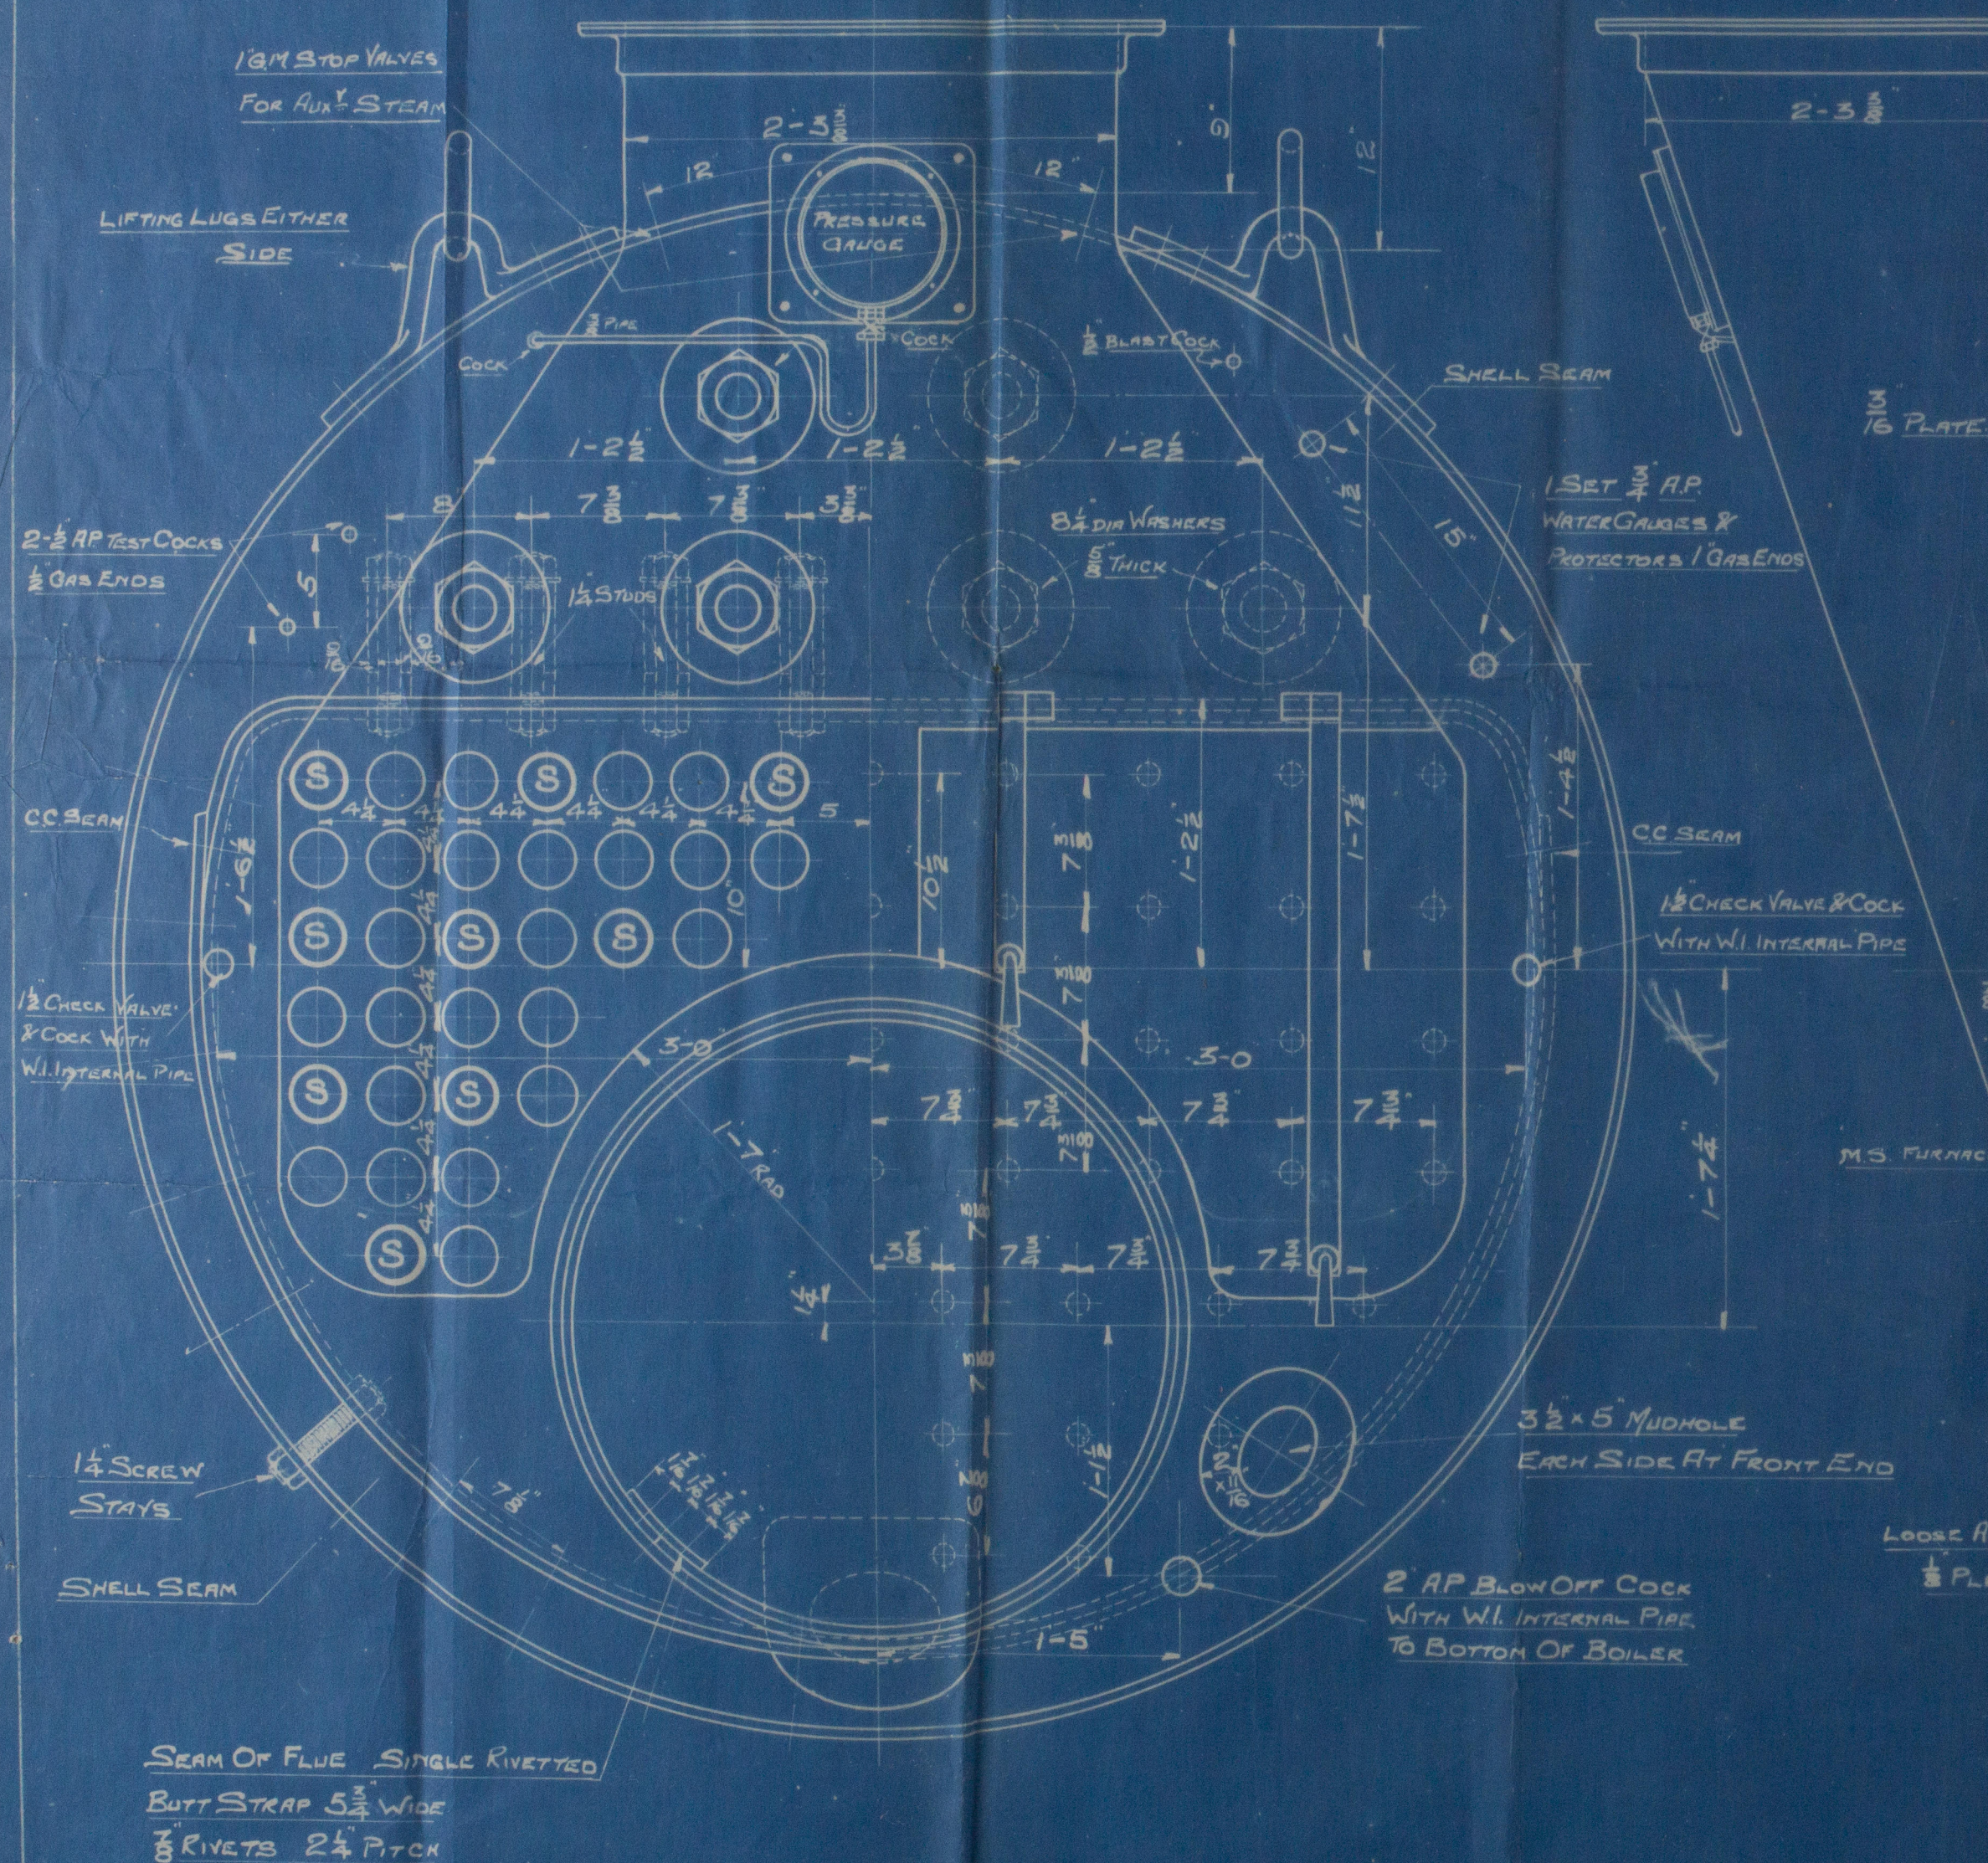

ORDER NO 18/201

TITLE 7-0" DIA MARINE TYPE BOILER

THE FARRAR BOILERWORKS LTD, NEWARK.

SCALE: 1 1/2" = 1 FOOT

DRAWN	TRACED	CHECKED	APPROVED
H.S. PARR	5-11-18		

DRG NO B 242



Messrs FARRAR & Co

Nº 3792 - 3793


130 lbs per. R"  
9372

Lloyds Test  
260 lbs  
4 P, 20 lbs  
Nº 415  
2.7.19. 19 FM

3793

Lloyds Test  
260 lbs  
4 P 130 lbs  
Nº 416  
8.7.19. PFM

Shf. Rpts 32344.

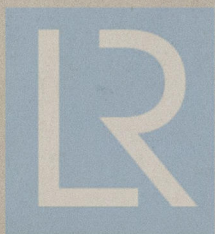

© 2020

Lloyd's Register  
Foundation

W632-0176