

21.10.03
 9.11.03
 14.11.03
 21.11.03
 28.11.03
 4.12.03
 19.12.03
 1.1.04
 6.1.04
 15.1.04
 20.1.04
 29.1.04
 13.4.04
 11.5.04

Midship Section. No 604 Twin Screw Steamer 425-0 + 49-9 1/2 Mld + 27-8 Mld.

Class 100 A.I. Lloyd's Three Decks

Scale 1/2 Inch = 1 Ft.

Materials.	Equipment.
1/2 Shell = 49.08	102.67 + 423.03 = 434.32
1/2 Breadth = 24.89	Shelter Pl. 1/2 = 54.29
Depth = 23.70	Creations 198 = 254.0
	423.03
	+ 168.1 = 514.01 = Equip. No.
	Proportions 355
102.67 = 1st No.	Breadth to Length 8.49.
7.00	Depth to Length 14.74.
95.67 + 423.03 = 404.71 = 2nd No.	



C.I.X.
 16/10/03

MID. SECTION
 16/10/03
 100 21

27-10-03
 1894
 16/10/03
 1894

W633-0161

MID. SECTION

In James Lang & Sons

Shelton St. 755 423






No 604

Bermudian

X 1 D

10/10/10

Is Bermudean
Sld. F. E. No. 22062

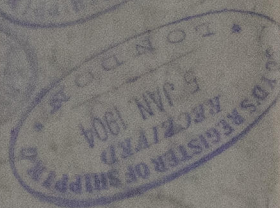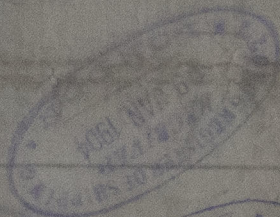 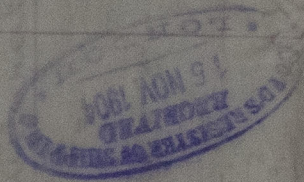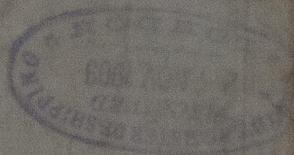

© 2020

Lloyd's Register
Foundation