

TRACING Nº 5346

BOILERS      10FF RIGHT  
                    10FF LEFT

Memoranda

Total 2525.65 Sq. ft.

To pass "Lloyd's" survey



422.

W. DOXFORD & SONS. LD

AFTER. MAIN. BOILERS.



2 OFF 180 LBS.

No 2900  
LLOYDS TEST  
360 LBS.  
20-2-11 W.P.

*Bohème*

Sld. Rpt. 24840

(DUPLICATE OF BLRS (AFT) 416.)

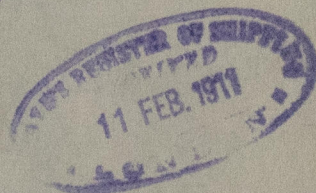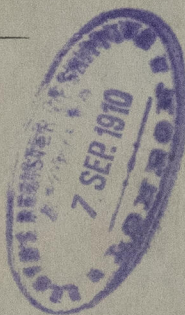

RETAIN

© 2020

W633-0253's Register