

BUILT BY THE MONMOUTH SHIPBUILDING CO. LTD CHEPSTOW


Apt. 20236

S.S. "CONCORDIA"
(ex "WARIDYLL")

Plan of

Midship Section

RETAIN

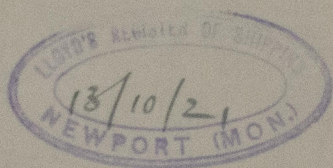

RETAIN

W634-0161



© 2020

Lloyd's Register
Foundation