

# MIDSHIP SECTION

Ss N<sup>o</sup> 366

371

369

DIMENSIONS AS PER RULES

LENGTH 339.08  
BREADTH 46.30  
DEPTH 28.27

CLASS 100 A.L. 3 DECK RULE

JOHN READHEAD & SONS,


Engineers, Boiler Makers,  
Iron & Steel Shipbuilders,  
SOUTH SHIELDS.

BRIDGE DECK

See amended Plan 9/4/03

373

14.2.02  
27.2.02  
10.3.02  
24.10.02  
12.1.03  
9.4.03 (1/373)

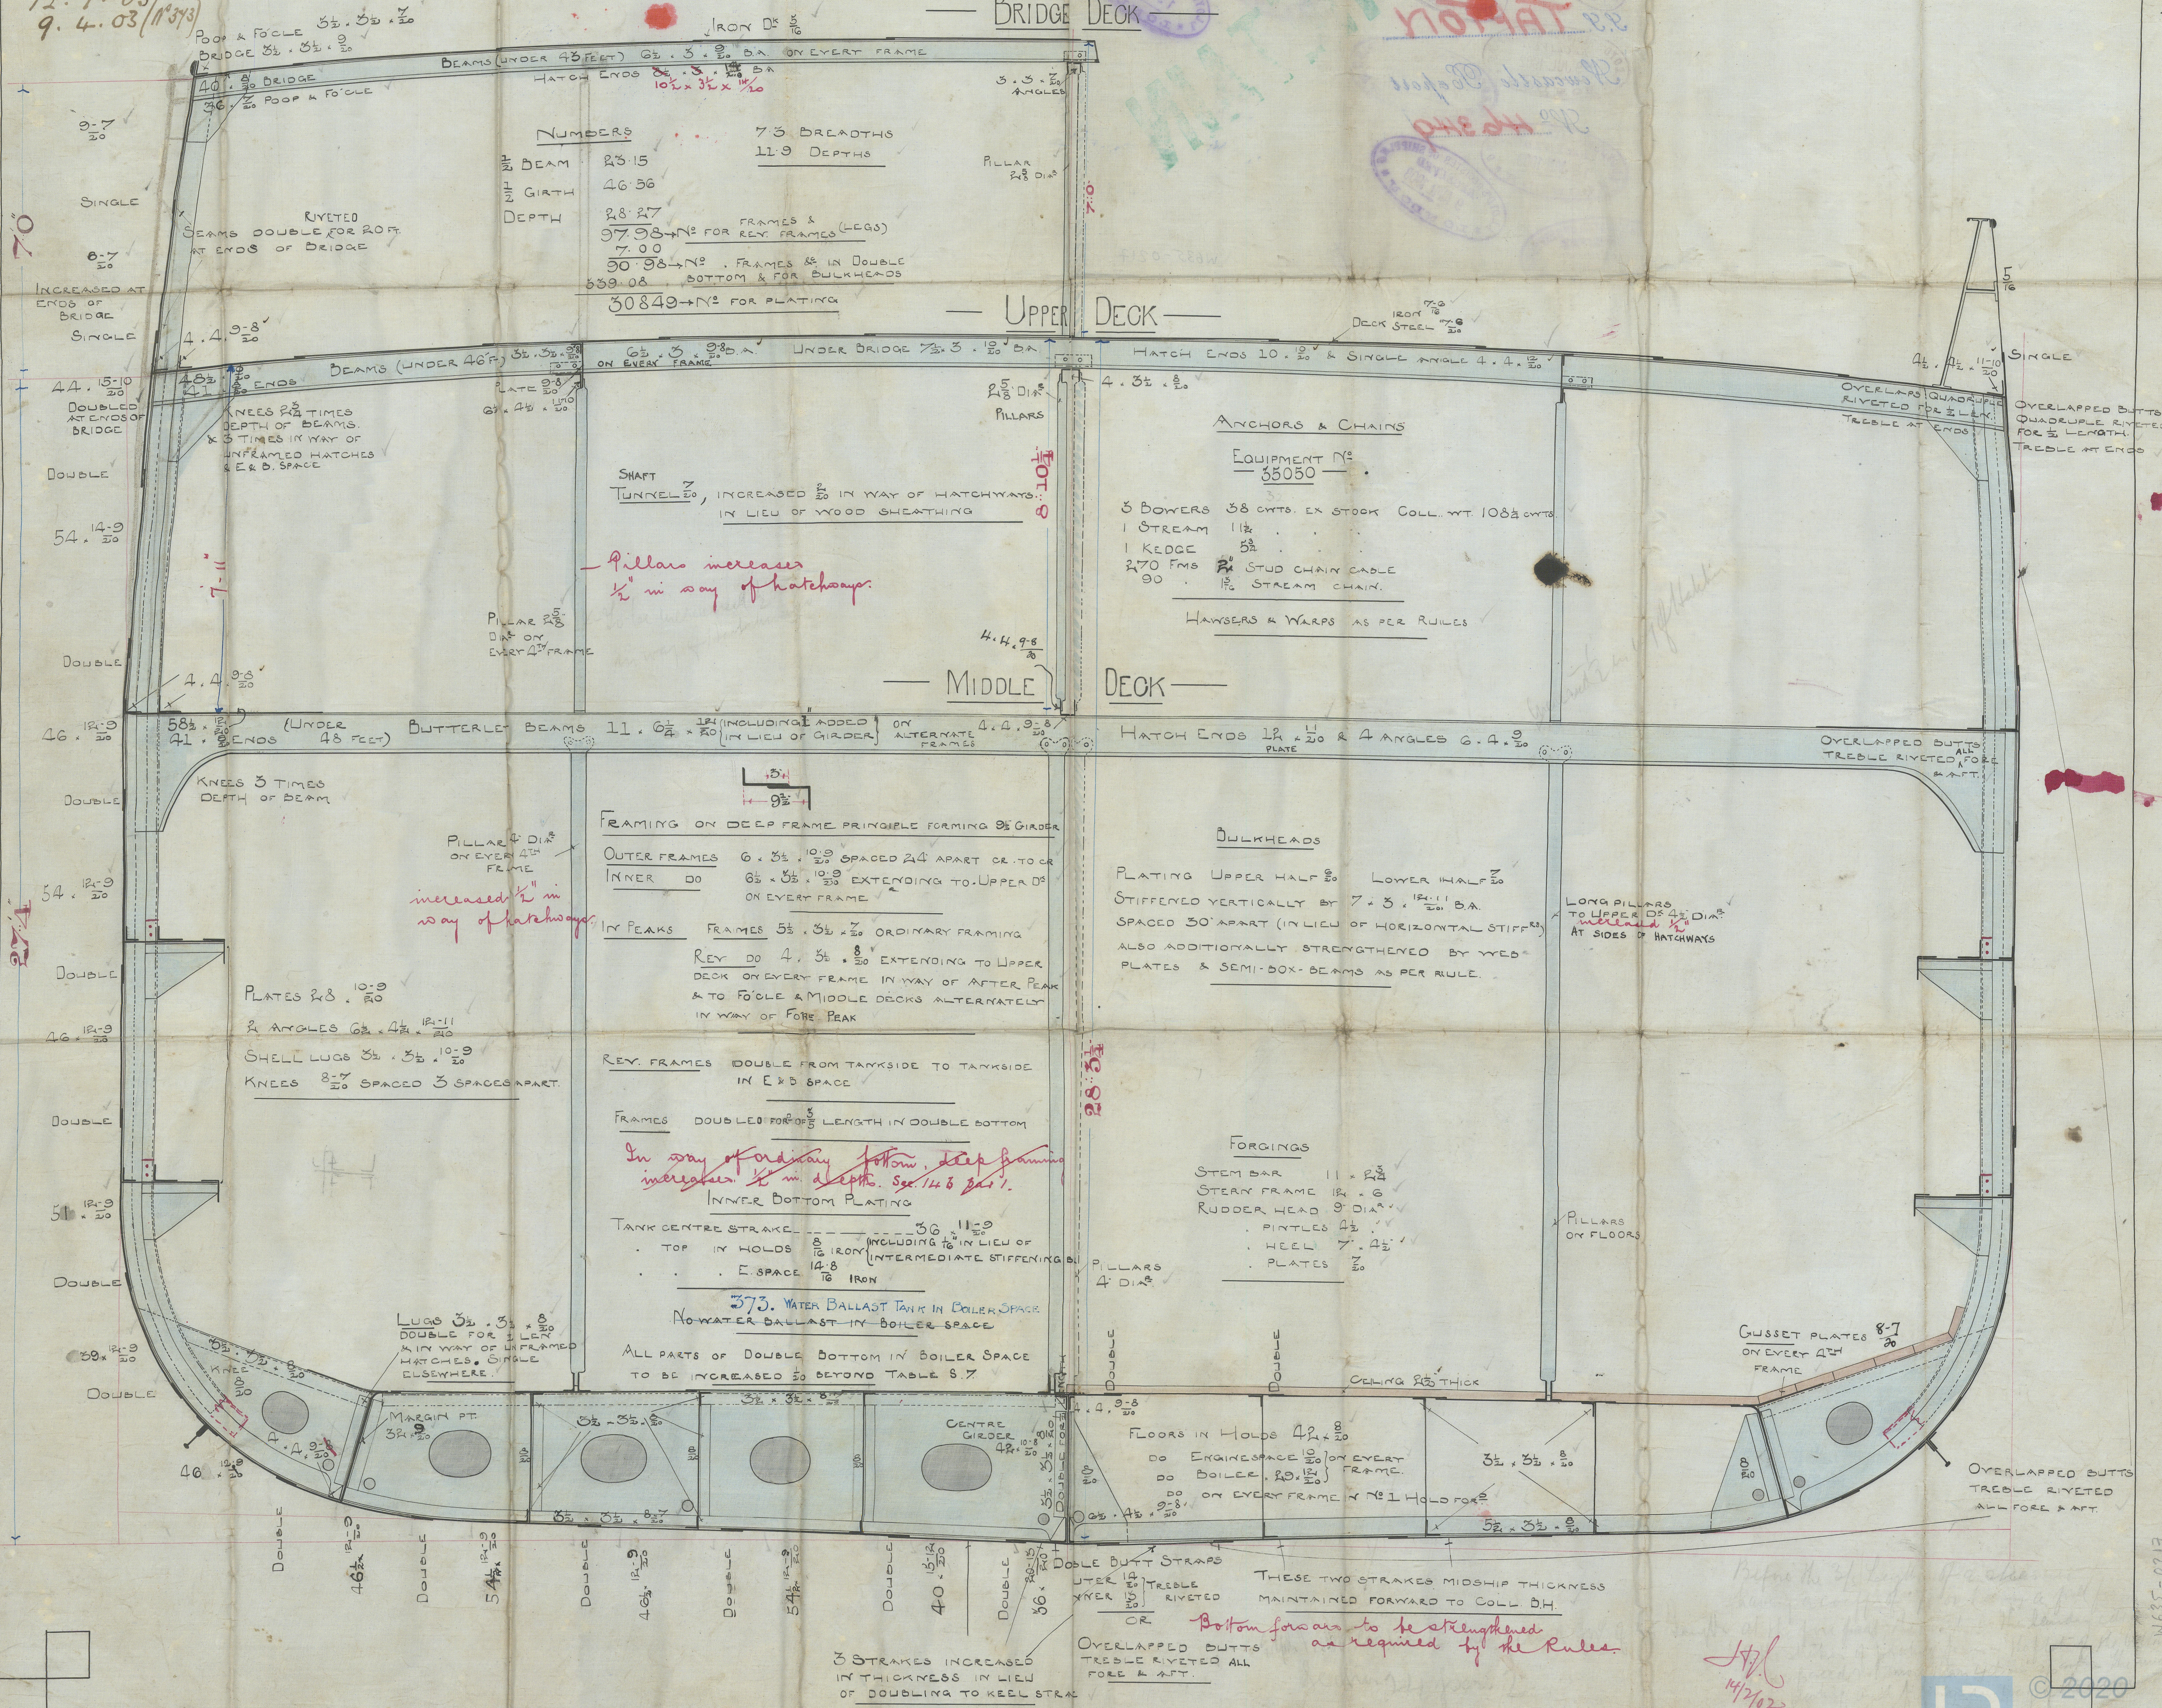

Pillars increase  
1/2" in way of hatchways

increased 1/2" in  
way of hatchways

In way of ordinary bottom, deep framing  
increased 1/2" in depth. See 14.6.02

Bottom for as to be strengthened  
as required by the Rules

14/1/02  
27/1/02



John Readhead & Sons

N<sup>o</sup> 371 ~~369~~ ~~370~~

Midship Section

38. Rule

also N<sup>o</sup> 373 - TAPTON.

N<sup>o</sup> 371 "NENTMOOR"

Newcastle Report

H<sup>o</sup> 818

J. J. TAPTON

Newcastle Report

N<sup>o</sup> H<sup>o</sup> 349



© 2020

Lloyd's Register  
Foundation

W635-0217