



17.10.06
12.11.06

PROFILE AND DECK PLAN

S S N° 397

SCALE 1/4" = ONE FOOT

DIMENSIONS:- LEN 125'0" x 22'6" x DEPTH MOULDED 13'0"

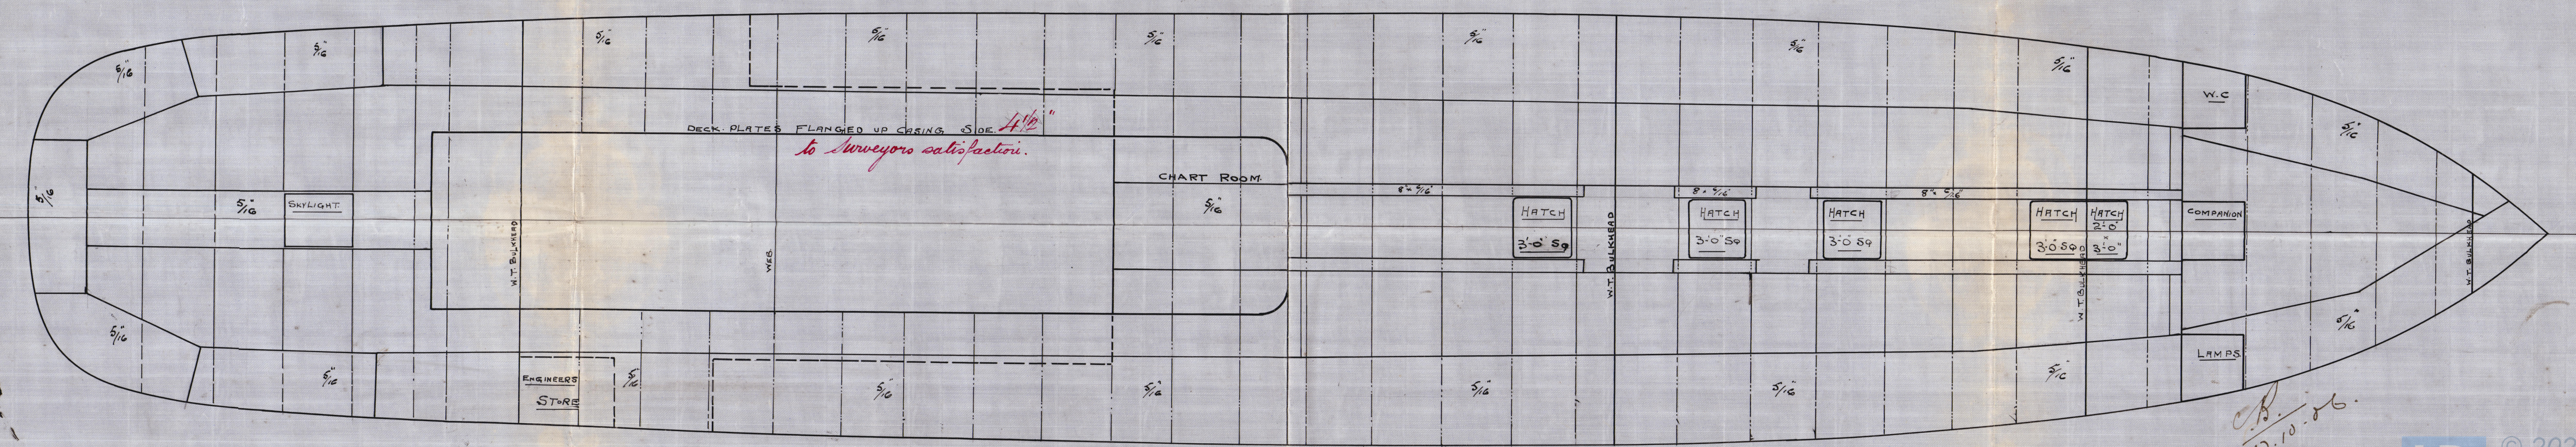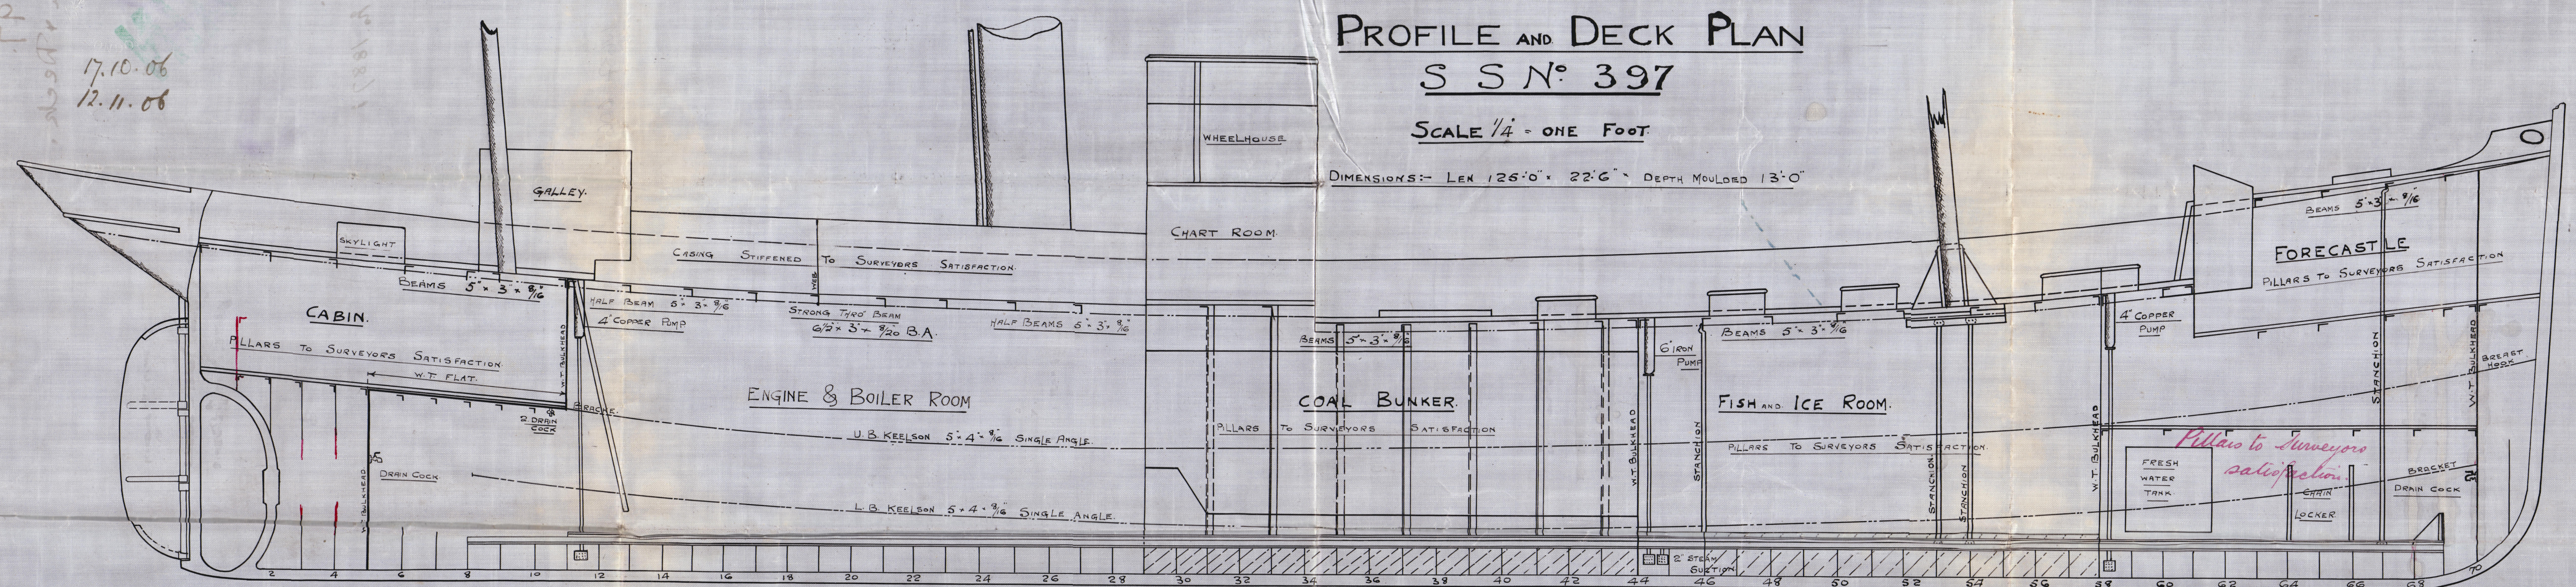

17.10.06

Cochrane & Sons
N^o. 397.

Profile & Deck.

of Ruby
Hull Report No. 18871



© 2020

Lloyd's Register
Foundation

W637-0062