


T. A. W. 2-11-00

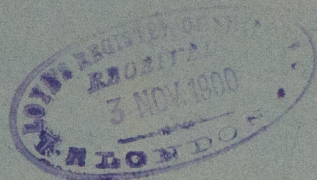



In 1976

J. T. Ettringham  
S. Shields  
W. P. 120

1 MW  
2.11.0

RETAIN

N <sup>o</sup> 6026
Lloyd's List
240 lbs
13-3-01. <u>A&amp;F</u>

~~P. S. Pioneer~~


~~Newcastle Report~~

~~N<sup>o</sup> 41967~~

~~Hull - 14036~~

N637-0231



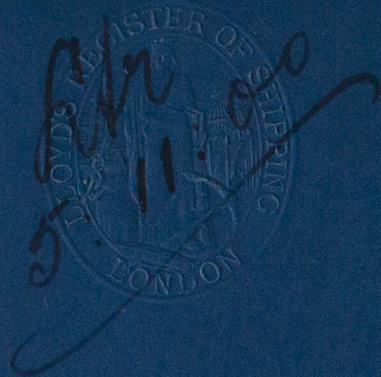

No. 1276 Multitubular Boiler for



W. Pressure 120 lb per sq inch

Scale 1" = 1 foot

Tested to Lloyds Requirements

Material

all plates, rivets, large  
stays of steel, tubes, small  
stays, uptake of iron

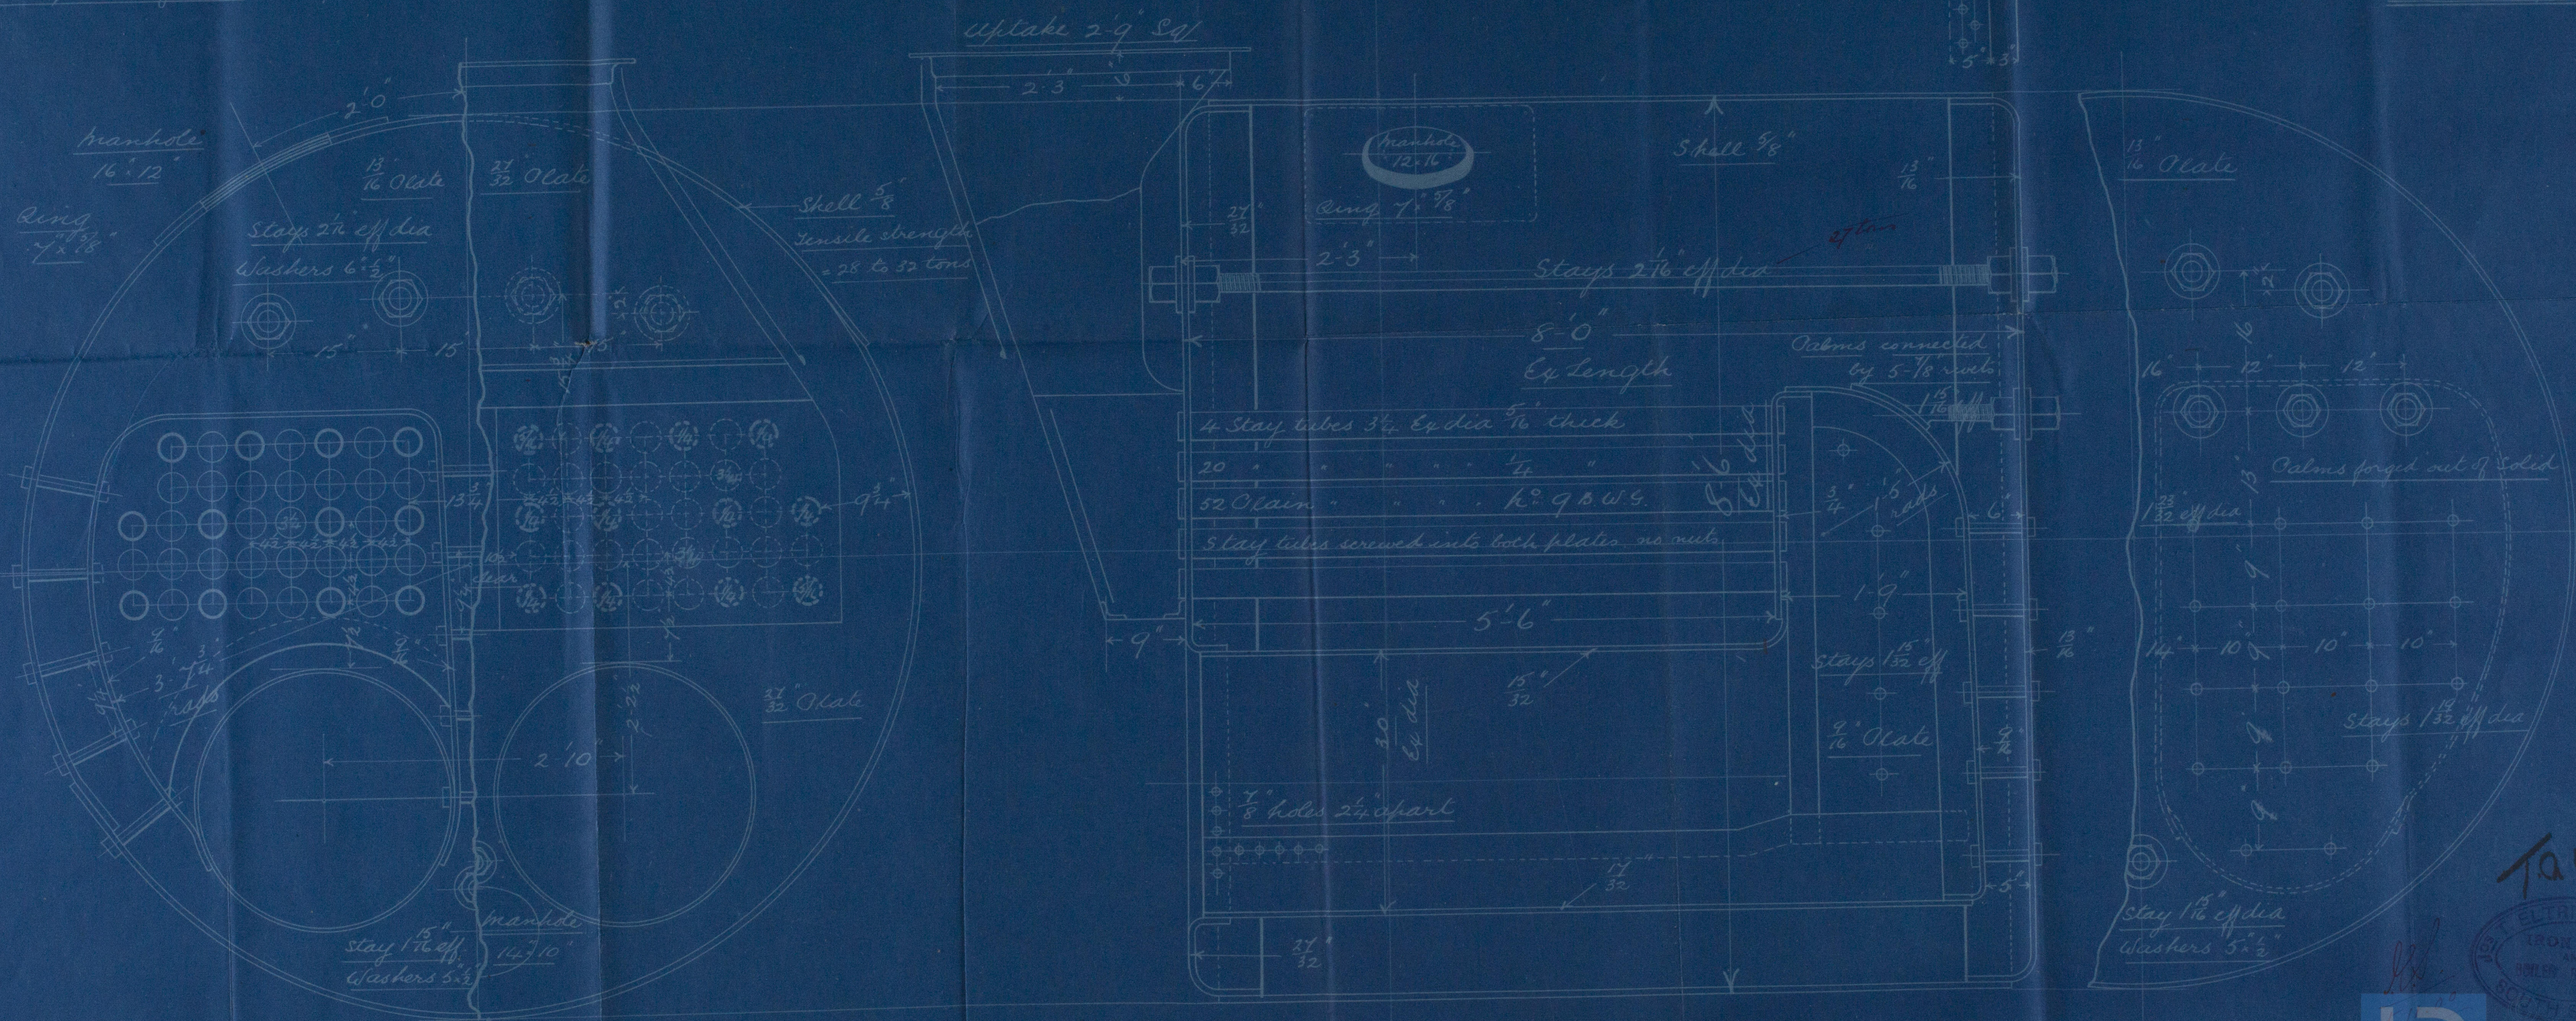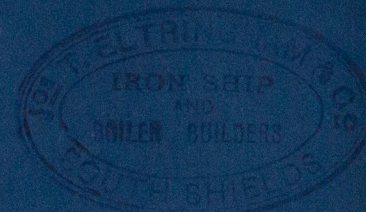

Shell Rivetting

1" holes 4 1/8" apart

1" holes  
3 3/4" apart

Heating Surface



Tubes 355 sq ft

Furnaces 58 "

Tube Plates 57 "

6 chambers 23 "

Total = 493 sq ft

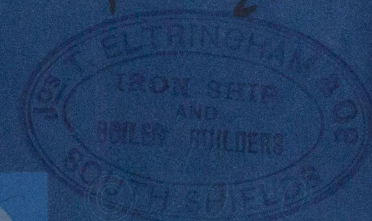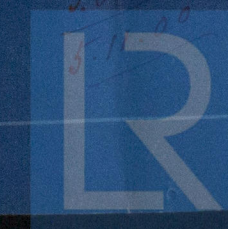

W. 639 - 0251  
Foundation