


10.2.13
17.3.13
21.4.13
29.5.13
28.10.13

RULE EQUIPMENT

NUMERICAL	21900
POOP	33
BRIDGE	75
DECK	37
2 BOWER ANCHORS	45 CTS EACH
1 " "	38
1 " "	12
1 " "	52
270 FATHOMS	19 1/2 TUD CHAIN
90 " "	4 1/4 STEEL KNUZE
100 " "	4
2.40	7 HANGERS
1.40	6

Nº 586 SS
MIDSHIP SECTION
300 x 45 x 28 ML
1/2" = 1 ft.
TO CLASS 100 ALL LLOYDS

NUMERICAL	45
BREADTH	28
DEPTH	73
LENGTH	300
PROPORTIONS	21900

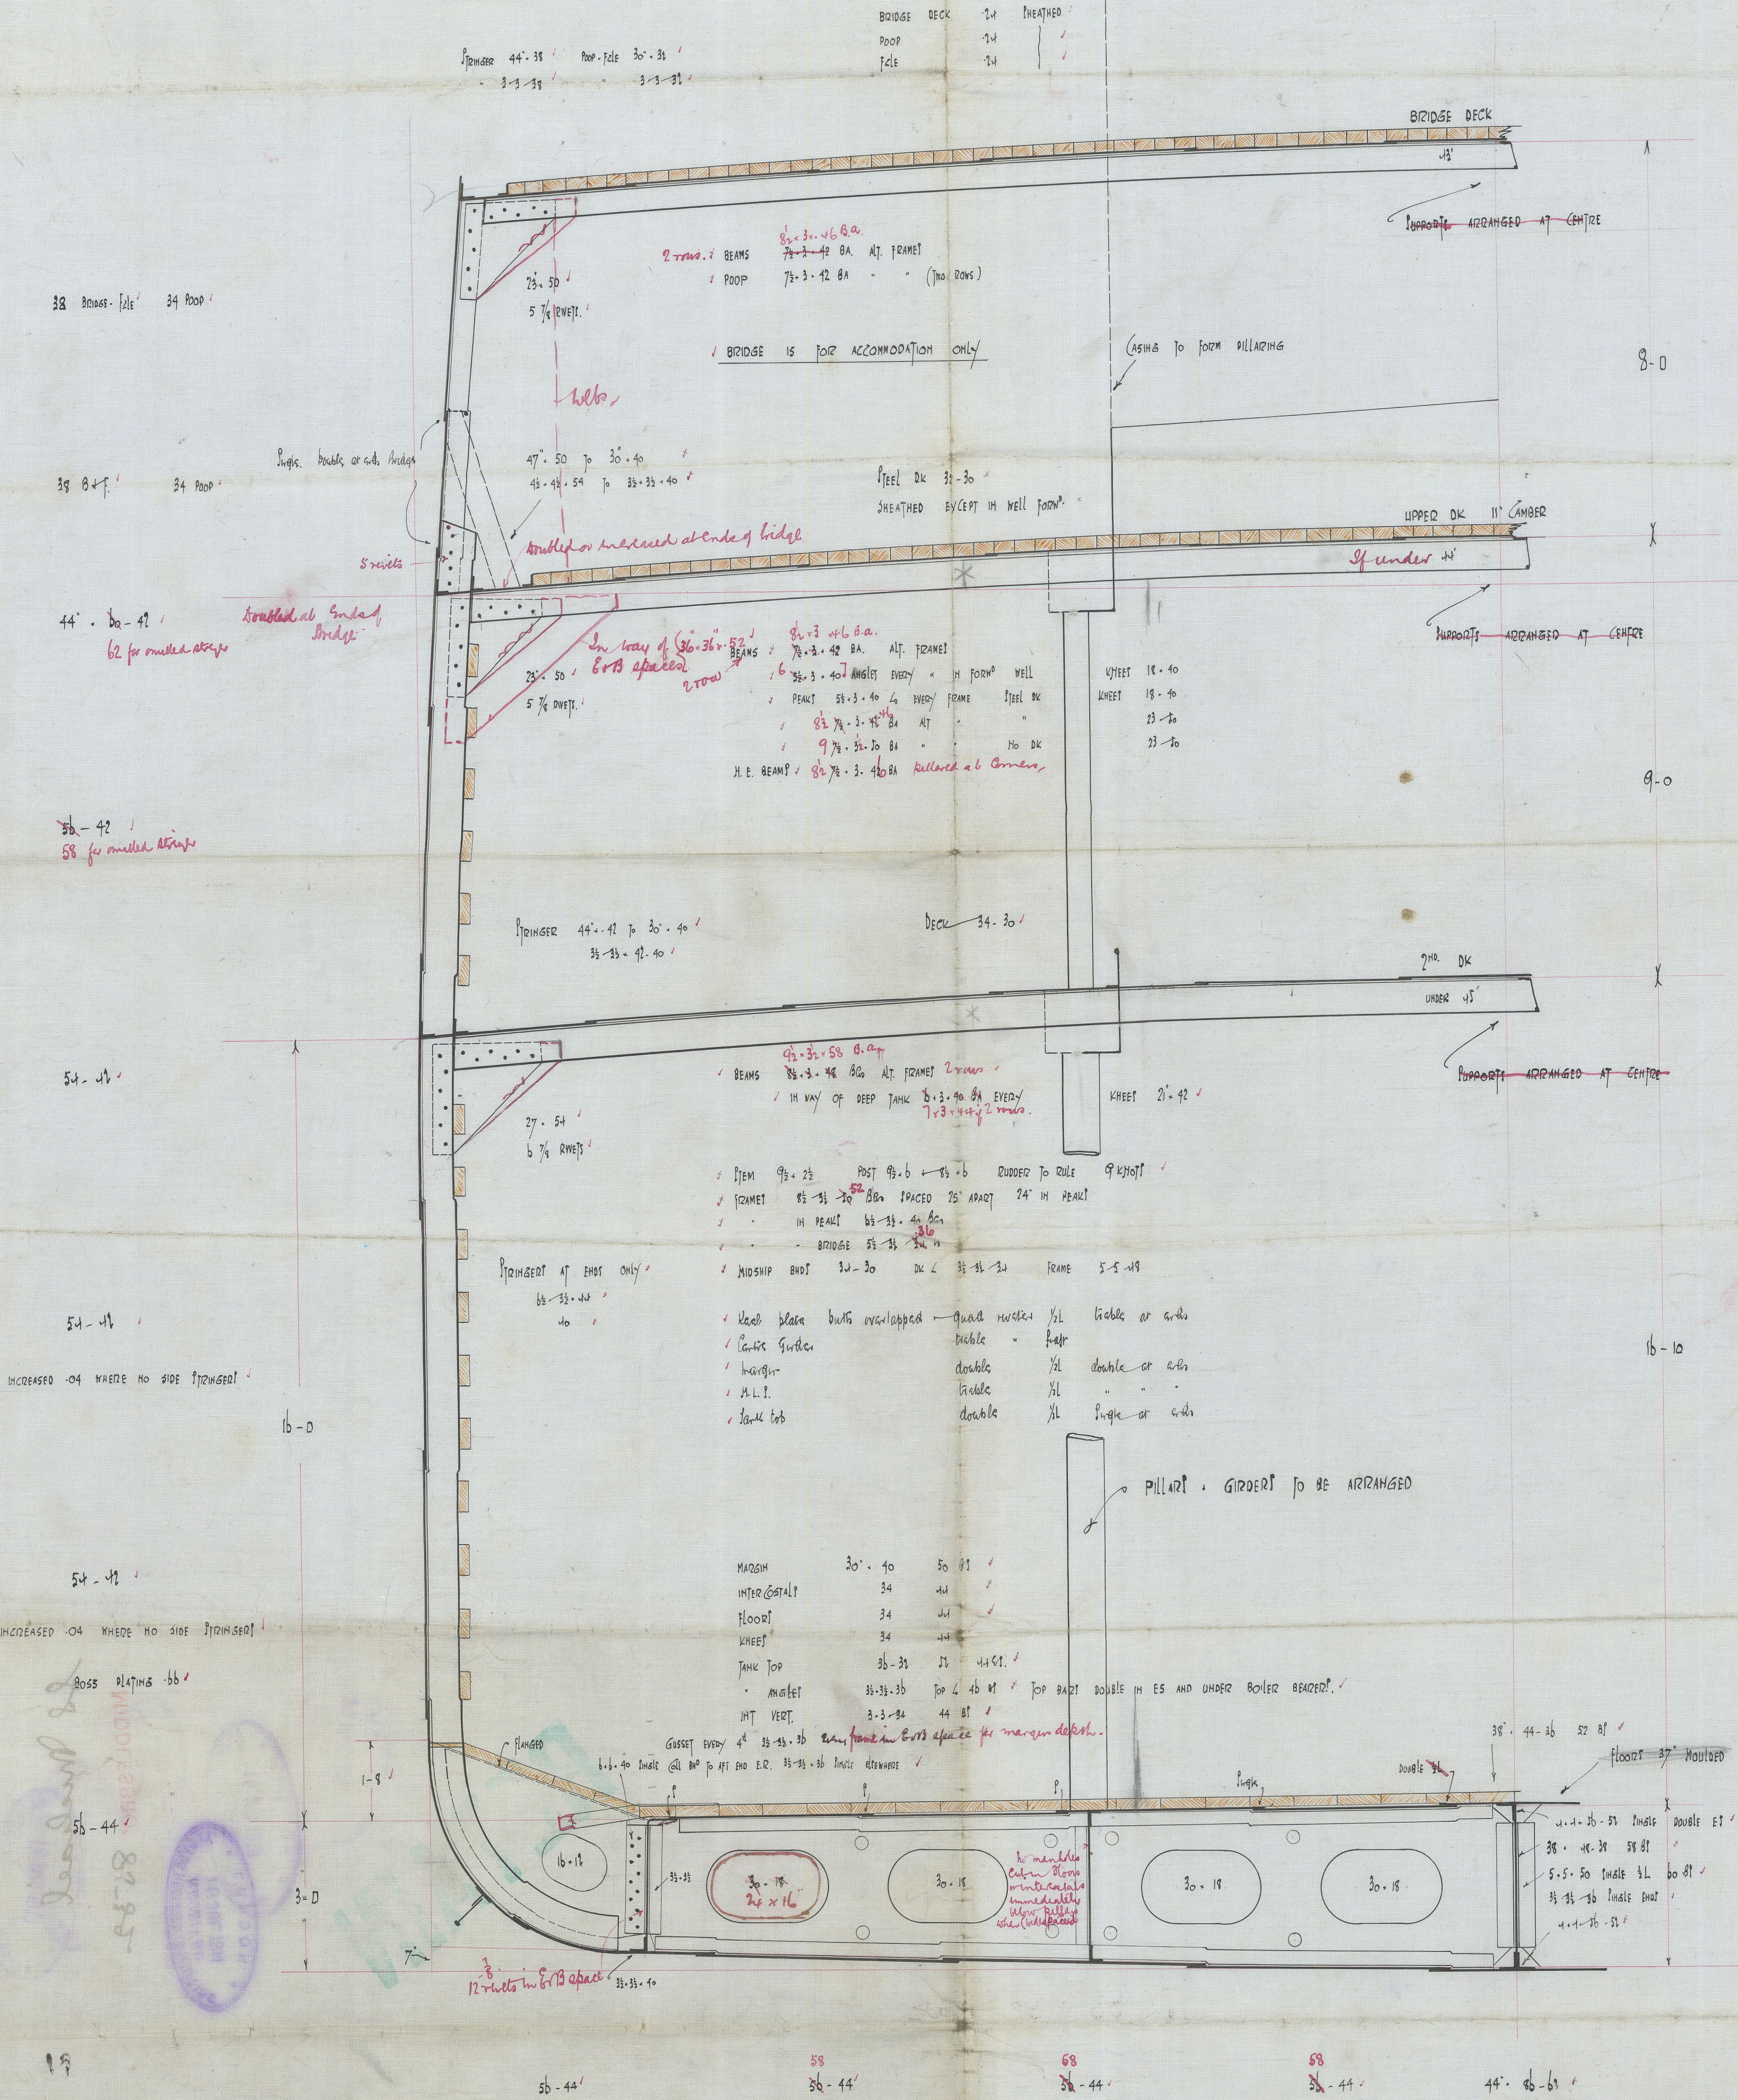


REDUCED TO 52 IN WAY OF 20 BOTTOM. MIDSHIP THICKNESS CARRIED FORWARD TO COLL B.P.
TANK FRAMES DOUBLED FOR 3/4 FORM TO COLL B.P.

Sir R. Dixon & Co. Ltd
S. S. No. 586
Midship Section.

St Michael

MIDDLESBRO' 8582

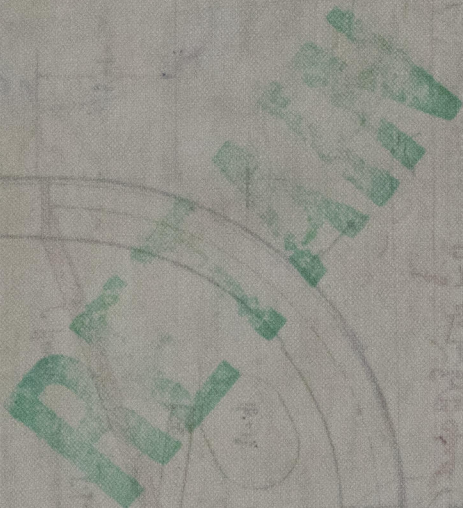

© 2021

Lloyd's Register
Foundation
W63889222