


MIDSHIP SECTION.

475'0" x 56'0" x 35'6" MLD.

SCALE 1/2" = 1' F

14.4.02
13.6.02
20.6.02
9.9.02
18.9.02
16.12.02

BRIDGE DECK.
BEAMS 6" x 3" x 1/2" B.A. ON EVERY FRAME
STRONG BEAMS IN ENG SPACE 9" x 3 1/2" x 1/2" B.A.
STRG PLATE 60" x 1/2" ANG 3 1/2" x 3 1/2" x 1/2"
DECK 5/16" IRON

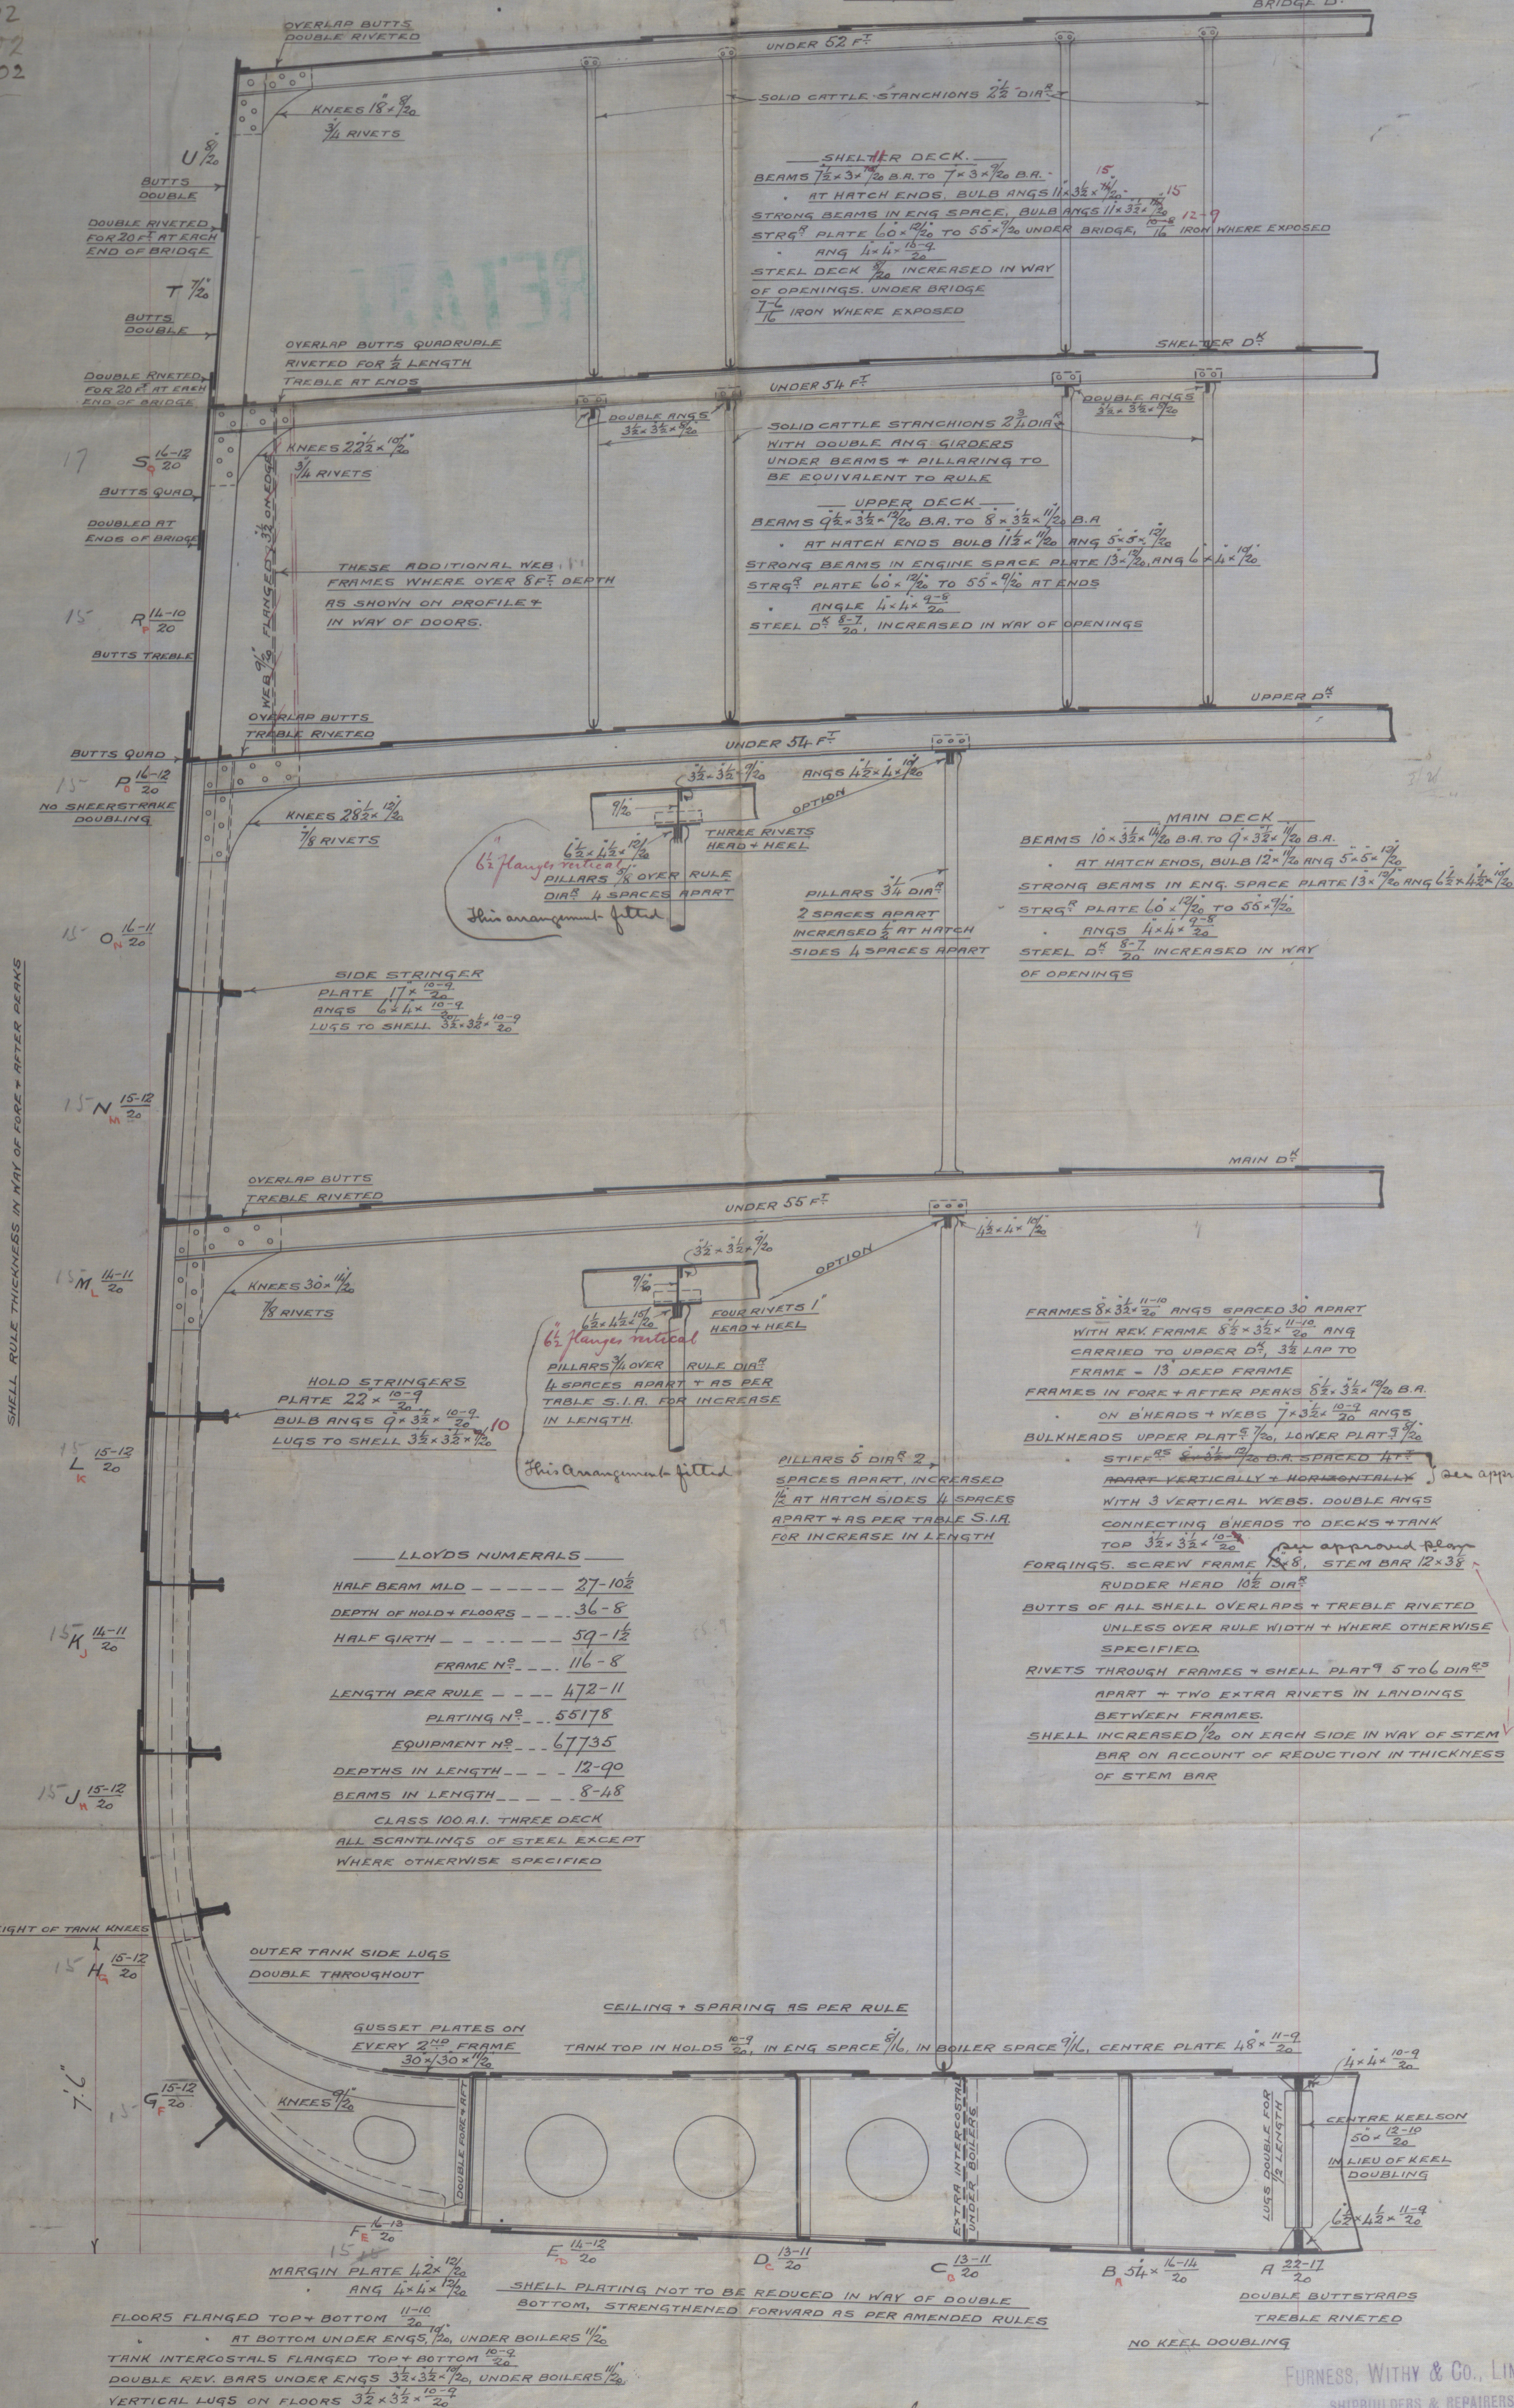

LLOYD'S NUMERALS	
HALF BEAM MLD	27-10 1/2
DEPTH OF HOLD + FLOORS	36-8
HALF GIRTH	59-1 1/2
FRAME N°	116-8
LENGTH PER RULE	472-11
PLATING N°	55178
EQUIPMENT N°	67735
DEPTHS IN LENGTH	12-90
BEAMS IN LENGTH	8-48

CLASS 100 A.I. THREE DECK
ALL SCANTLINGS OF STEEL EXCEPT WHERE OTHERWISE SPECIFIED

FURNESS, WITBY & CO., LIMITED
SHIPBUILDERS & REPAIRERS,
WEST HARTLEPOOL

N° 265

Lloyd's Register
Foundation

Messrs. Furness, Withy & Co. Ltd.
No. 265

Amended Midship Section
"Overton Grange"

Hpl. Report No. 12128.

RECEIVED
28 APR 1902

RECEIVED
20 JUN 1902

RETAIN



© 2020

Lloyd's Register
Foundation

W684-0029