


7.94

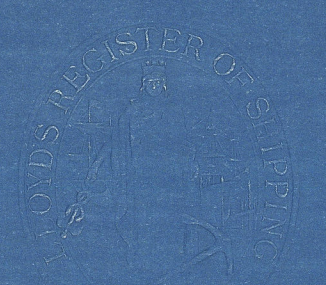


30-1-11

Proposed Lightning Holes in

MAIN DECK

T.S.S. N^o 631

Scale 1/4" = 1 Foot.

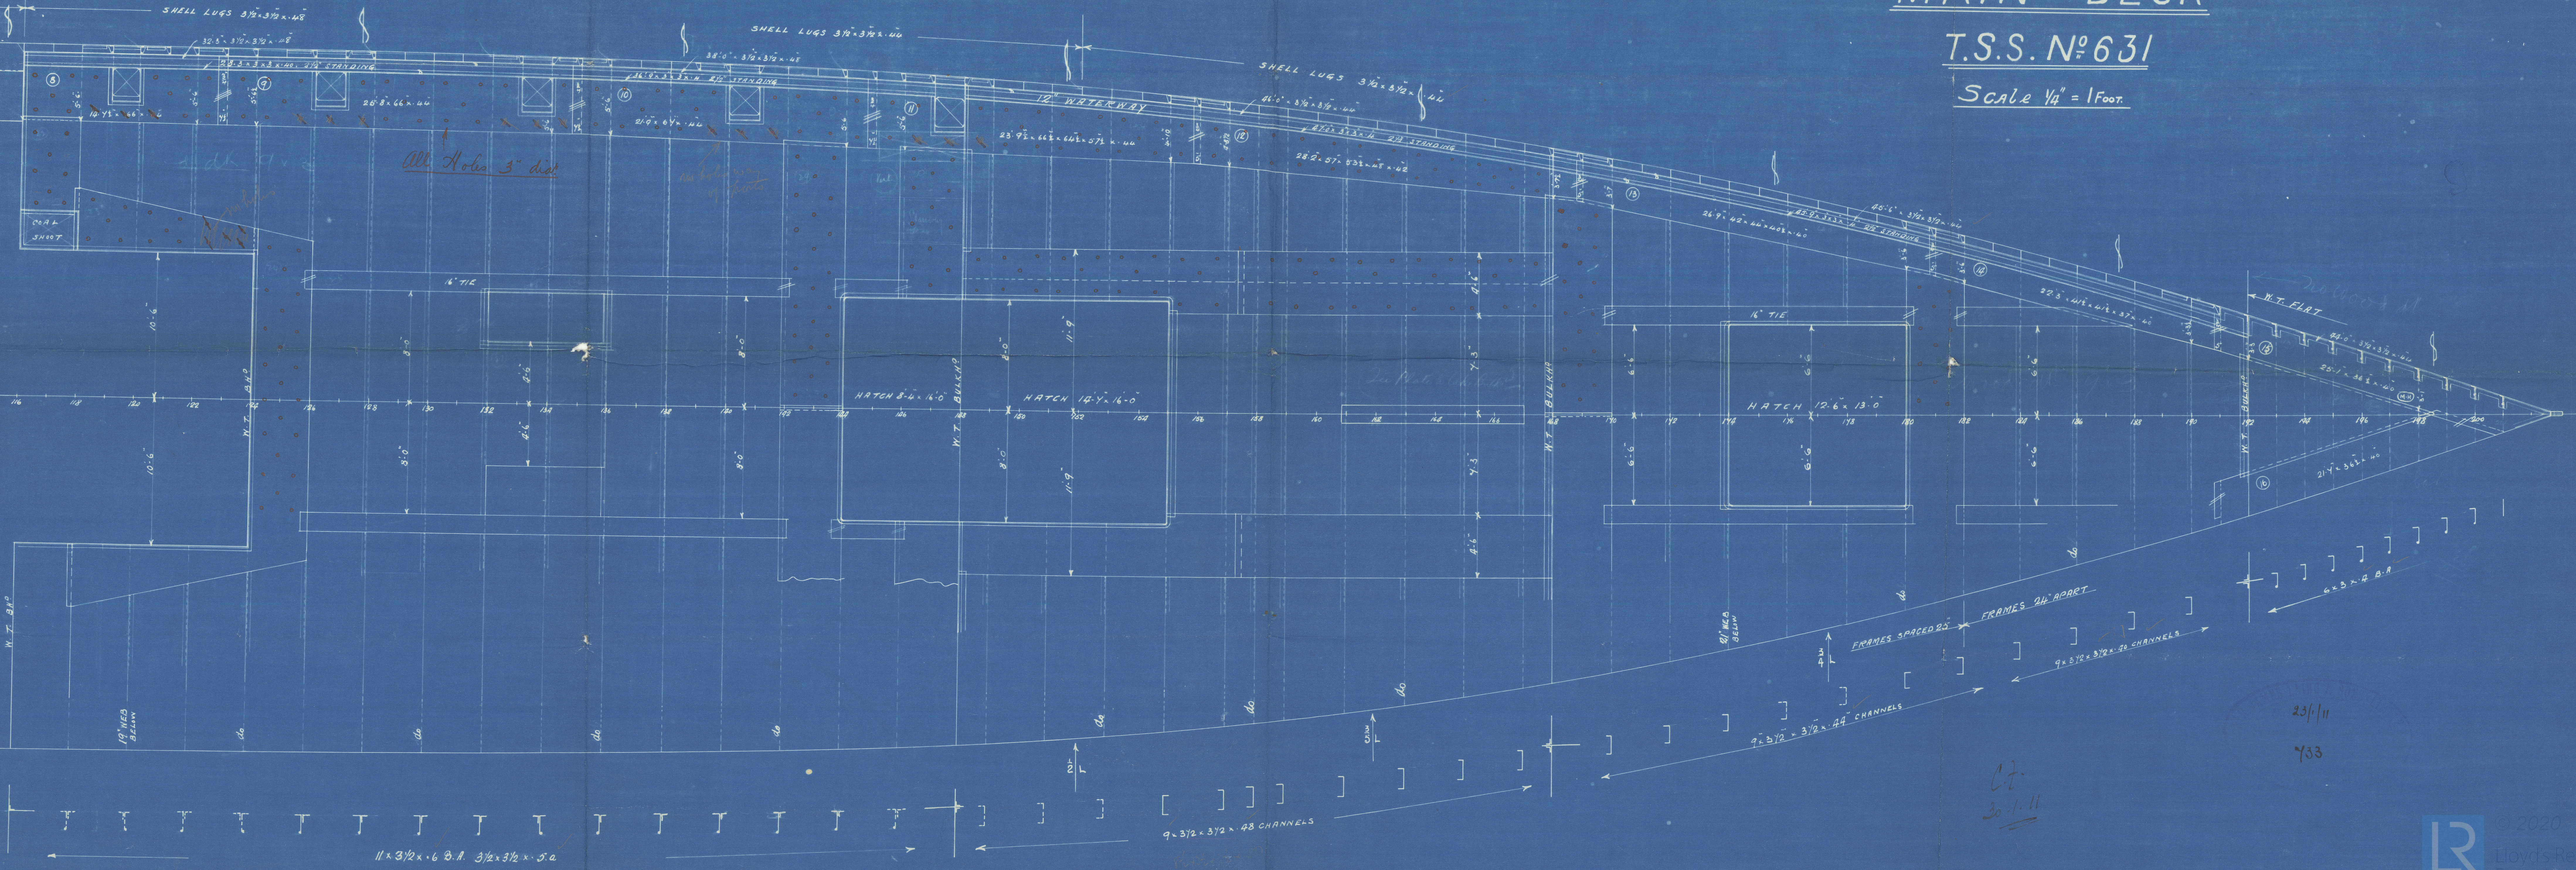

23/11

733

C7.
30-1-11

Lloyd's

W639-0194



© 2020



Lloyd's Register
Foundation

Tele. "Macedonia,
Lld. Rpt. no. 25193.
Man Dk. Plan
forward.

La J. Lang & Sons

Nº 631

To be returned

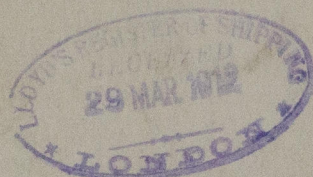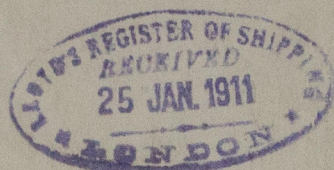

RETAIN



© 2020

Lloyd's Register
Foundation

W639-0194