




4-2-11

Section thro' Deckhouses


Y. S. S. No 631

Scale 1/2" = 1 ft

Steel deck fitted over accommodation
as per Rules.

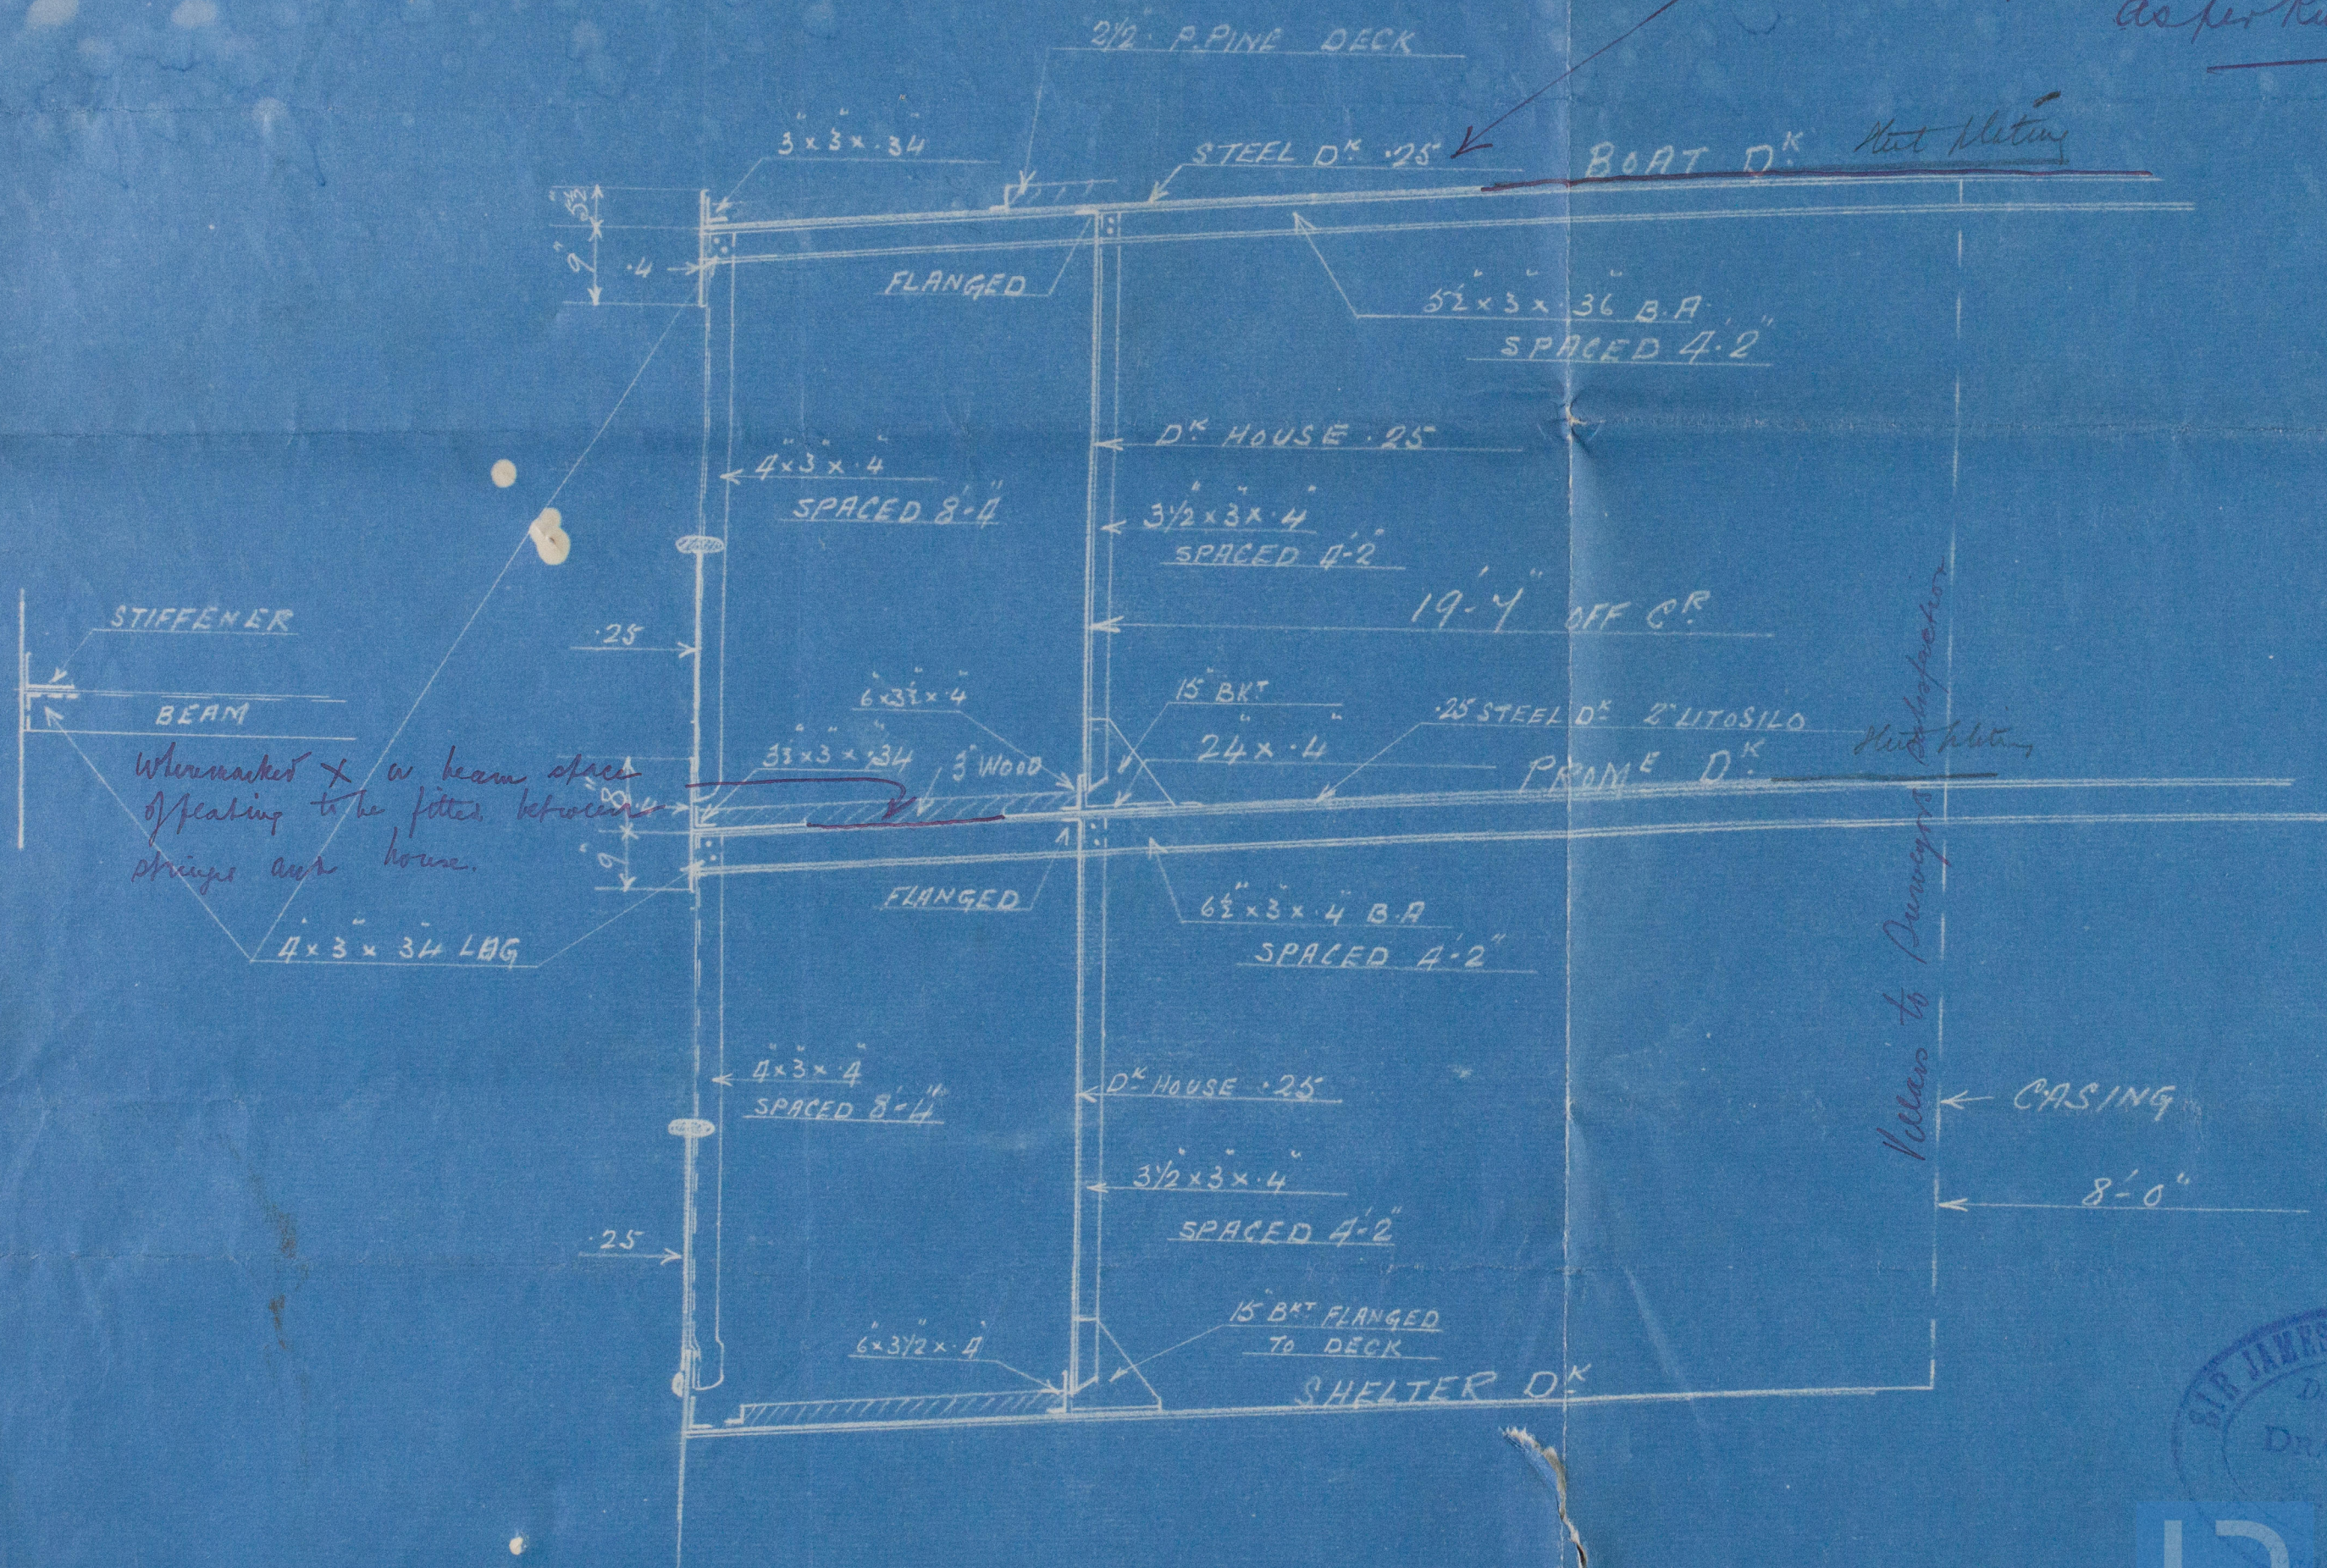

FOR LINE OF SHIP

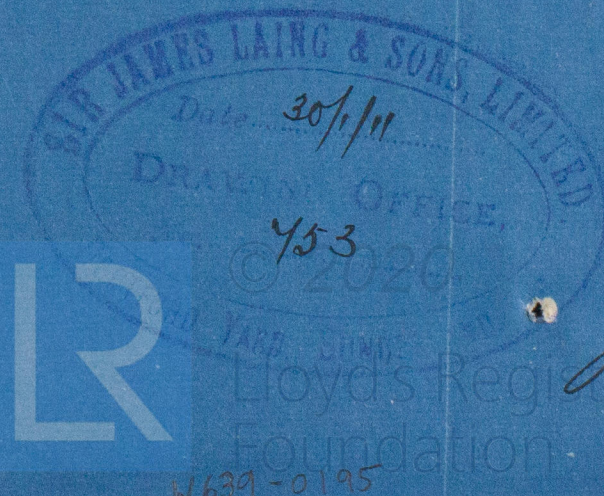

W631-0195