


Plan Shown extent of 2nd houses and proposed stiffening


Y. S. S. No 631

Steel plating over accommodation as per Rules.

Top of House is Boat Deck

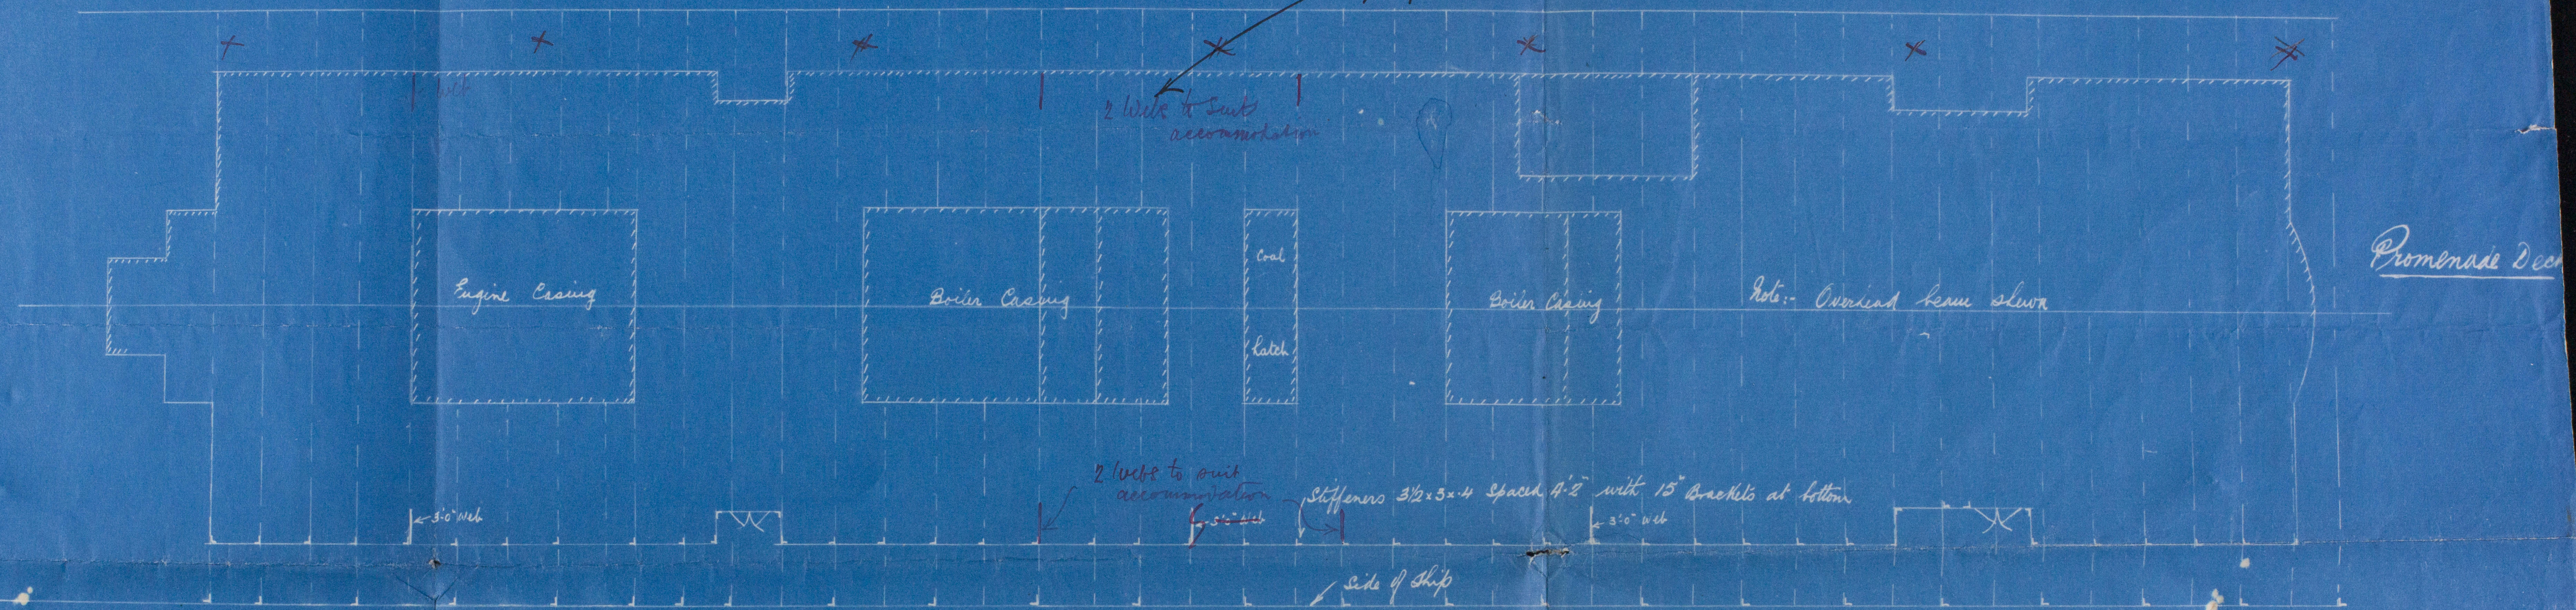

Top of House is Promenade Deck

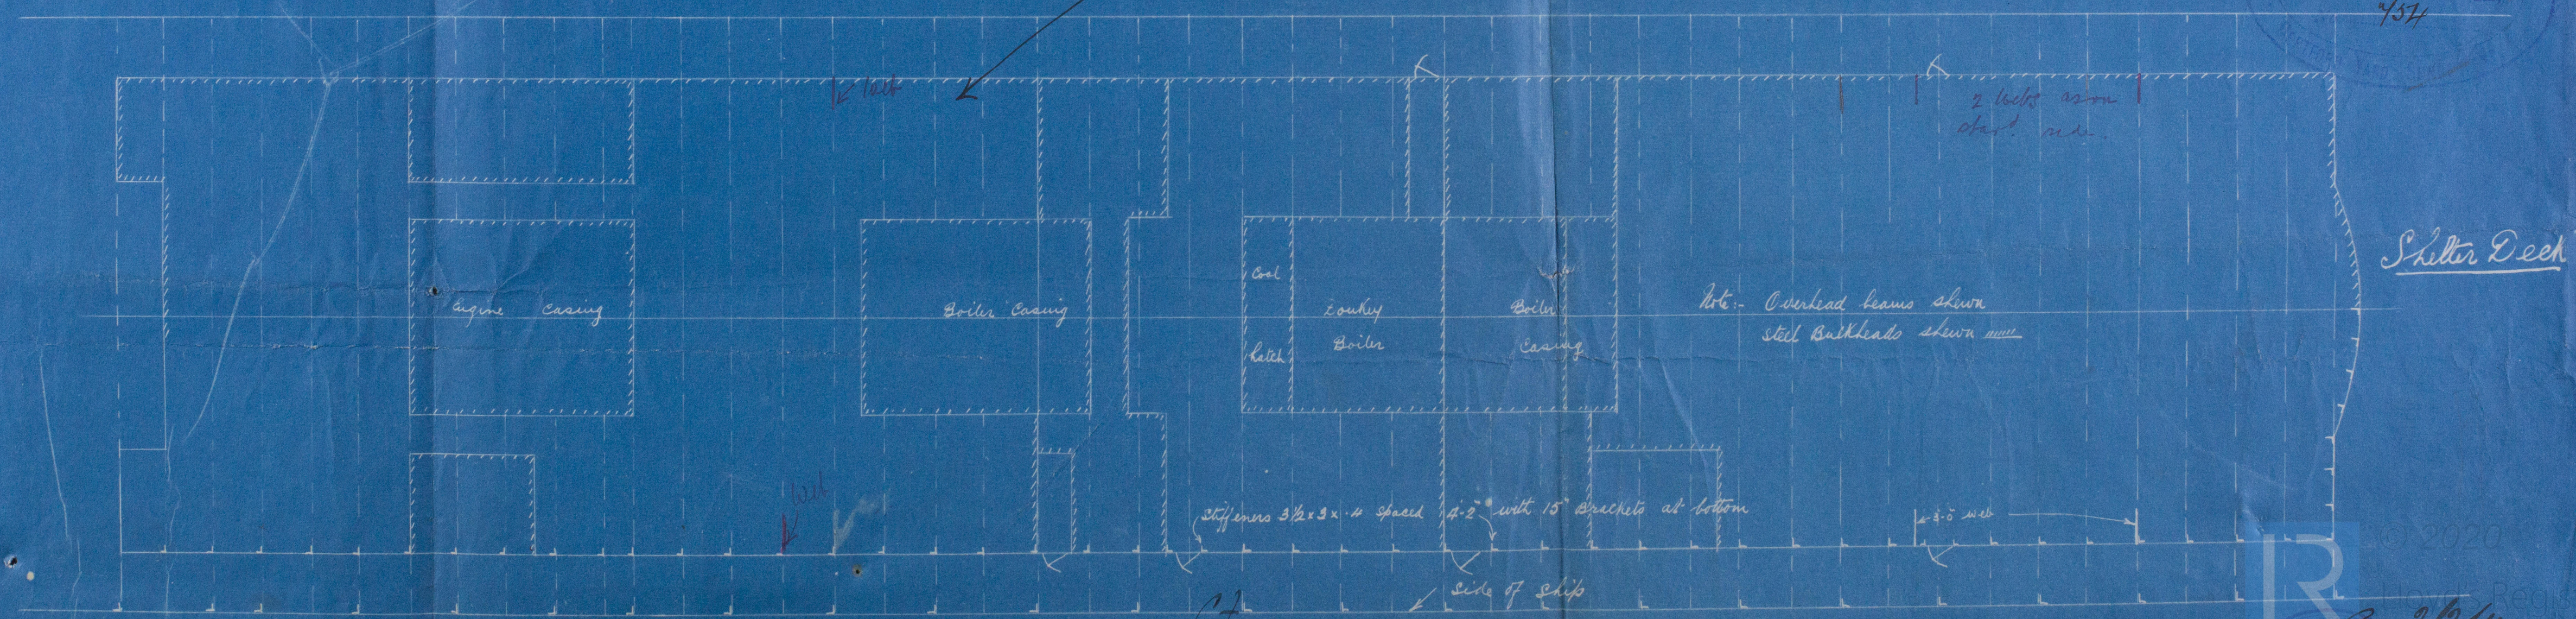

W. JAMES LANE & SONS, LIMITED
Date 30/1/11
DRAWING OFFICE
4/57

C.F.
4-2-11

© 2020
R
2/2/11

Promenade
+
Boat Decks


(with S.K. Houses in
way of game.)

Mr J. Lacey & Sons

Nº 631

"S.S. Macedonia"

S.S. Rpt. No. 25193.

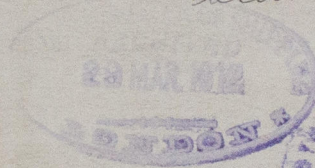

RETAIN



© 2020

Lloyd's Register
Foundation