

GRATE SURFACE 5'-3" BARS = 146.66 sf

NOTE

STEAM SPACE STAYS ARE $\frac{1}{8}$ " LAMBER IN DIAM.
THAT REQUIRED BY LLOYDS.
SMALL SCREWED STAYS ($1\frac{1}{2}$ " & $\frac{5}{8}$ " DIA) ARE 10%
IN EXCESS OF LLOYDS.

Job Nos 286

Mull: steel main Bolts
Nº 281.

by

Ransler & Seesmore

for


Russell 1608 2605-45

180 lbs. working pressure

Tested 315710

S. S. Rorer

Greenock Plt. No. 15800

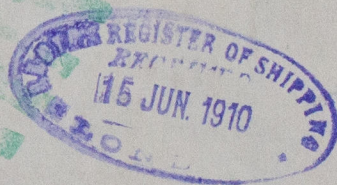

© 2020

Lloyd's Register
Foundation