

Meas. Dublin Shipbuilders Ltd.

S.S. N° 14

Profile & Deck plan

Drawing Office

Sera

Box 274

M/M. 641

braigaron

Transferred to

Port Wackato X



© 2019




Lloyd's Register
Foundation

W641-0114

— S. S. N° 14 — PROFILE AND DECK PLAN

DIMENSIONS: 180'-0" B.P. x 28'-3" MLD x 13'-3" MLD

SCALE $\frac{1}{8}$ INCH = 1 FOOT

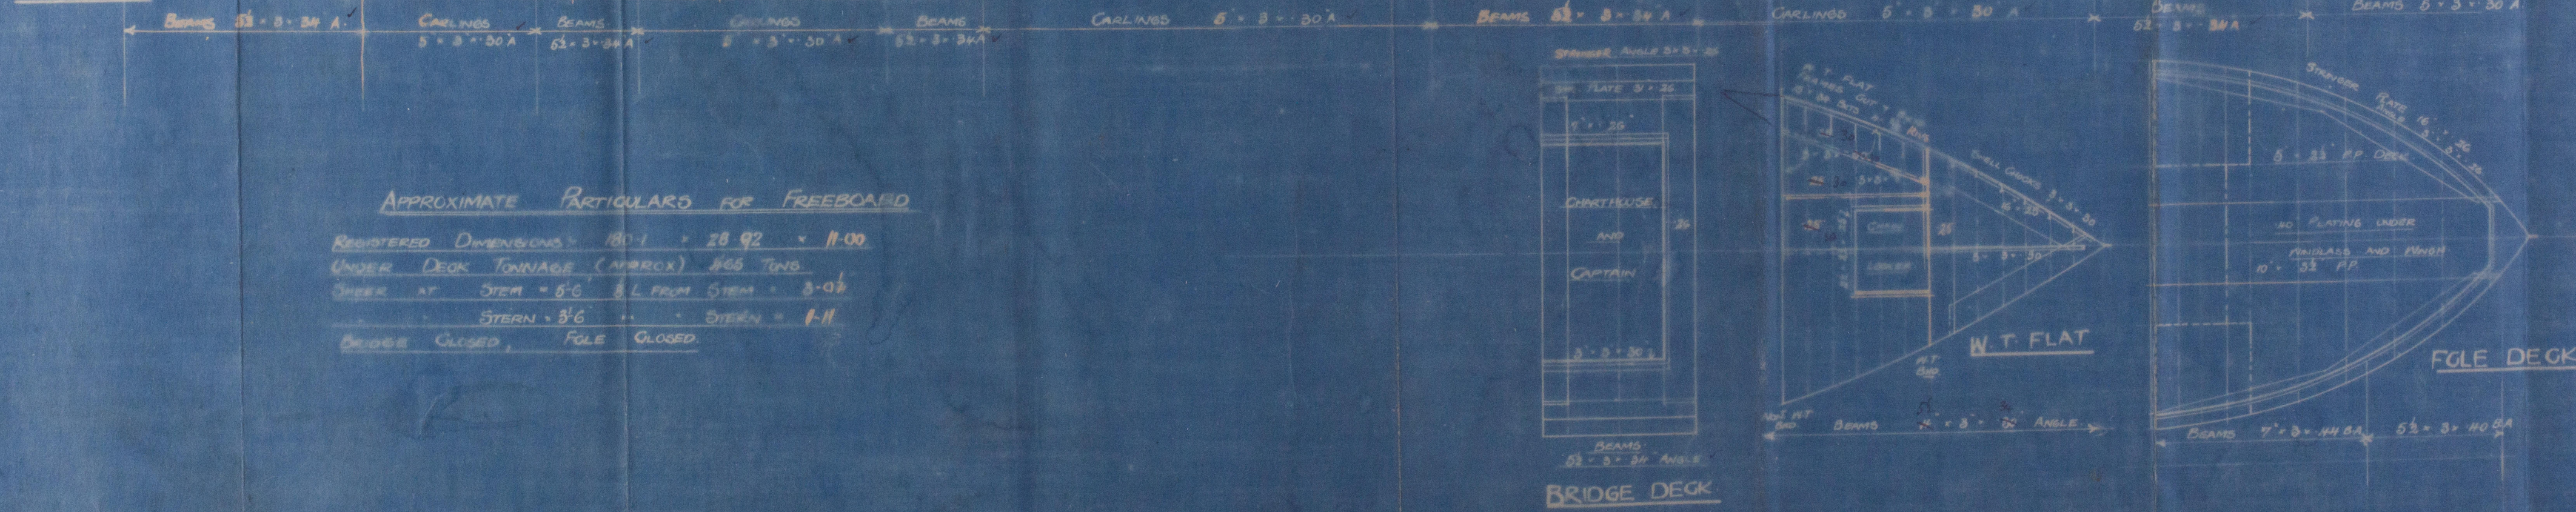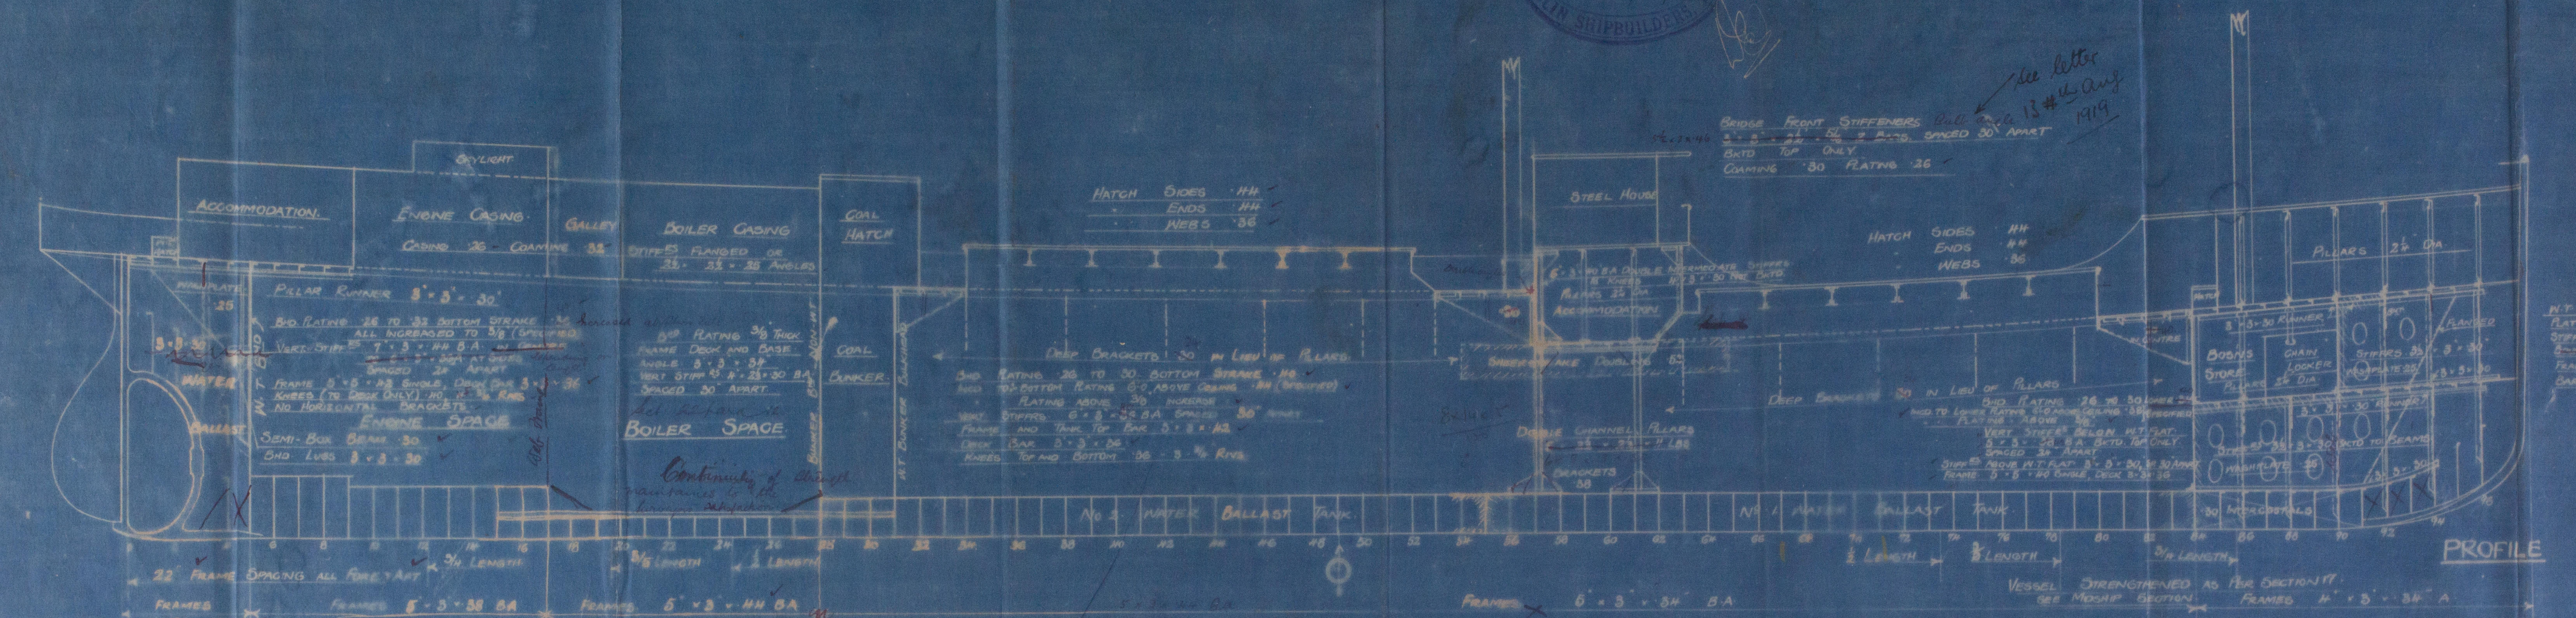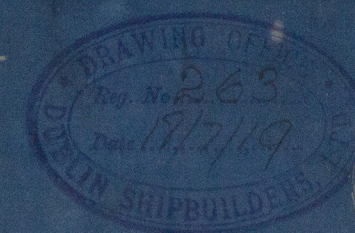

APPROXIMATE PARTICULARS FOR FREEBOARD

REGISTERED DIMENSIONS: 180'-1" x 28'-2" x 11'-0"

UNDER DECK TONNAGE (APPROX) 865 TONS

DECK AT STEM = 5'-6" 8' L FROM STEM = 3'-0"

STEM = 3'-6" STERN = 1'-11"

BRIDGE CLOSED, POLE CLOSED.