

12/22/29

No. 1222829 Multitubular Donkey Boilers for

Messrs J. L. Thompson & Son Ltd. h^o 353 8386 2/3

W. Pressure 180 lbs per sq inch

Scale 1" = 1 foot

Tested to Lloyds Requirements

Material


All plates, rivets & stay of
Steel. Tubes & Uptake of Iron

Shell Rivetting

15" holes 5 3/8" apart

Heating Surface

Tubes	700 sq ft
Furnaces	103 "
C. Chambers	87 "
Tube Plates	32 "
Total	922 sq ft

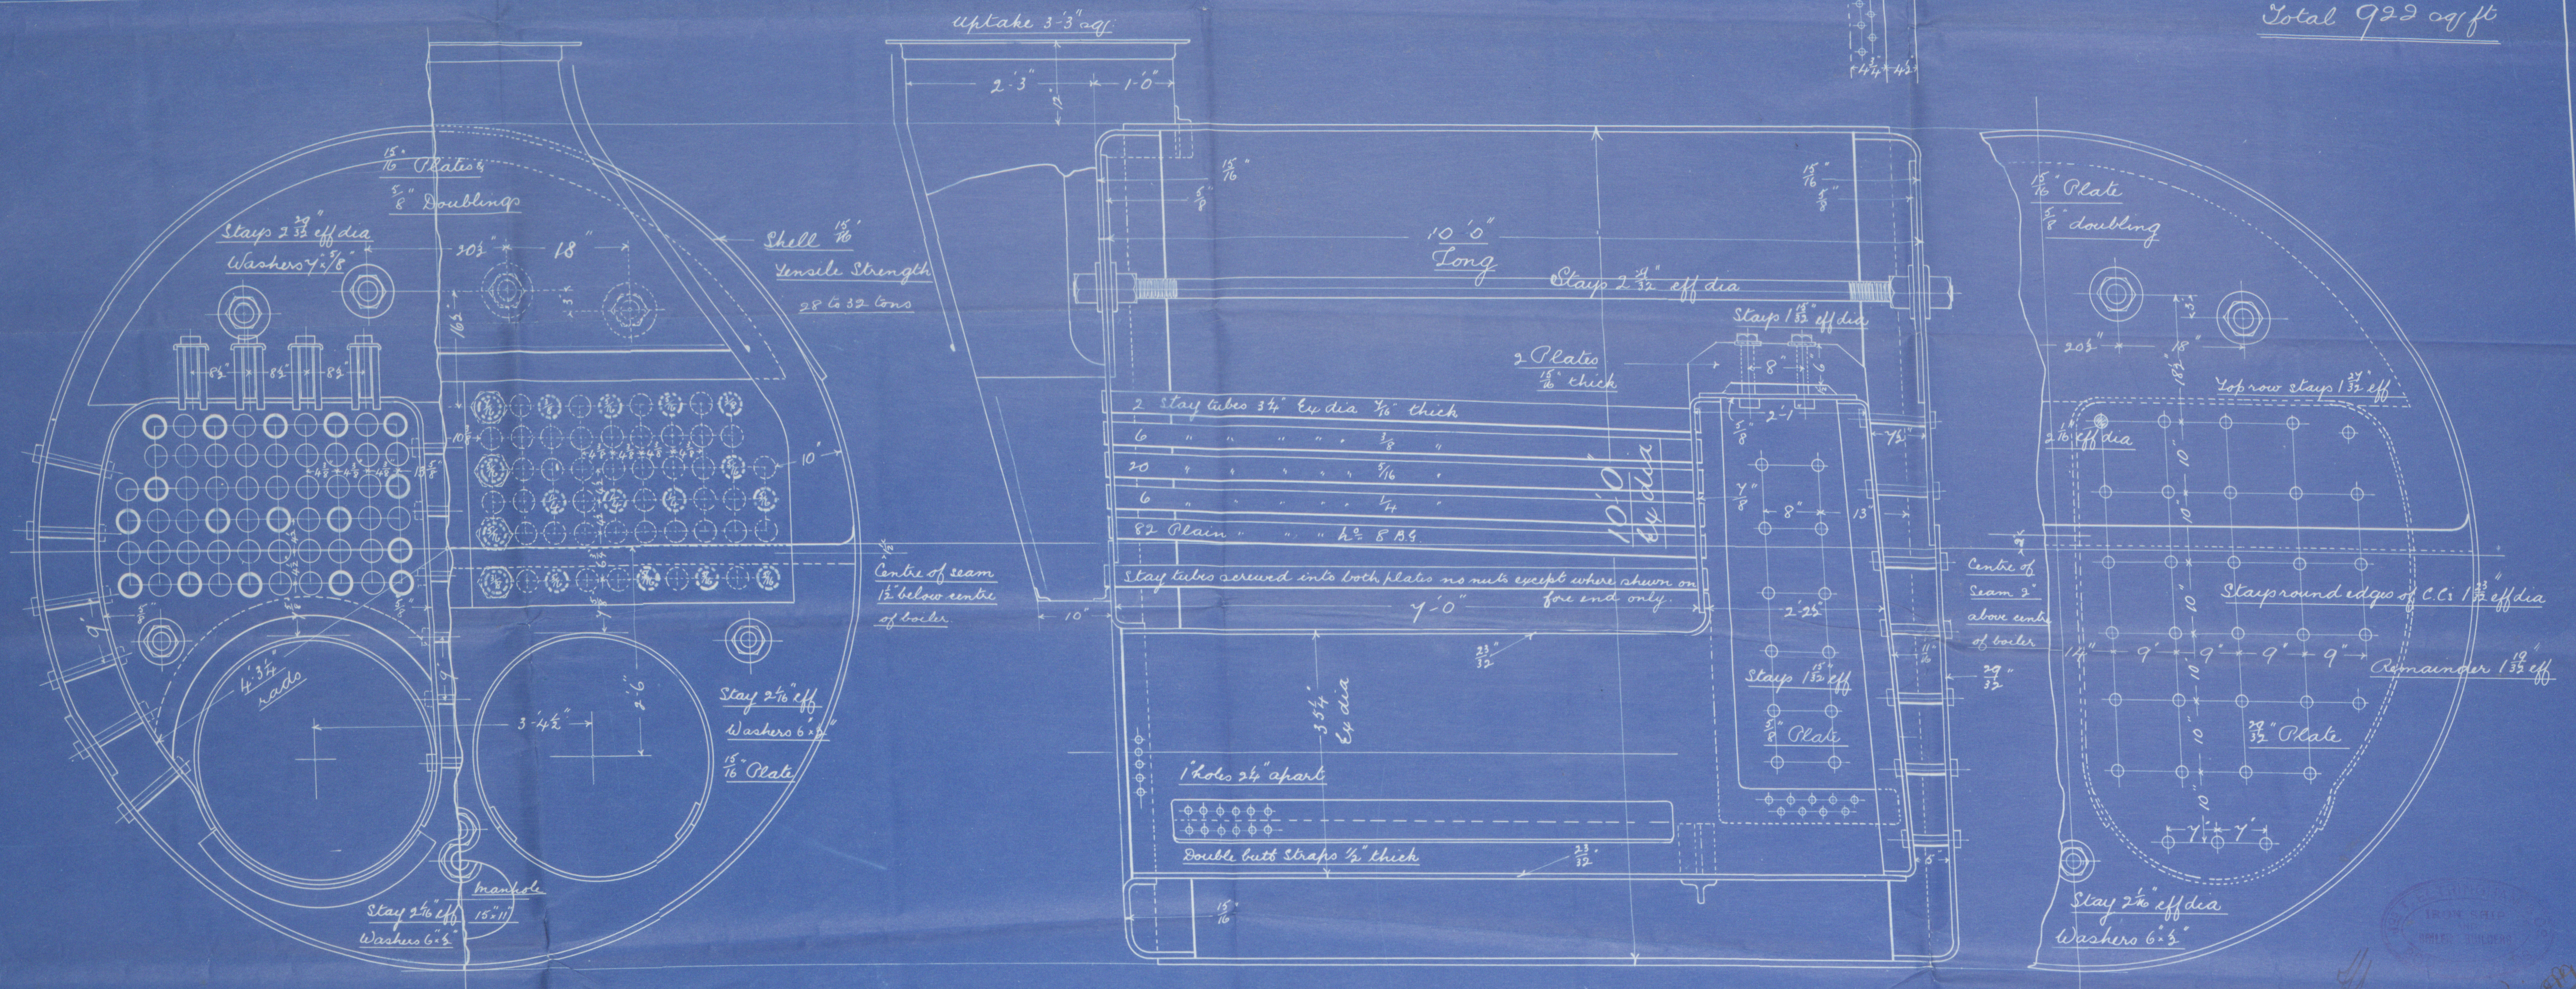

12/22/29

12/22/29

Lloyd's Register Foundation

W^d. 1228

J. J. "Monmouth"

Sunderland No 20629.
Newcastle Report

S¹²⁰ 40425

Jos. T. Eltringham }
Stone Quay }
South Shields }

5775

360⁴⁵

22.5.00 T.N.W.

W642-0101

REGISTERED
12 MAY 1898
Lloyd's Register
Foundation
9.8.99
T.N.W.