

**S. S. N<sup>os</sup> 385-386**

SCALE  $\frac{1}{2}'' = 1$  FOOT




J. L. Thompson & Sons Ltd

η: 385

- S. S. "Monomoy" -

Midship Section as built

Sunderland. η:

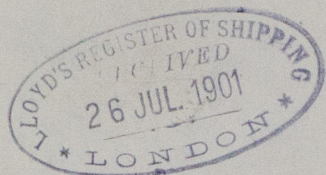

© 2020

Lloyd's Register  
Foundation

W642-0103