


# S.S. N<sup>os</sup> 385 AND 386.

SCALE 1/2" = 1'



NOTE: DOWN PLATING TO BE INCREASED 3/16 FROM STEM TO COLLISION END, 1/2" FROM LIGHT TO LOAD LINE.

 

Joseph L. Thompson & Sons Ltd


Nº 385

- S. S. "Monomoy" -

Profile. As built

Sunderland. Nº 20629

Servian ~~Primer~~  
austrian ~~Primer~~

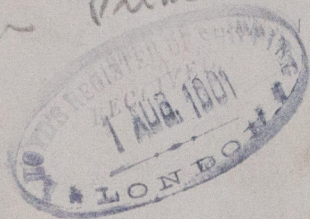

RETAIN



© 2020  
W642-0104

Lloyd's Register  
Foundation