



16.1.00

UPPER DECK.

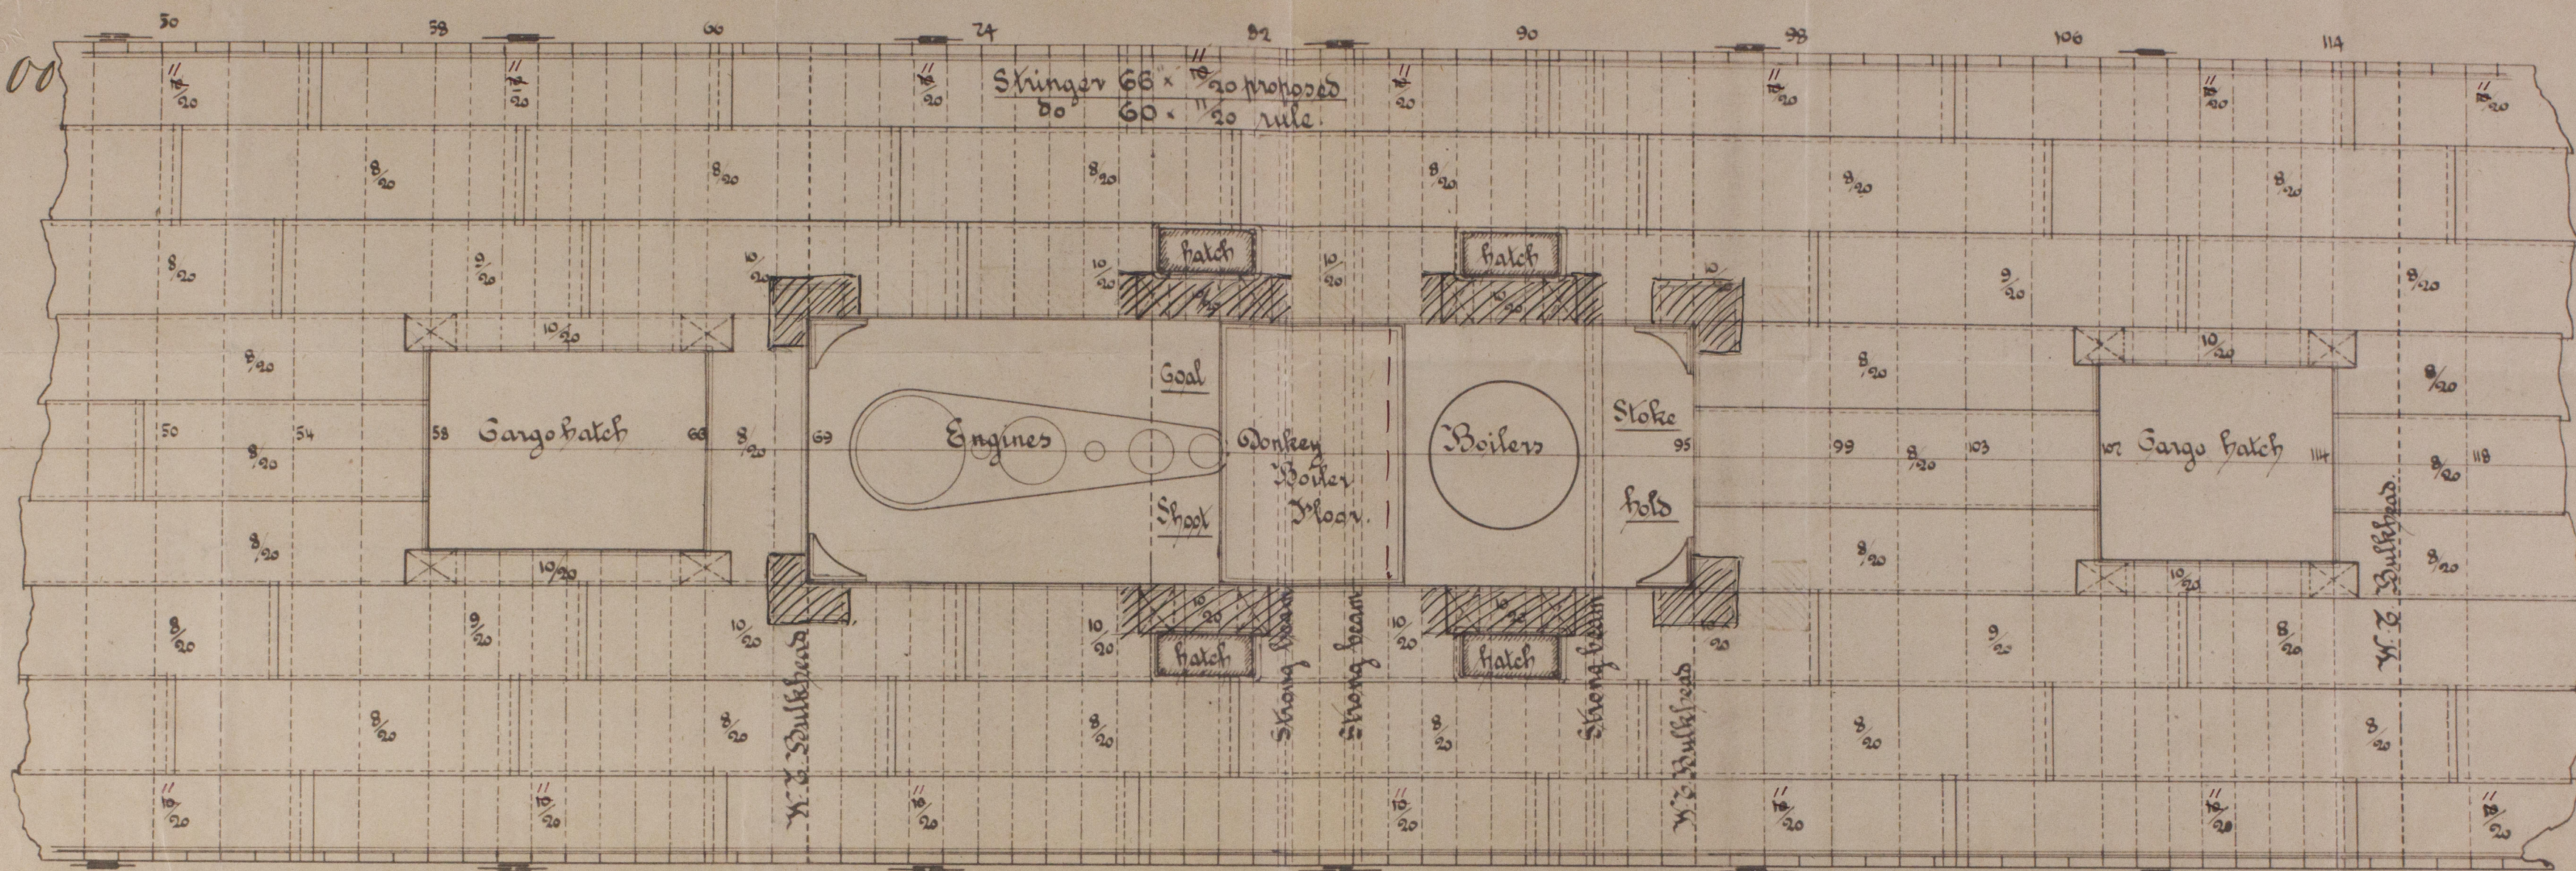

Arrangement of Deck Plating S.S. No 385 & 6.

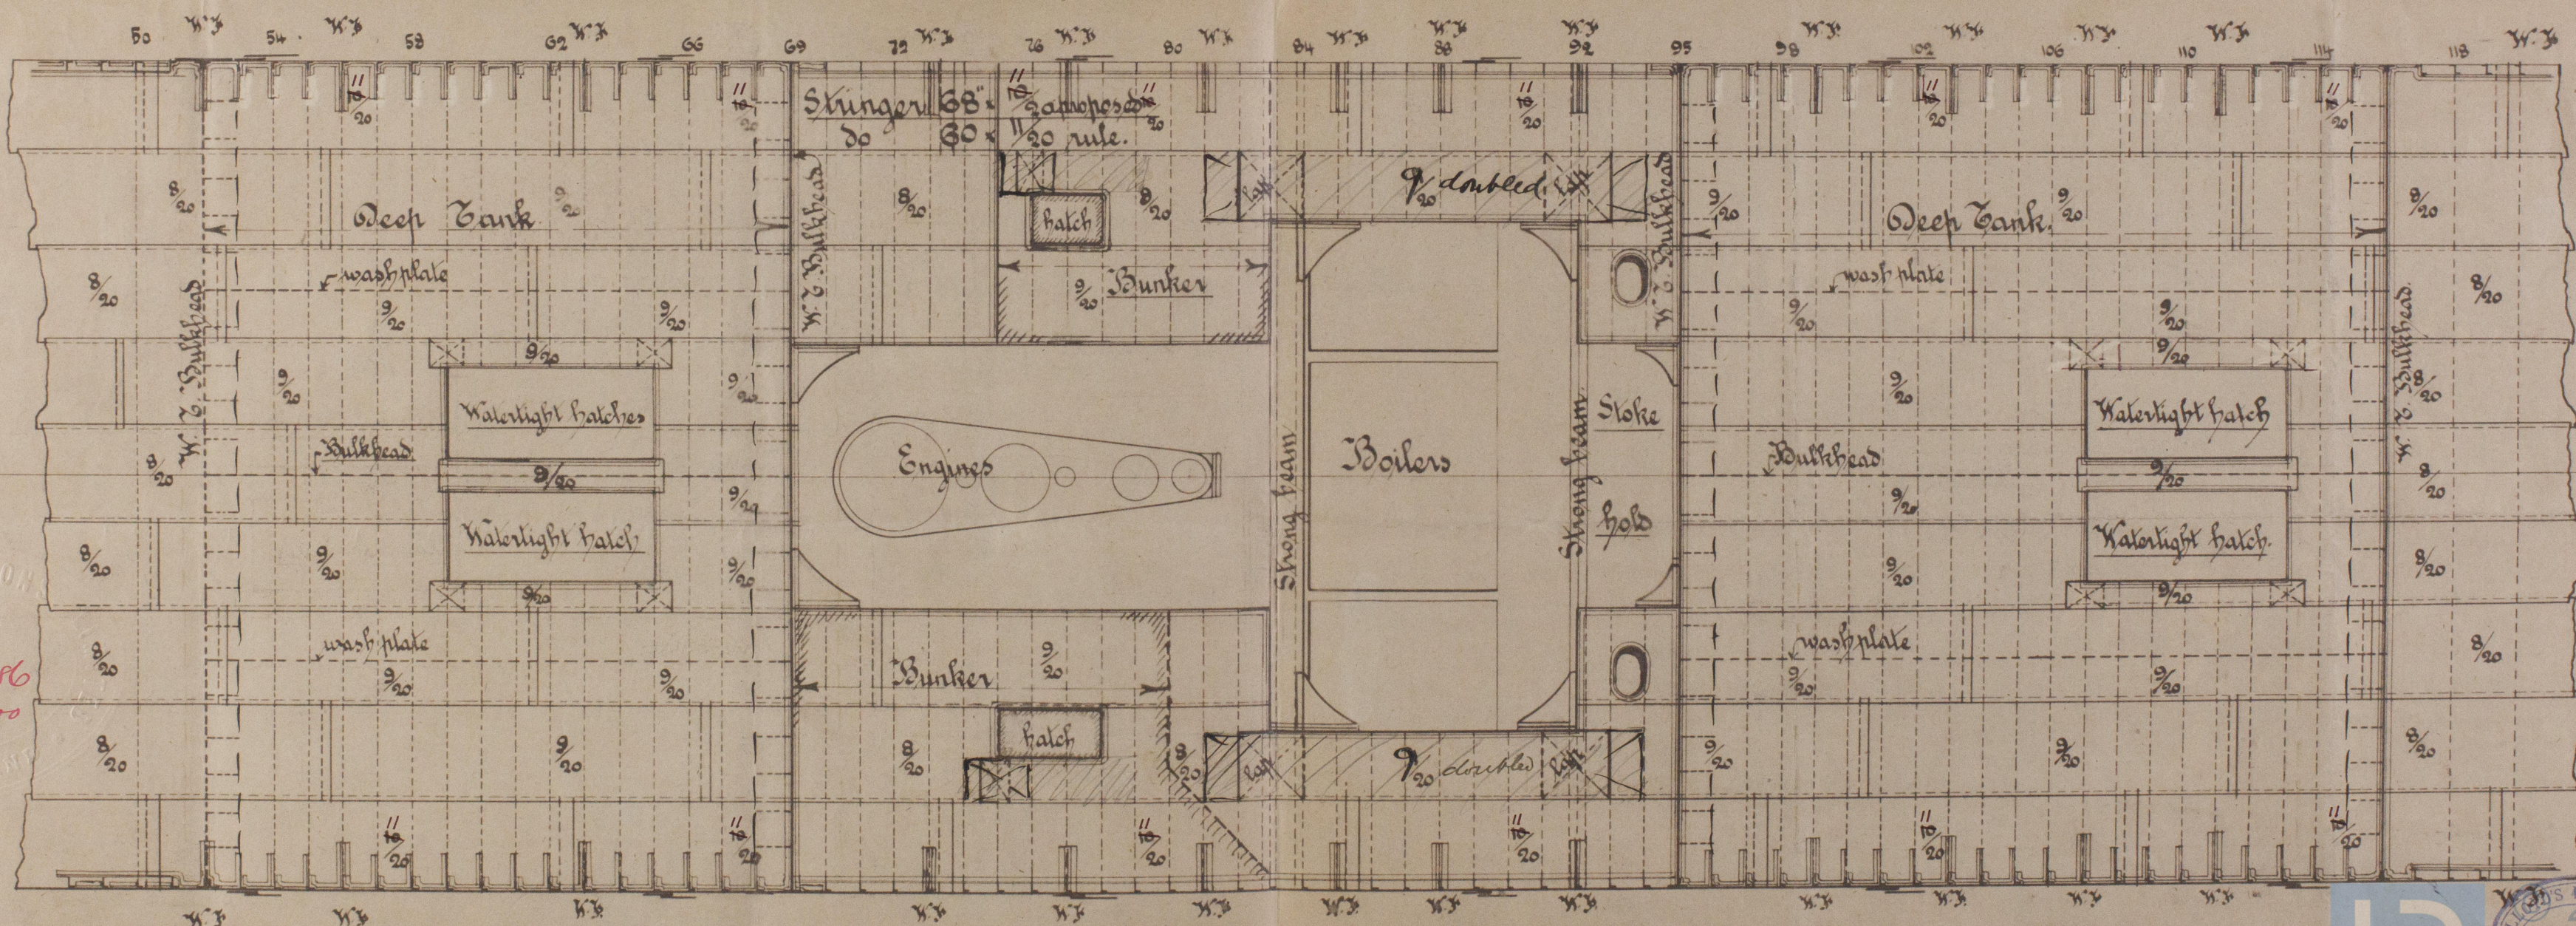

MAIN DECK.

SCALE 1/8" = ONE FOOT.

J.V.
16/1/00




Register
Foundation

501062-0105


J. L. THOMPSON & SONS

S. S. No 385-6

- DECK PLAN -

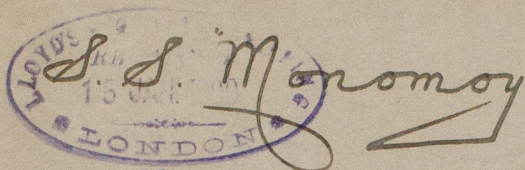

Sunderland. No 20629

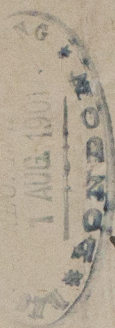

"S. S. Manitoba"
Sunderland No 20420

Deck Plan

385-6

RETAIN



© 2020

Lloyd's Register
Foundation

W642-0105