
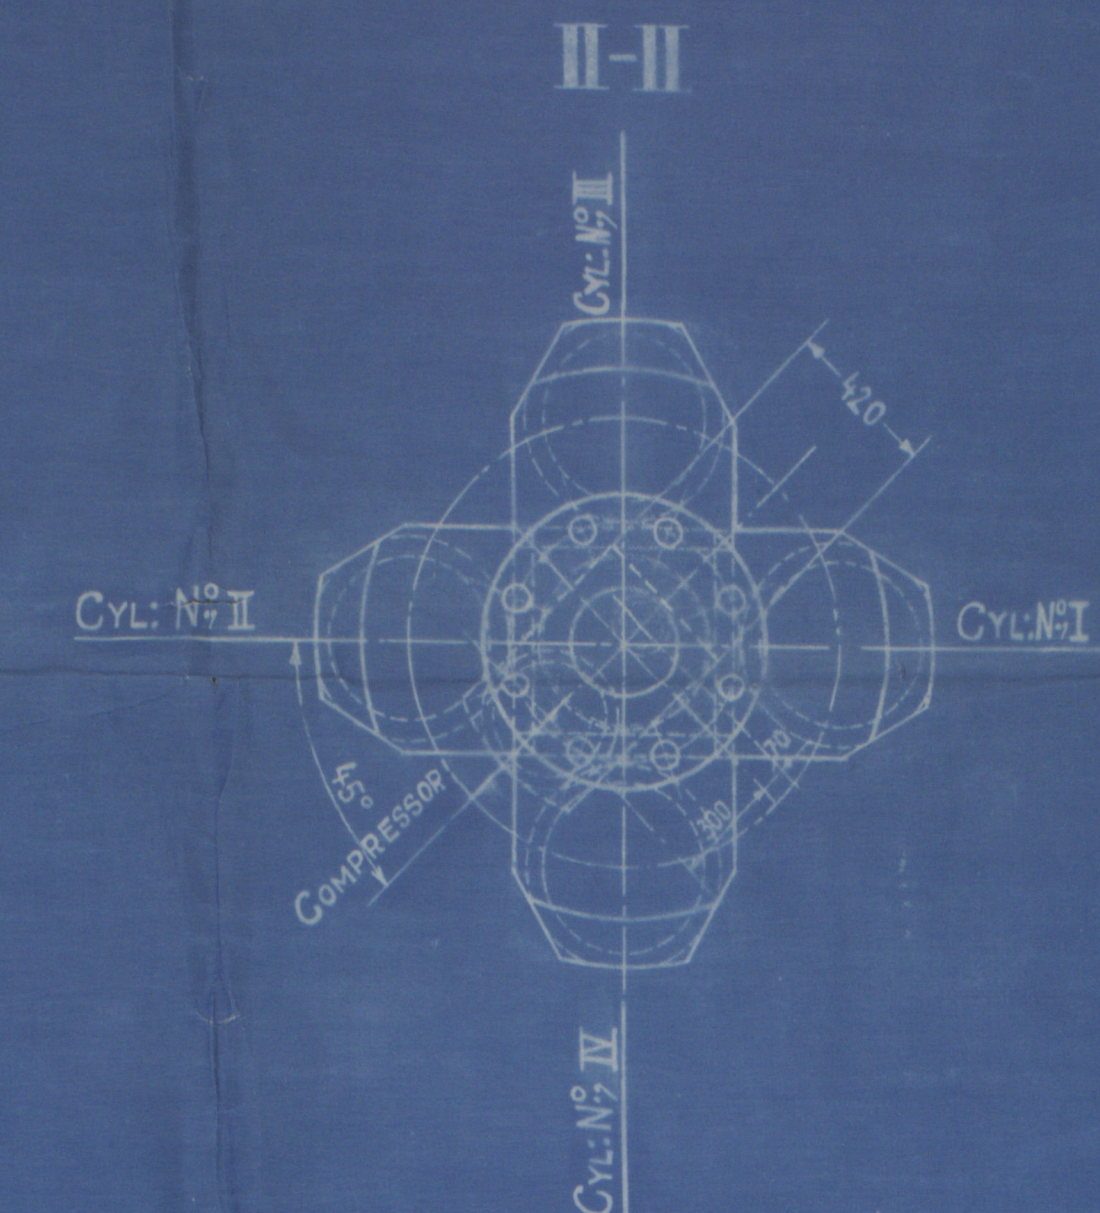


16.5.23


DIMENSIONS ARE IN MILLIMETRES.

1. OFF THIS. (COMPLETE CRANK SHAFT.)  
 MATERIAL:- SIEMENS - MARTIN ACID INGOT STEEL.  
 TENSILE STRENGTH 28-32 TONS / IN.<sup>2</sup>

TO LLOYD'S REQUIREMENTS.

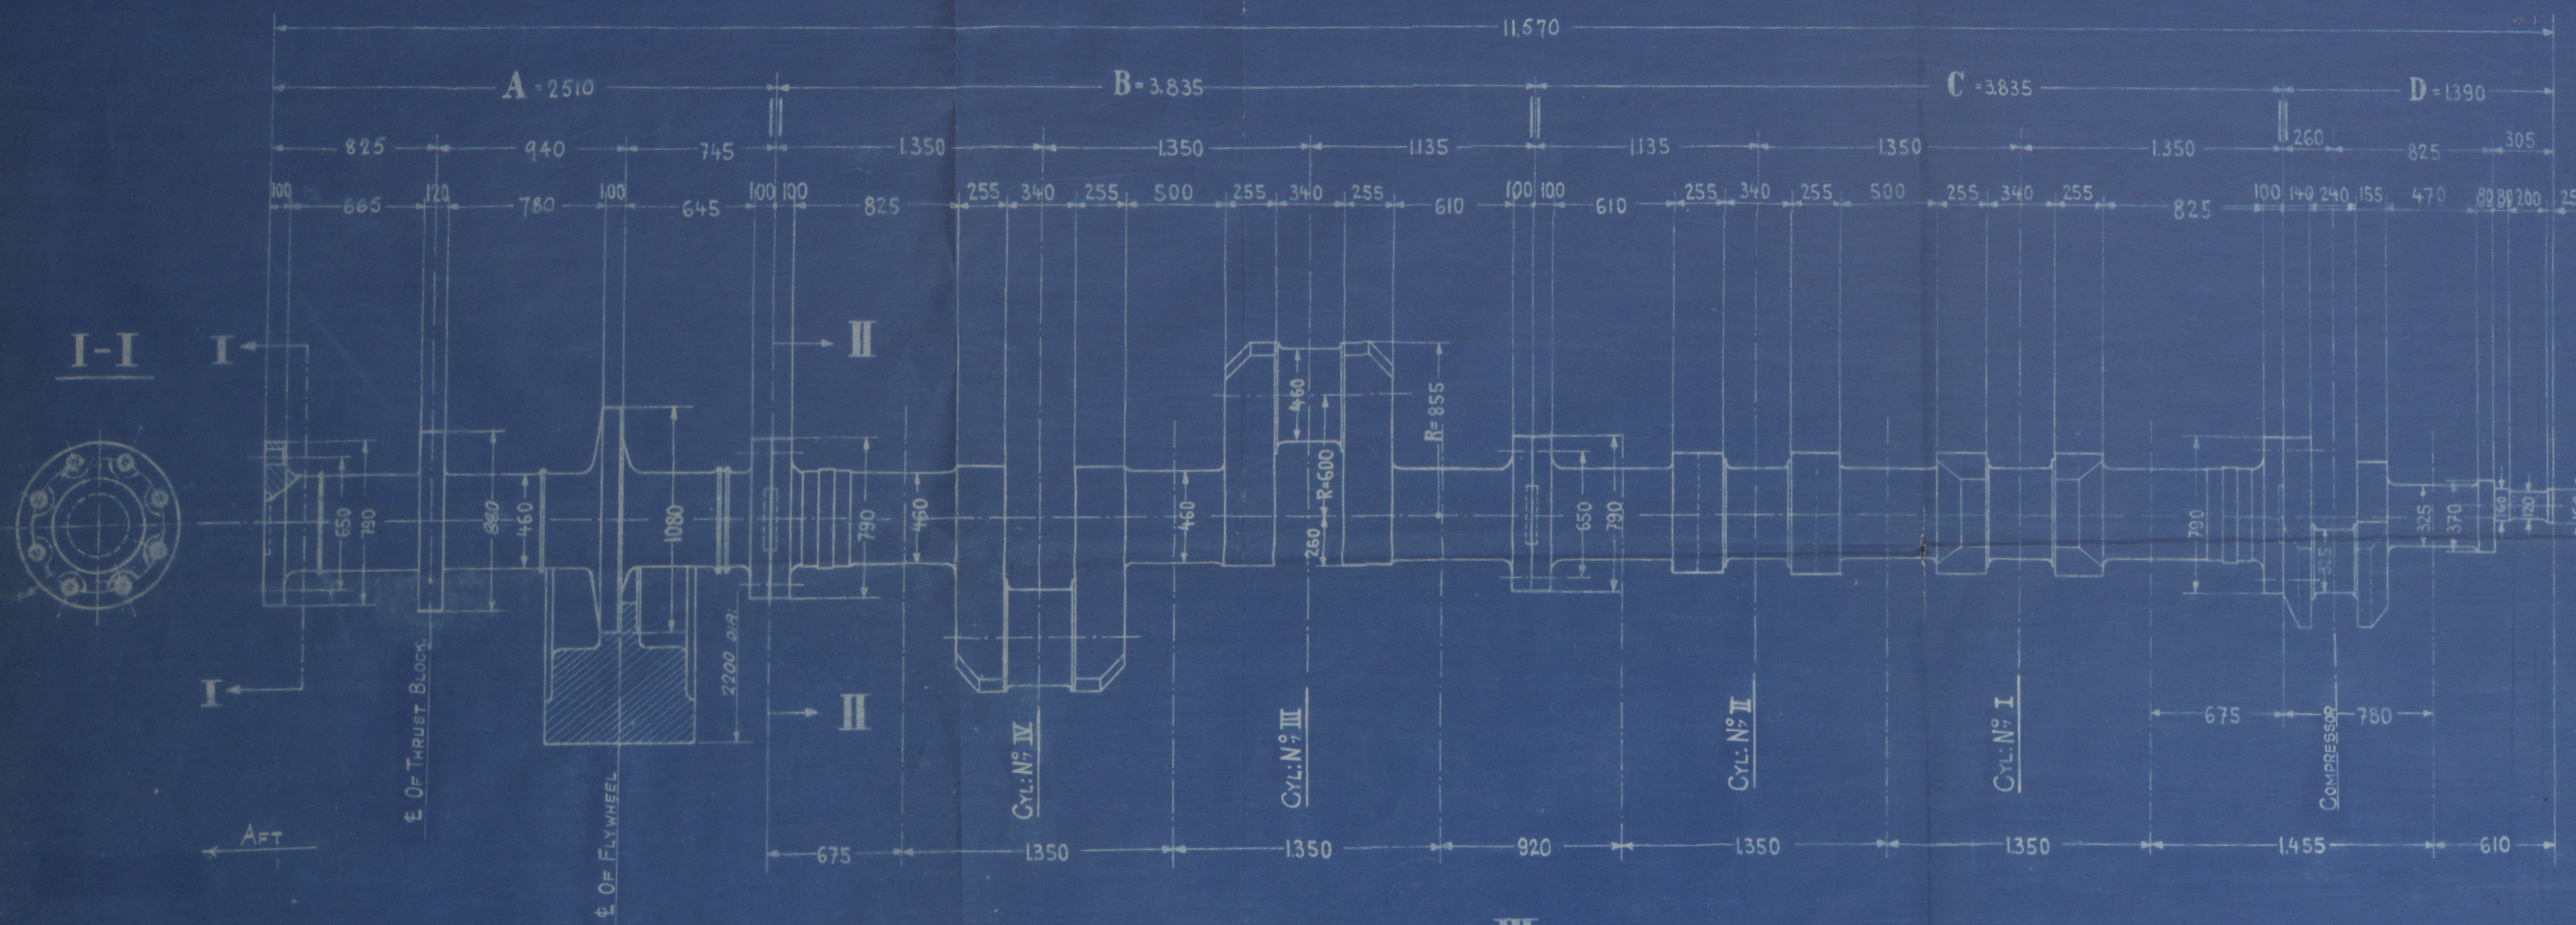

WEIGHT OF RIM OF FLYWHEEL:- 27,836 LBS.

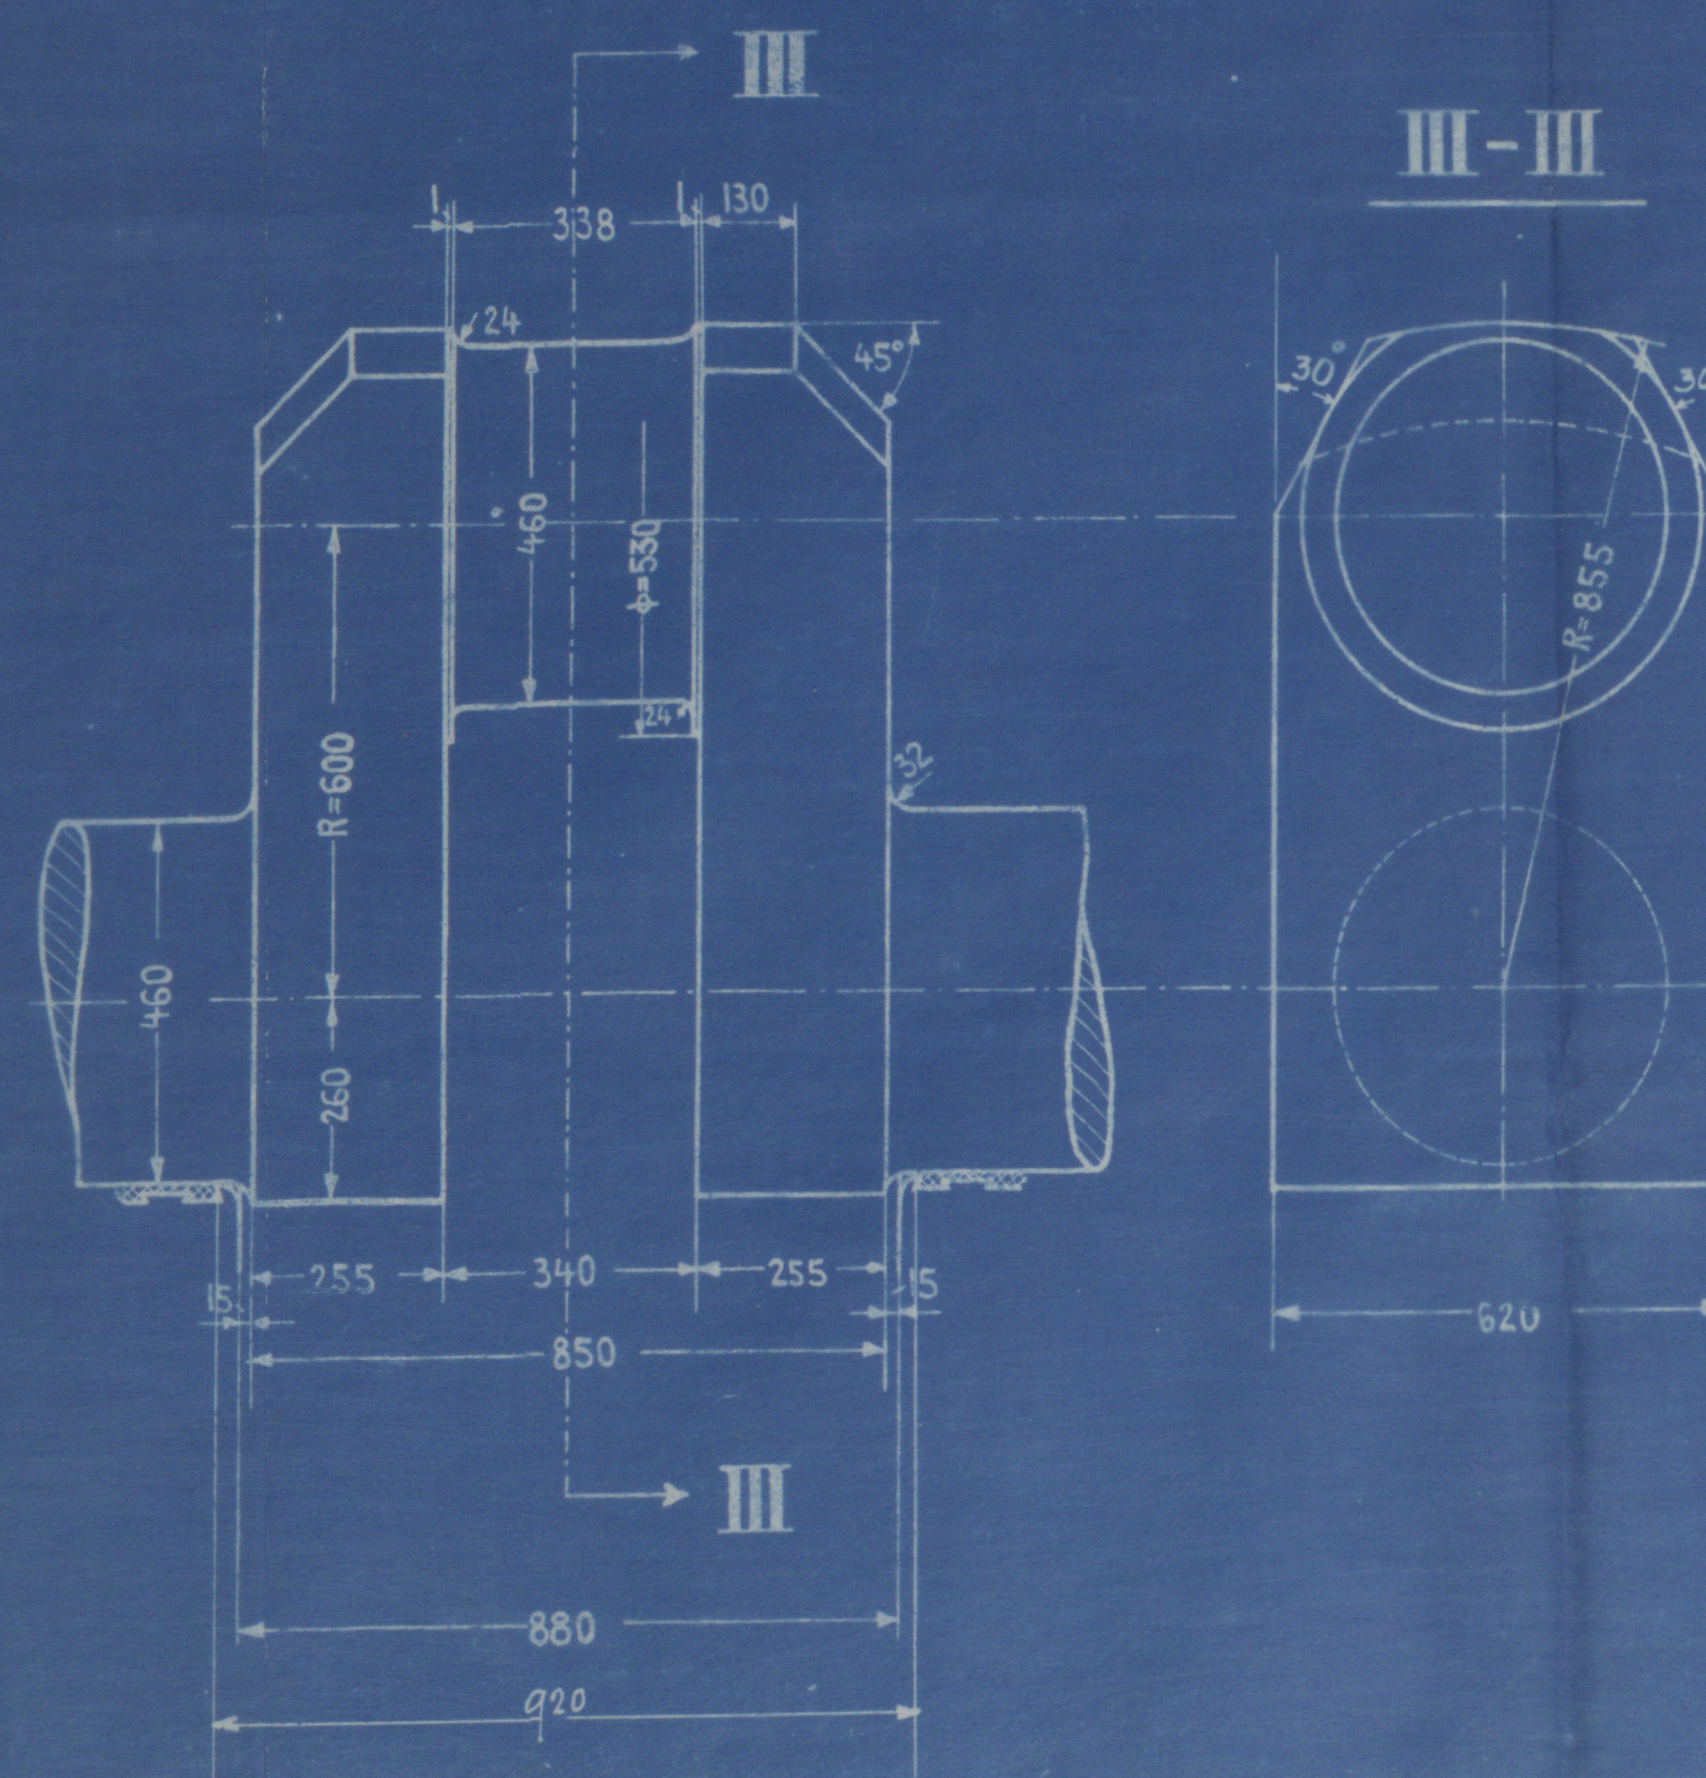

CHECKED BY *M.*  
 DATE 3-5-23.

ARRANGEMENT OF CRANK SHAFT.

CONTRACT N° 853.

SCALE:-  $\frac{1}{10}$ ,  $\frac{1}{20}$ .



*16.5.23*



CHECKED BY W.  
DATE 3-5-23.

ARRANGEMENT OF CRANK SHAFT.

CONTRACT N° 853.

SCALE:-  $\frac{1}{10}, \frac{1}{20}.$

*Ref 14.5.23.*



*16.5.23*

THE WALLSEND SLIPWAY & ENGINEERING Co., Ltd.  
Enclosure to  
*Lloyd's Register*  
W644-0037 1/2

*W644 - 0037 1/2*

23369



Lloyd's Register  
Foundation



Wallsend Slipway's C. 853-  
C. 853 crankshaft.

Wallsend Slipway & Eng. Co. Ltd.

Solid Crankshaft.

S. S. ENTON  
NEWCASTLE ON TYNE.

Report No. 78921

RECEIVED

W644-0037



© 2020

Lloyd's Register  
Foundation