

N° 50.


# PROFILE & DECK PLANS.

DIMENSIONS:- 375'-0" B.P. x 52'-3 3/4" MLD x 28'-3" MLD TO 2<sup>ND</sup> DECK, 36'-3" TO UPPER DECK.

TO CLASS 100 A.I. WITH FREEBOARD AT LLOYDS.

SCALE 1/8" = 1'-0"

MILLAR SYSTEM OF SHIP CONSTRUCTION (PAT) LTD.

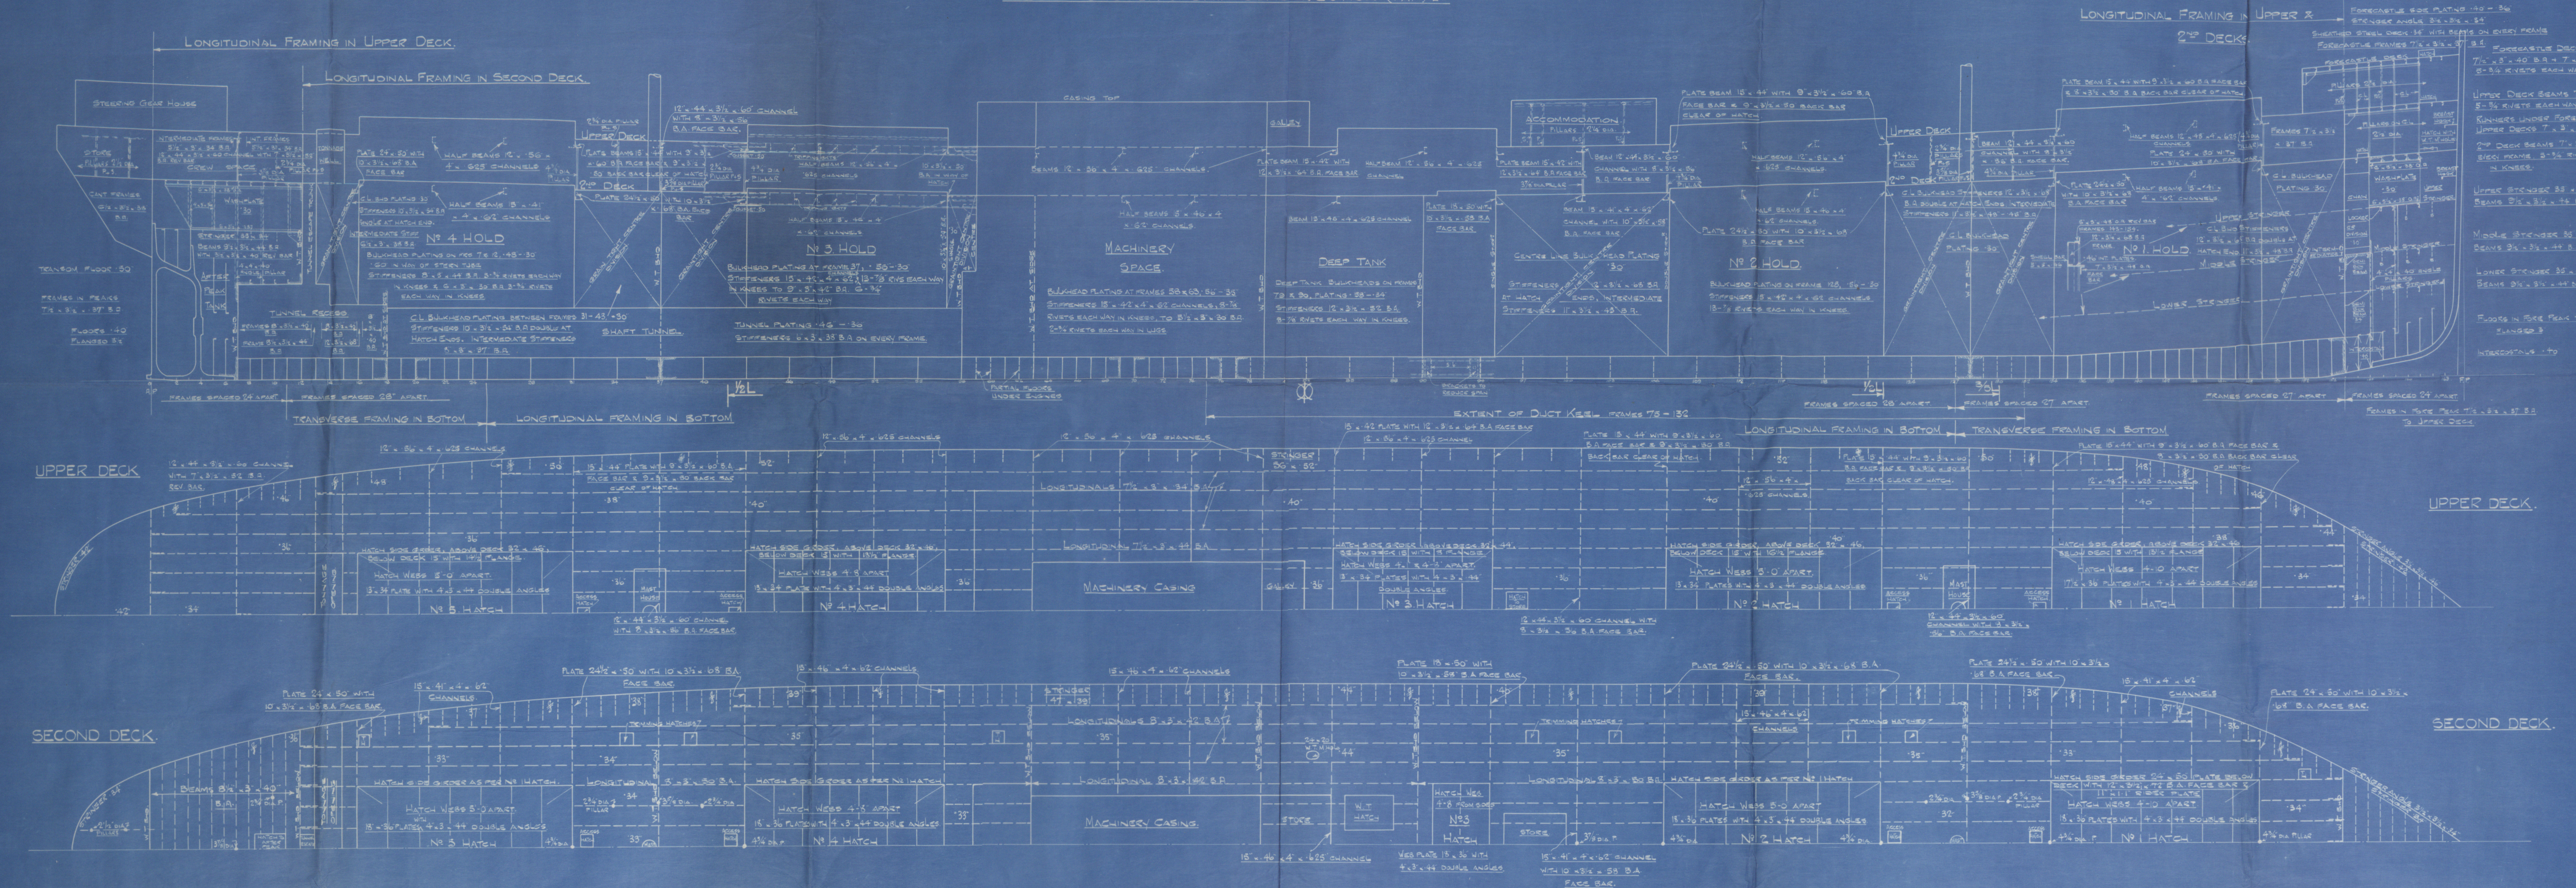

WILLIAMS STEELWORKING CO. LTD.  
 SHEET NO. 10115  
 10-1-1915

10-1-1915



Furness Shipbuilding Co's

N<sup>o</sup> 50

---

Profile and Deck  
(as built)

"S. S. ENTON"

---

Mat Ref 12181

---

