


NOTE :- PLATING SHOWN JOGGLED OR
BOTTOM FRAMES, SIDE FRAMES, & LONG BULKHEAD STIFFERS
JOGGLED IN LIEU OF PLATING.
DRAIN HOLES IN ALL BOTTOM CHANNEL FRAMES
1 1/2" x 3/4" (ELONGATED HOLE) SPACED 18" APART.

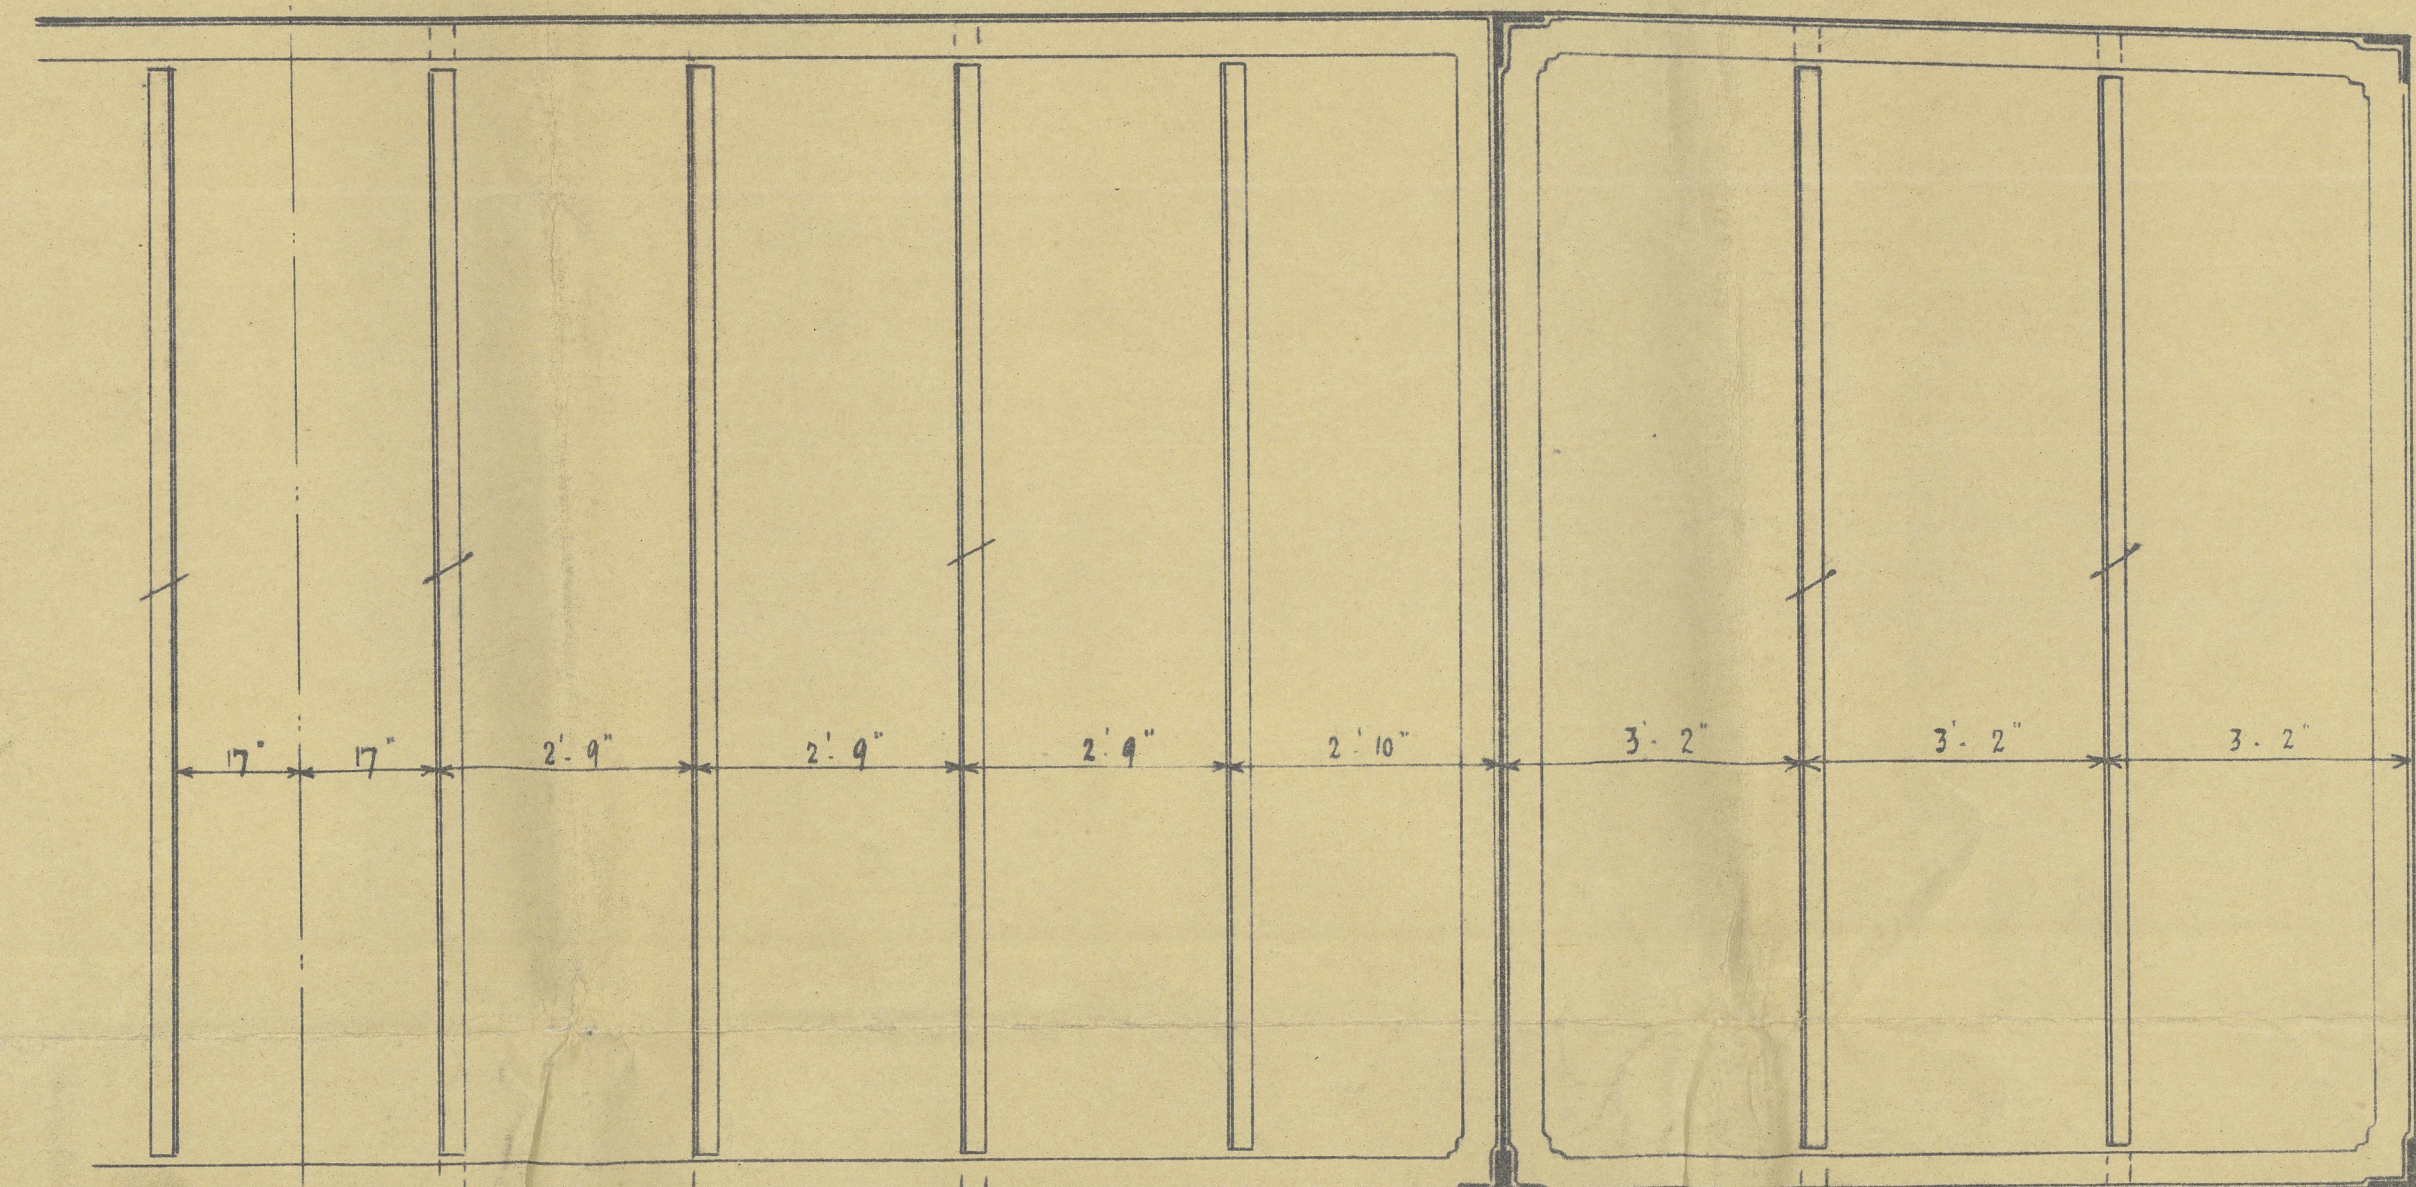

BULKHEAD PLATING 12 1/2 LBS STIFFERS SPACED AS SHOWN
BOUNDARY ANGLES DOUBLE 5" x 3" x 3/8 ANGLES 5" TO BMD

STIFFENERS IN WAY OF F.W. TANKS 6" x 3" x 3/8 BA.
SPACED 24" APART WITH BRACKETS AT
ENDS AS PER RULE PLATING 32

TRANS. W. T. BULKHEAD.

~ SECTIONS ~

CONTRACT No. 581.

STEAM DIPPER DREDGE.

TO CLASS LLOYDS 100 A. "DREDGER" FOR HARBOUR SERVICE

PRIN. DIMS: 125'-0" MLO. LTH. x 44'-0" x 12'-0" D. MLO.

SCALE 1/2" = 1'-0"

EQUIPMENT. SEE LETTER.



29.10.30

Lloyd



© 2020

Lloyd's Register
Foundation

W644-0125

1

581 9582

Midship Section

DREDGER "CYCLOPE"
NEWCASTLE ON TYNE.

Report No. 87060.

DREDGER "DRAGON".
NEWCASTLE ON TYNE.

Report No. 87420

RETAIN



© 2020

Lloyd's Register
Foundation

W644-0125