

Lloyd's Register of British & Foreign Shipping.

(Report on Vessel No.

Port

Newcastle

No. 9435

SHIP FORGINGS OR CASTINGS.

I have to report that the undermentioned Iron or Steel Forgings or Castings, manufactured by Hawthorn, Leslie & Co. Ltd. of Hebburn-on-Tyne for the Vessel No. 412, being built by Hawthorn, Leslie & Co. Ltd. of Hebburn-on-Tyne have been inspected by me as set forth below, and found to be, so far as can be seen, Sound

New Sp. B.R. as per Approved plan

Mark on Forgings.

Lloyd's

No 3865-N
N.C


W Campbell

Newcastle

23-8-06

	STERN FRAME.	RUDDER FRAME.	STEM.
Material*	Scrap	Scrap	Scrap
How made	Forged & Smithed	Forged & Machined	Forged & Smithed
Dimensions	11 x 7	9 1/2	11 x 3
Progress on Inspection	Forging & Smithing	Machined & Built	Finished
Date when Inspected	February 7-13 12-3-06. 5-4-06	April 5 to August 14-1906	March 12-1906

SKETCHES OF FRAMES SHOWING POSITION AND DESCRIPTION OF WELDS OF FORGINGS, OR PARTICULARS OF TESTS APPLIED TO CASTINGS.

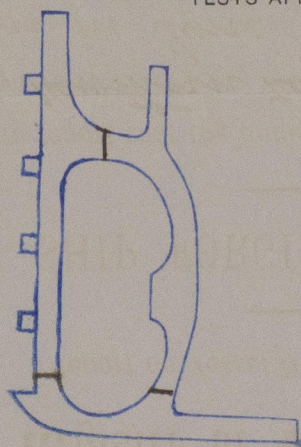

Fee (if any chargeable) £

To be paid at



© 2021

Lloyd's Register

Foundation

* If of Iron, state whether scrap or puddled Iron.

Messrs. Hawthorn Leslie & Co. Ltd.,

S.S. No. 412.

Stem and Rudder Frames and Stern

S.S. Port Augusta

Newcastle Report

No. 51604



© 2021

Lloyd's Register
Foundation