

Received at

Office

MON. 8 OCT 1906

190

Lloyd's Register of British & Foreign Shipping.

(Report on Vessel No. _____)

Port

Newcastle

No 9325

SHIP FORGINGS OR CASTINGS.

I have to report that the undermentioned Iron or Steel Forgings or Castings, manufactured by *R. & W. Hawthorn Leslie & Co. Ltd.* of *Hebburn-on-Tyne* for the Vessel No. *411*, being built by *R. & W. Hawthorn Leslie & Co. Ltd.* of *Hebburn-on-Tyne* have been inspected by me as set forth below, and found to be, so far as can be seen, *Sound*

new SpKR. as per approved plan

Mark on Forgings.

Lloyd's

No 3864-N

H.C


McCampbell

Newcastle

27-6-06

	STERN FRAME.	RUDDER FRAME.	STEM.
Material*	<i>Scrap</i>	<i>Scrap</i>	<i>Scrap</i>
How made	<i>Forged & Smithed</i>	<i>Forged & Machined</i>	<i>Forged & Smithed</i>
Dimensions	<i>11 x 7</i>	<i>9 1/2</i>	<i>11 x 3</i>
Progress on Inspection	<i>Smithing</i>	<i>Machined & built</i>	<i>Finished</i>
Date when Inspected	<i>February 7 to March 12-1906</i>	<i>April 5, May 1-2 to June 12-1906</i>	<i>March 6-1906</i>

SKETCHES OF FRAMES SHOWING POSITION AND DESCRIPTION OF WELDS OF FORGINGS, OR PARTICULARS OF TESTS APPLIED TO CASTINGS.

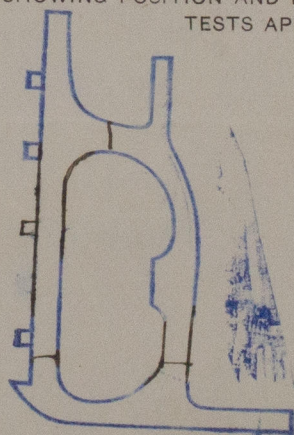

Fee (if any chargeable) £

To be paid at

Messrs. Hawthorn Leslie & Co. Ltd.,
No. 411 Ship.
Stern and Rudder Frames & Stern.



© 2021

Lloyd's Register
Foundation