


Wpck.  
1st March 1909

Note:— Modifications marked in Blue are those  
required by Board of Trade 8-3-09.

Boiler drawings are modified in accordance with  
both Lloyds & B.O.T. requirements

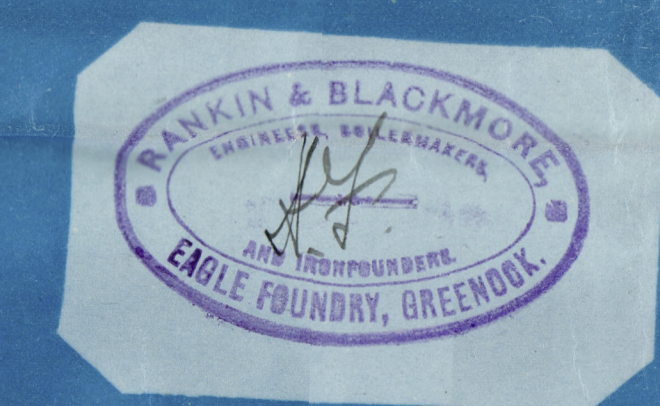

JOE N<sup>OS</sup> 283 - [REDACTED]



N D

Invert-Steel main Boilers

No. 283-4.

by

Rankin & Blackmore

for

Russell & Co. Ltd. 601-2 Vessels.


210 lbs. working pressure.

601. S.S. Highland Rover

Greenock Report No. 15715

602. S.S. Highland Pride

Greenock Report No. 15755

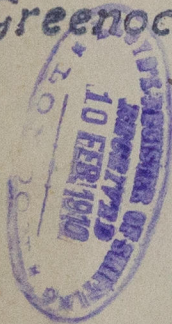

RETAIN



© 2019

Lloyd's Register  
Foundation