


Servizio regolare con grandi piroscafi per gli Stati Uniti, Messico, Antille, America Centrale e ritorno.

STRO-AMERICANA

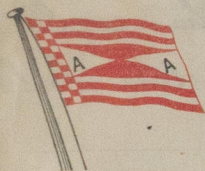

TELLI COSULICH  
TRIESTE

Indirizzo telegrafico:

ULICH - TRIESTE

si usati: WATKINS & SCOTT'S

A B C 4th & 5th Edition.

	Tonn.
Abbazia	4400
Alberta	6400
Anna	3550
Aquileia	4000
Auguste	4650
Emilia	5800
Federica	5800
Hermine	5600
Gott. Schenker	4400
Jenny	4110
Lacroma	4400
Lodovica	5800
Lucia	3500
Margherita	5500
Maria	5200
Marianne	5800
Teresa	6400
Gerty	6000
Clara	6000
Giulia in costr.	5800
Frieda	3200

Genoa  
Trieste, 23/3/04

Marie Ritson Esq  
Surveyor & Lloyd's Surveyor of  
B & F Shipping


Dear Sir

As we intend fitting  
our S.S. 'GERTY' for carrying emigrants we  
should like to have your opinion re. a small  
structural alterations that we propose making  
to the vessel & we wish to know if there  
will be any objection from the side of Lloyd's  
Reg. of B & F Shipping to our proposal, as follows.

In the way of No 3 hold hatch there is a  
well about 52 feet long & the full breadth of the ship.  
this well is covered over with a wood deck laid on  
beams & has a hatchway cut in the deck corresponding  
with the No 3 hold hatch below, this hatchway being fitted  
with wood covers. The present arrangement is as per  
enclosed sketch No 1.

We propose to plate up the sides of this well  
for about  $\frac{2}{3}$  of its length at each side of the ship, &  
inside this space to erect wooden bulkheads shutting  
off about 8000 cub feet space & in this space to construct  
hospital.

We will not interfere in any way with the existing

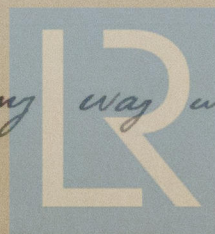

© 2019

Lloyd's Register  
Foundation



bulkheads, the only alterations being, as aforesaid, the  
partial plating up of the open sides of the well  
& the shutting off sufficient space by wooden bulk-  
heads so as to form an hospital.

Awaiting your reply & thanking you in ad-

We are

yours truly

Per Fratelli Gualich

James Stewart

P.S. Would you please send your reply to

Mess<sup>rs</sup> Fratelli Gualich

Via Molin Piccolo

Trieste



© 2019

Lloyd's Register  
Foundation



Servizio regolare con grandi piroscafi per gli Stati Uniti, Messico, Antille, America Centrale e ritorno.

la STRO-AMERICANA




in ATTELLI COSULICH  
TRIESTE

Indirizzo telegrafico:  
ULICH - TRIESTE  
usati: WATKINS & SCOTT'S  
A B C 4th & 5th Edition.

	Tonn.
Abbazia	4400
Albera	6400
Anna	3550
Aquileia	4000
Augusta	4650
Emilia	3850
Federica	3850
Ferrina	3500
Gott. Schenker	4400
Isola	4100
Isopura	4100
Lodovica	3800
Luola	3500
Margherita	5300
Maria	5300
Marianna	5300
Teresa	6400
Gerty	6000
Giulia in costr.	8000
Frieda	8200

showing present arrangement of  
well at No 3 hold hatch

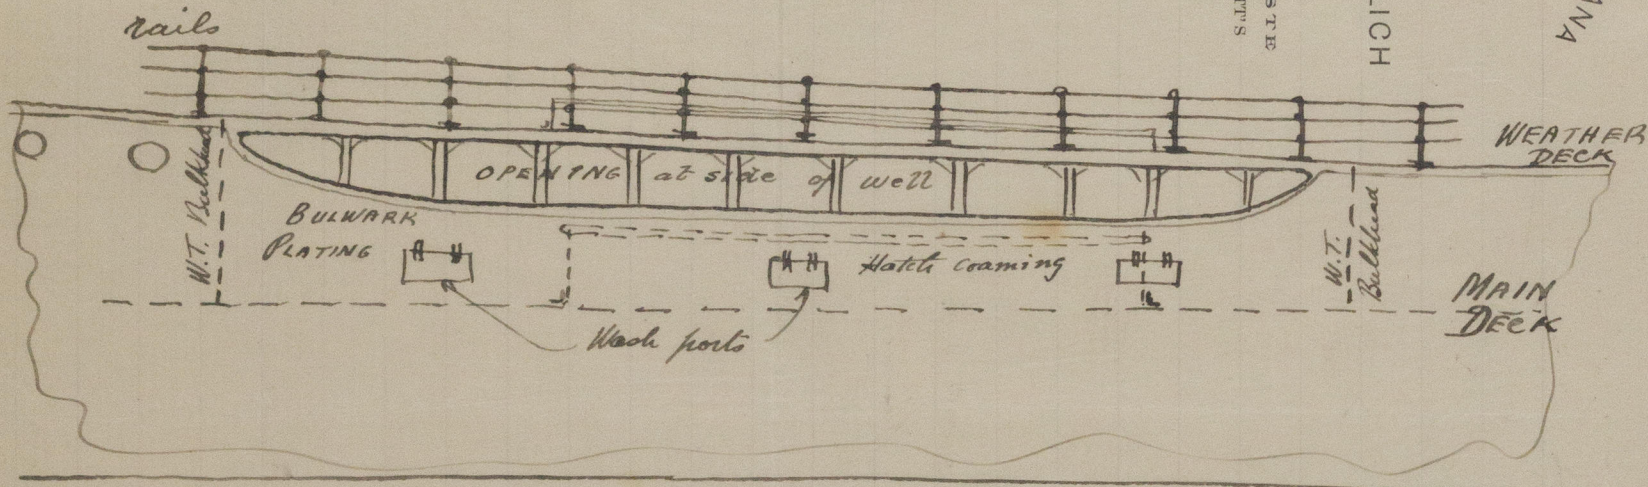

Hatch 26'-0" x 16'-0"

Tricks

W 647-0024




© 2019  
Lloyd's Register  
Foundation



Servizio regolare con grandi piroscafi per gli Stati Uniti, Messico, Antille, America Centrale e ritorno.

STRO-AMERICANA

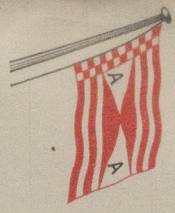



TELLI COSULICH  
TRIESTE

Indirizzo telegrafico:  
CLICH - TRIESTE

Usati: WATKINS & SCOTTS  
A B C 4th & 5th Edition.

	Tonn.
Abbazia . . . . .	4400
Albera . . . . .	6400
Anna . . . . .	3550
Aquila . . . . .	4000
Augusta . . . . .	4550
Emilia . . . . .	5800
Federica . . . . .	5800
Hermine . . . . .	5800
Gott. Schenker . . . . .	4400
Jenny . . . . .	4110
Laetitia . . . . .	4400
Lodovica . . . . .	5900
Lucia . . . . .	3550
Margherita . . . . .	5500
Maria . . . . .	5200
Marianne . . . . .	5800
Teresa . . . . .	6400
Gerty . . . . .	6000
Clara . . . . .	6000
Giulia in contr. . . . .	5900
Brieda . . . . .	8200

showing proposed partial plating  
up of sides of well & bulkheading  
off with wood divisions about 8000 cub feet  
of space under the deck to serve as  
hospital for emigrants

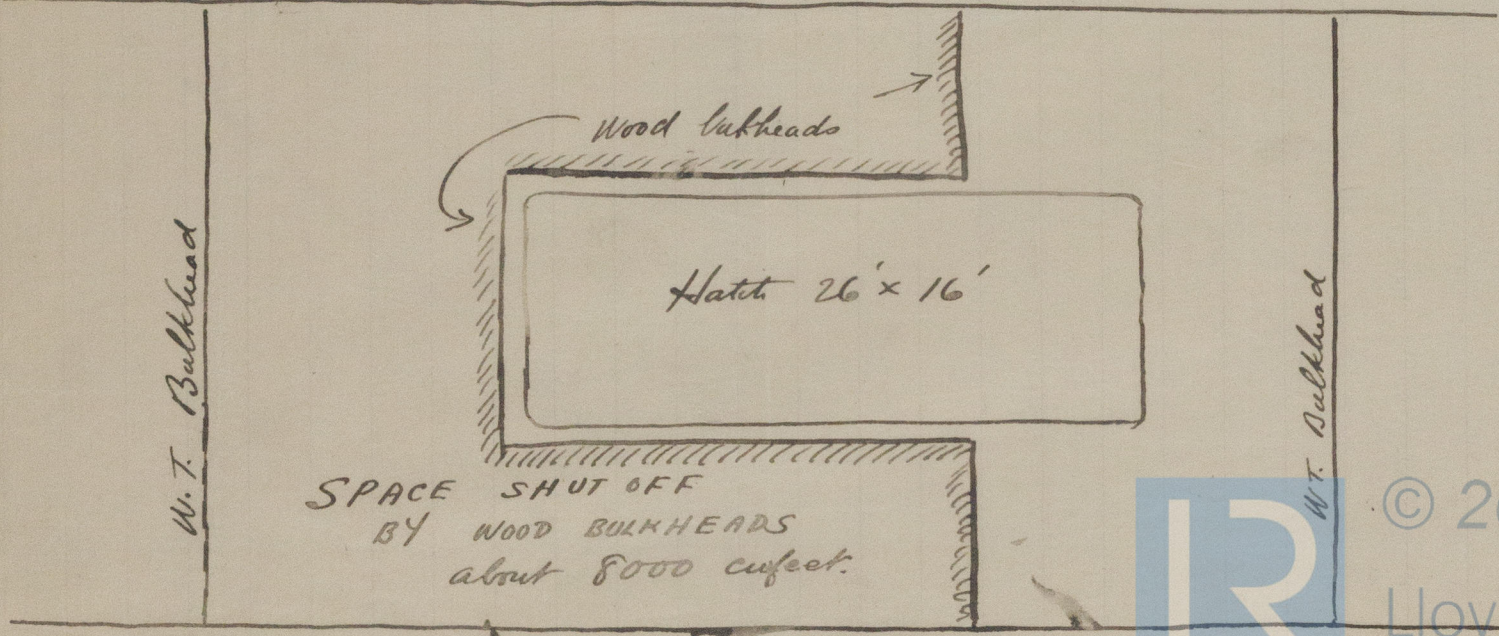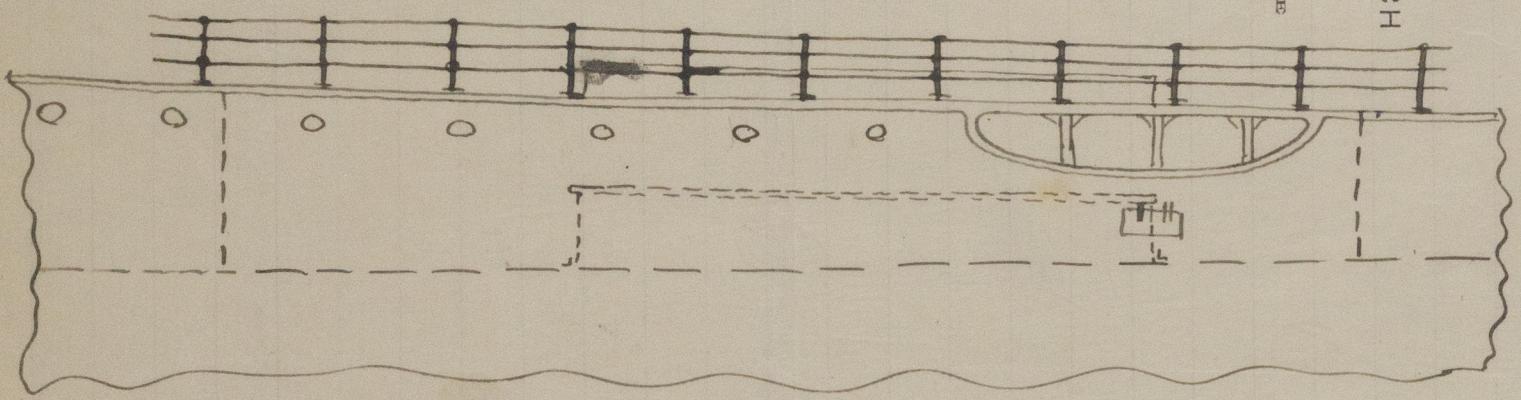

W.T. Bulkhead

W.T. Bulkhead

Trieste

SPACE SHUT OFF  
BY WOOD BULKHEADS  
about 8000 cub feet.

W64700293  
3/13