


- 5. D . 28.91

PLATFORM DECK OVER WELL

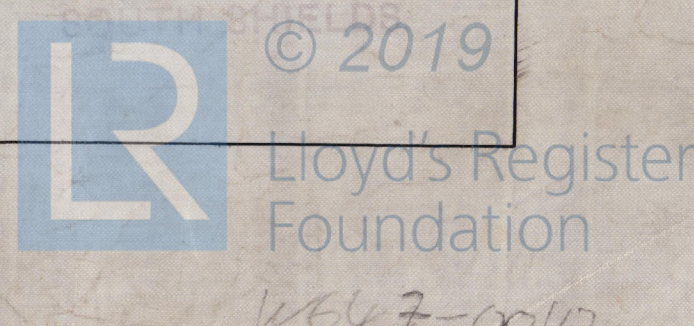

Messrs J. Readhead & Sons

Amende d.

Midship Section

49. Genby

Newcastle Pochoff

454014

Lloyd's Register
Foundation

W647-0047