

11-12  
2006 + amended  
No 222.222 222  
2006 + amended  
2006 + amended

PLAN No. 2963  
FOR ENCLOSURE TO  
Messrs Lloyd's Surveyors  
Hull FROM  
COCHRANE & SONS, LTD.  
SHIPBUILDERS, SELBY.  
DATE 10/6/13.

2232  
Messrs Lloyd's Surveyors  
Hull  
Notes 1/12/12 RK



PROFILE & DECK PLAN

Nos 558-9-67-9-70

SCALE 1/4" = ONE FOOT

✓ PILLARS THROUGHOUT TO SURVEYOR'S SATISFACTION

MAST SUPPORTED  
TO SURVEYOR'S SATISFACTION

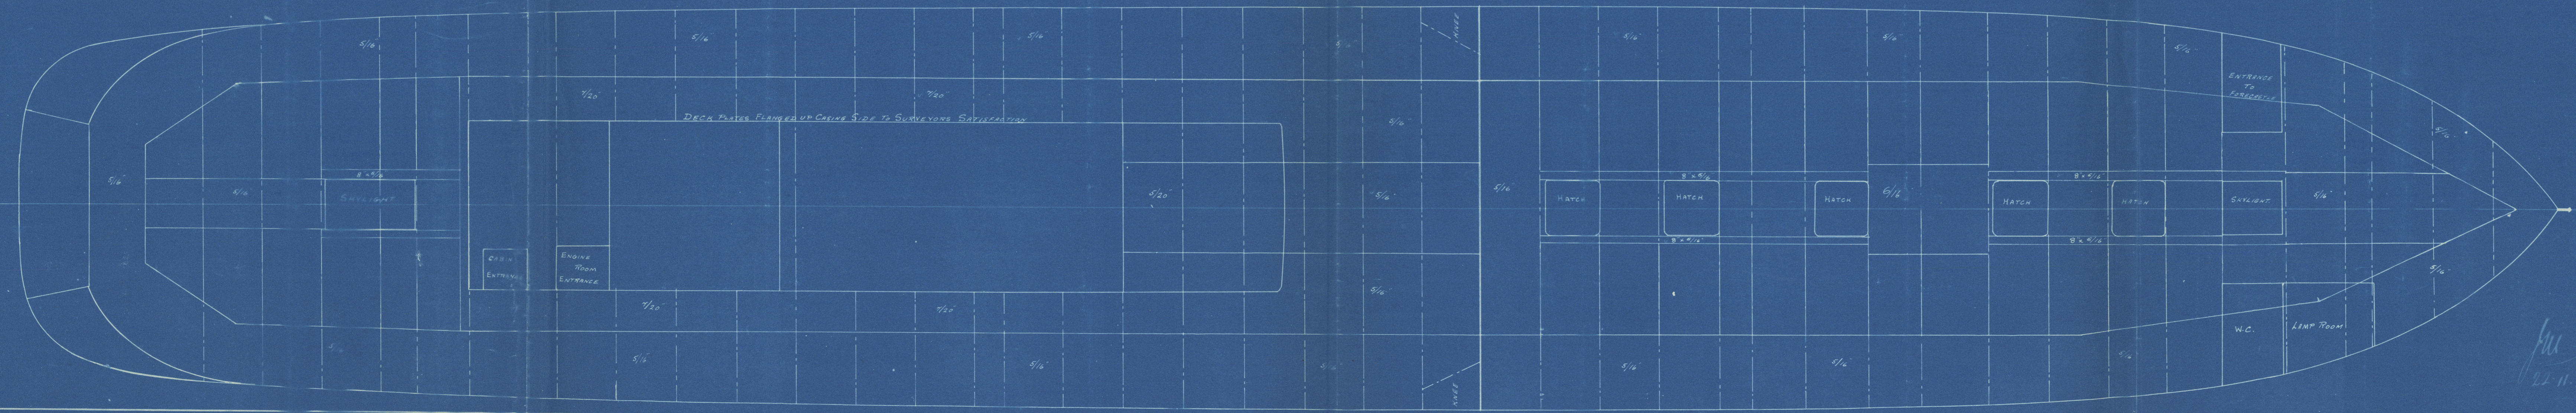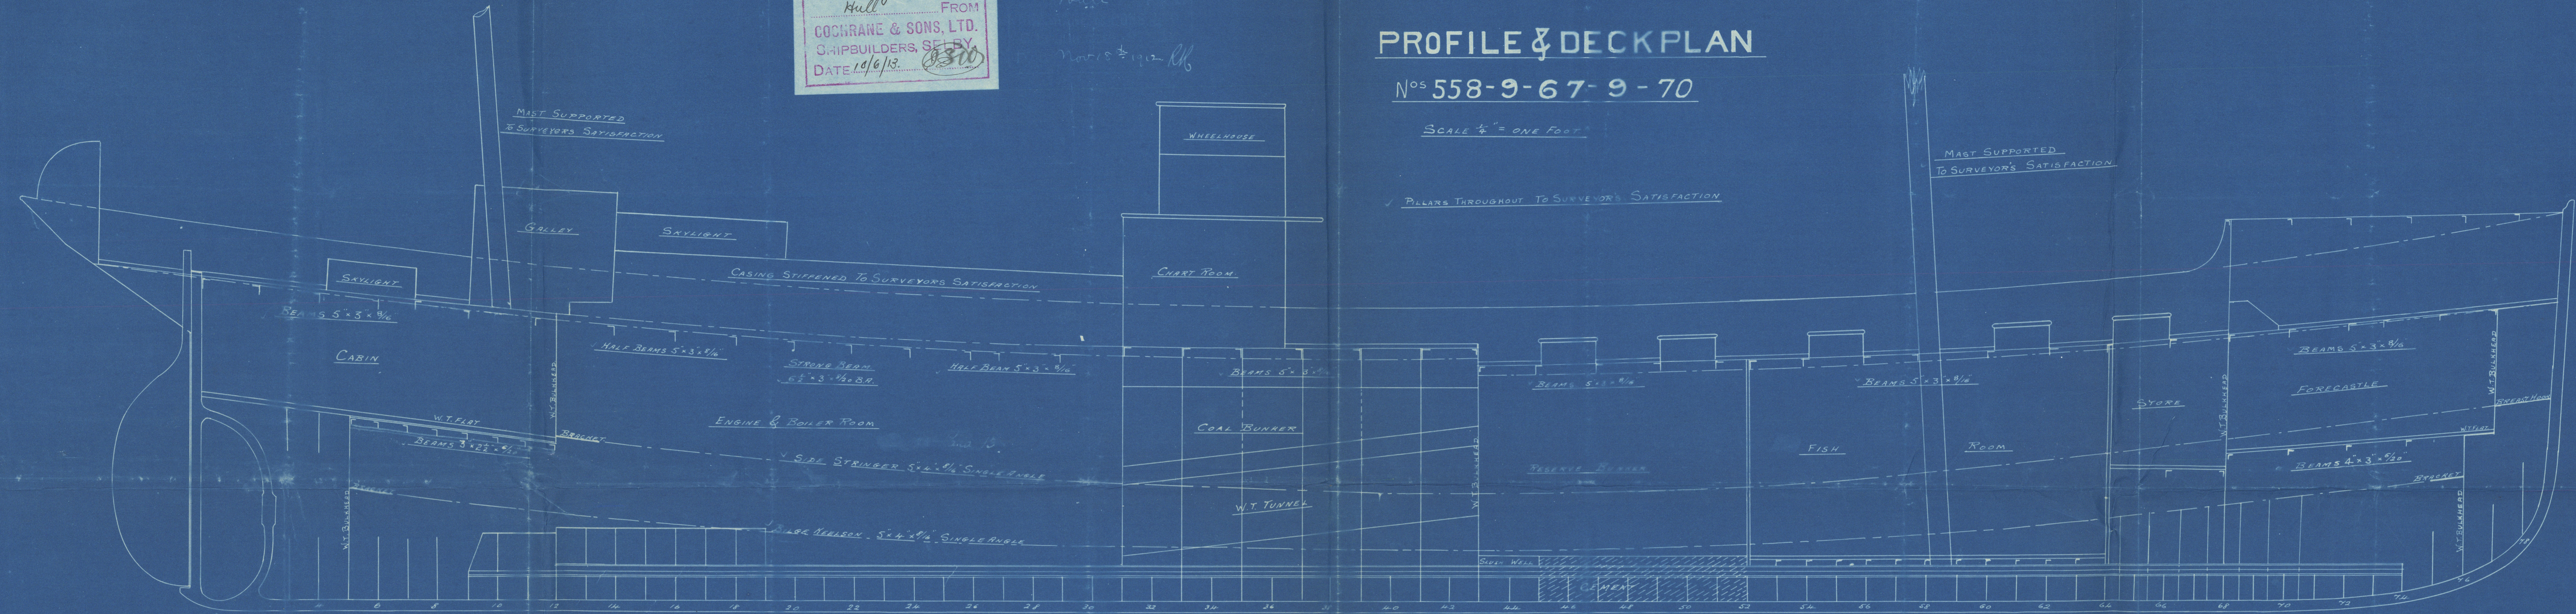


22-11-12

Cochran & Son  
Nos 558.559.567.569.570.

Duplicate  
Profiles and Decks.

Isle of Scott	Hull Rpt No: 26336
Blackleton	" " " 26380
Lord Lansdowne	" " " 26457
Elf King	" " " 26829
Leary	" " " 26888

RECEIVED

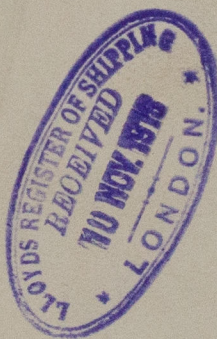

© 2020

Lloyd's Register  
Foundation

W648-0090