

22.11.12

Messrs Lloyd's Register  
Hull

Messrs 1712 RK

# MIDSHIP SECTION

STEEL SCREW TRAWLERS


N<sup>o</sup> 558-9-67-9-70

DIMS LEN 133'-4" x 23' 0" EX x 12'-9" DEPTH MOULDED

SCALE 1/2" = ONE FOOT

PLAN No. 2962  
FOR ENCLOSURE TO  
Messrs Lloyd's Register  
Hull FROM  
COCHRANE & SONS, LTD.  
SHIPBUILDERS, 21 BY.  
DATE 10/6/13. JSW

TO CLASS 100 A1 FOR FISHING PURPOSES. DECK PLATED OVER IN WAY OF  
MACHINERY SPACE. ENGINE & BOILER CASING AS PREVIOUSLY APPROVED

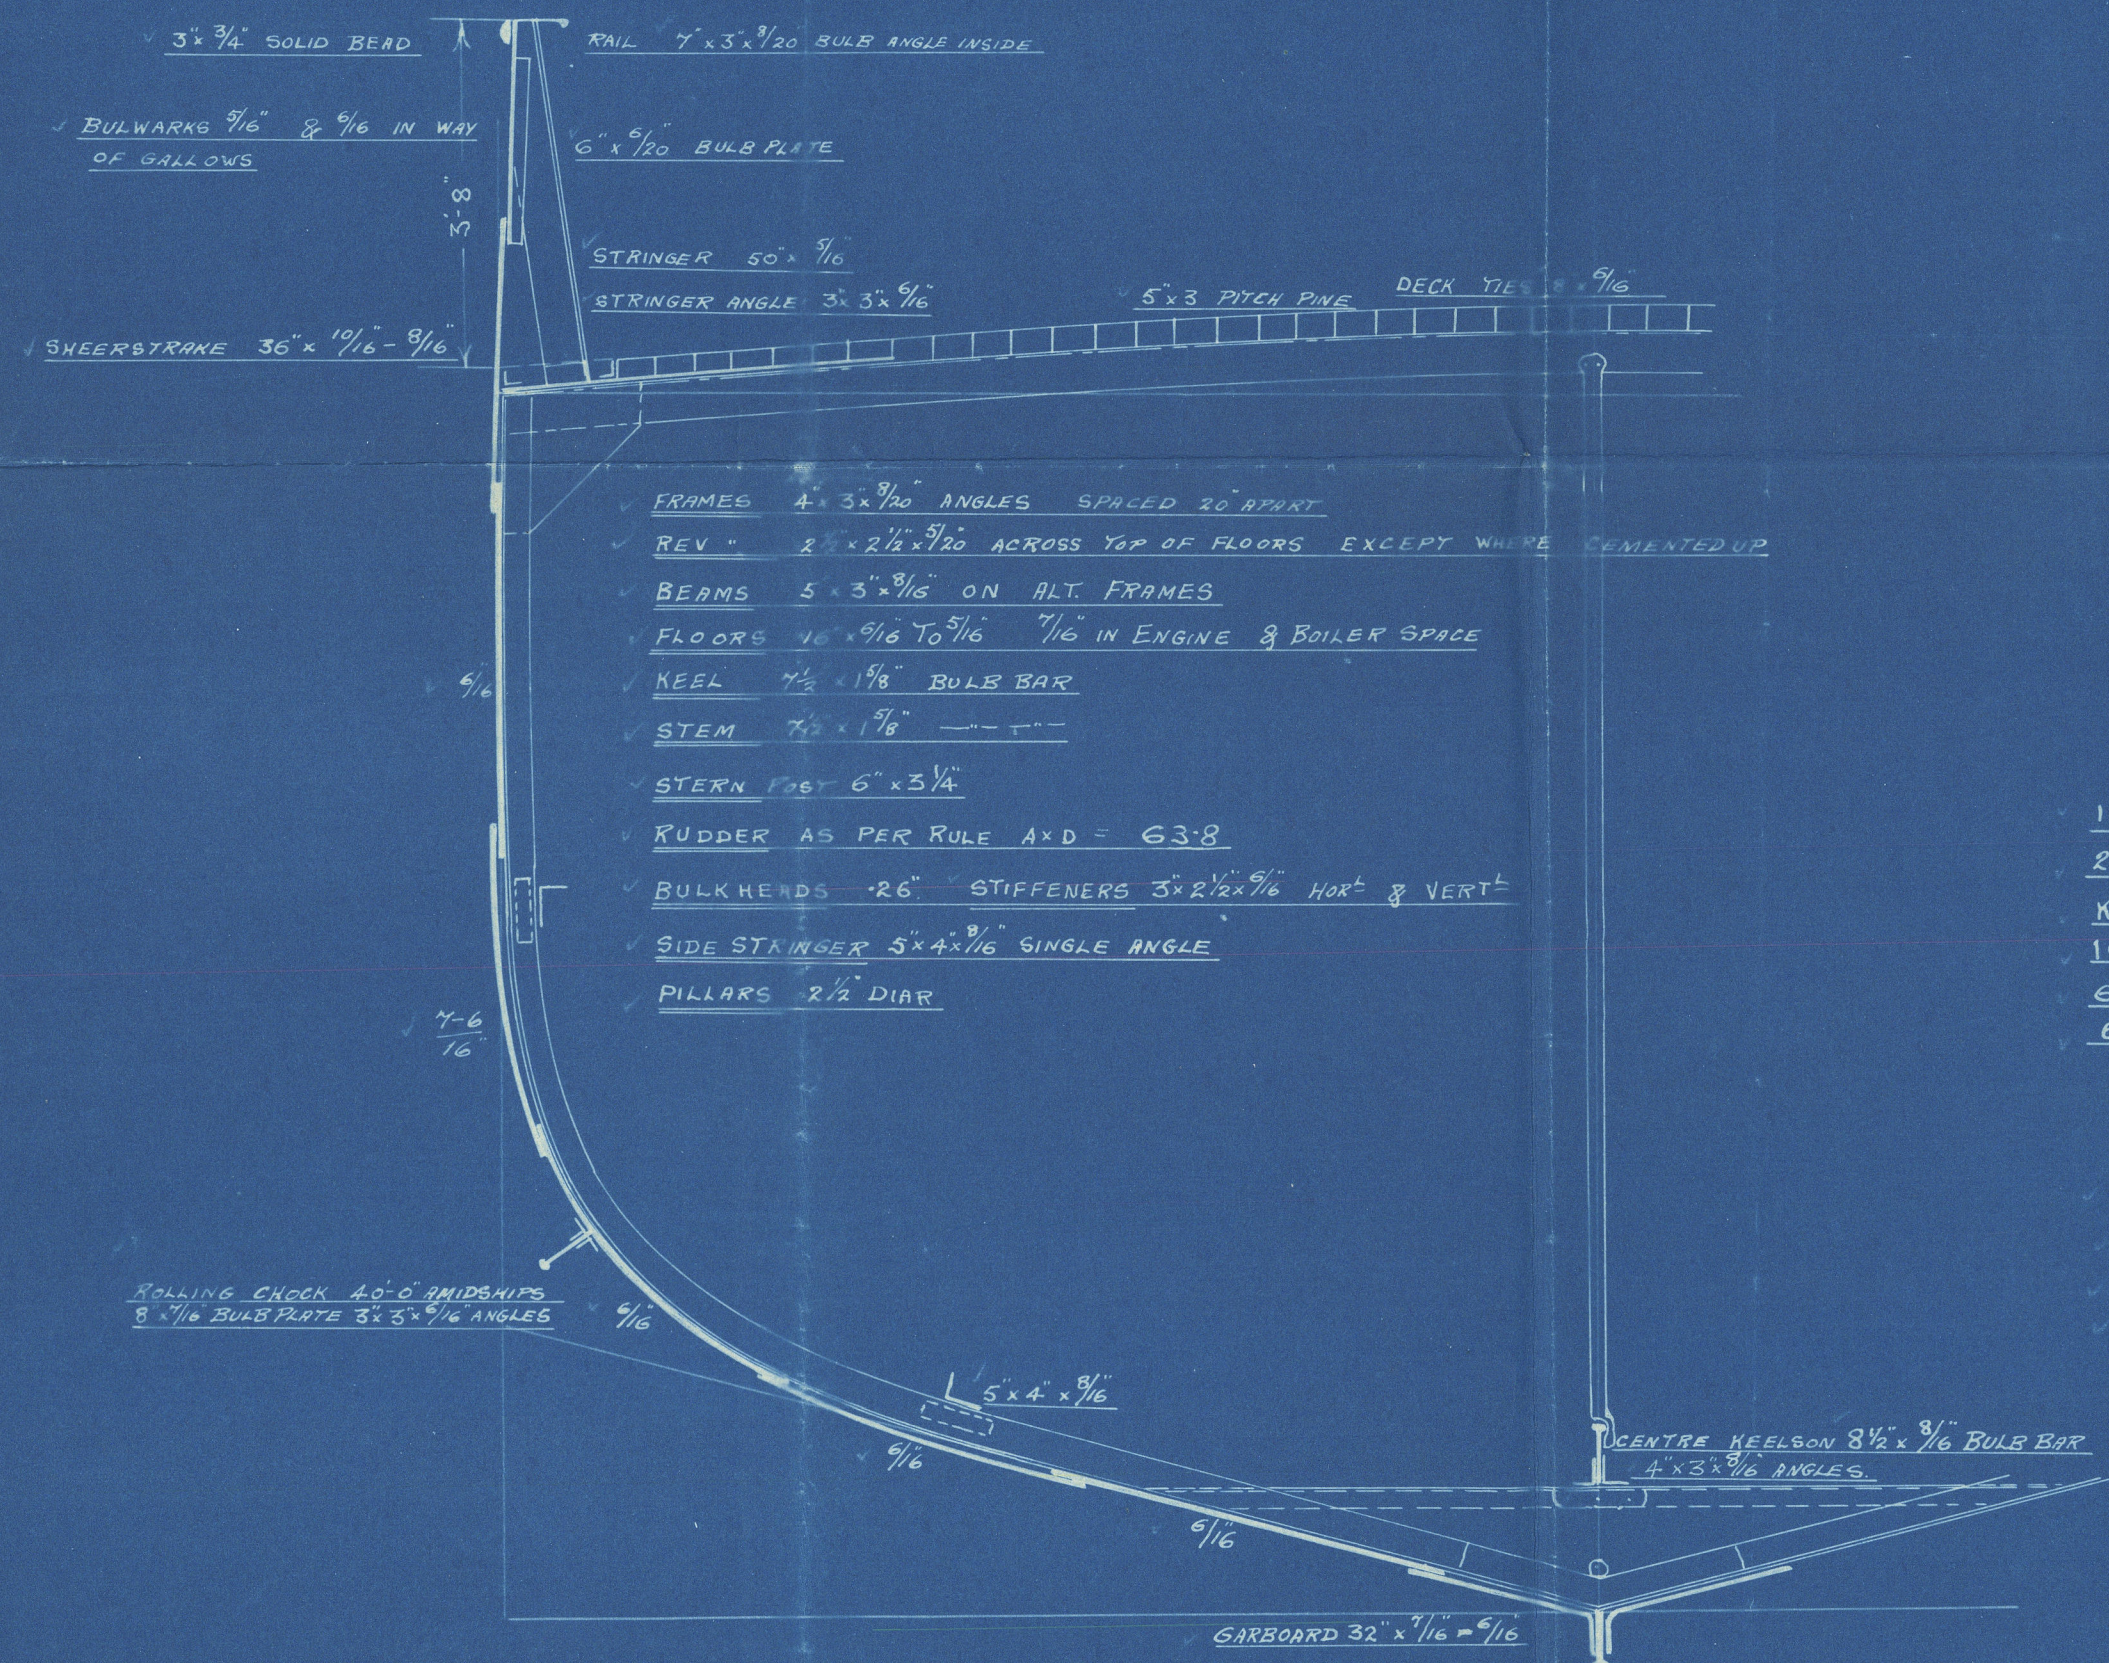

## NUMERALS

B + D = 35.63  
L x (B + D) = 4750.55

## PROPORTIONS

L/D = 10.45  
L/B = 5.85

## EQUIPMENT

1 <sup>ST</sup> BOWER ANCHOR	5 3/4" CWTs EX STOCK
2 <sup>ND</sup> —	5 1/4" —
KEDGE	3" —
105 FATHOMS	1 1/8" CABLE
60 —	6" HAWSER
60 —	5" WARP

## RIVETING

BUTTS OF SHELL PLATING LAPPED & DOUBLE RIVETED  
EXCEPT GARBOARD & SHEERSTRAKE WHICH ARE TO BE  
STRAPPED & DOUBLE RIVETED LANDINGS DOUBLE RIVETED  
BULWARKS SINGLE RIVETED

fw  
22.11.12

Messrs Lloyd's Register  




Cochrane & Sons.  
Nos 558. 559. 564. 569. 570

Wapthick

## Midship Section

1/2 Scott	Hull Rpt No:	26336
Shackleton	" "	26380
Lord Lansdowne	" "	26457
Elf King	" "	26829
Peary	" "	26888

REMAIN

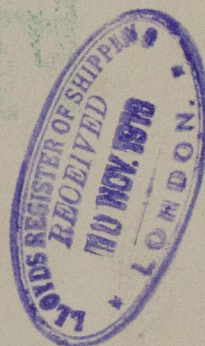

© 2020

Lloyd's Register  
Foundation

W648-0091