


Scale $\frac{1}{2}'' = \text{one foot.}$

25.8.03
5.9.03
18.9.03
6.10.03
14.3.04
21.4.04

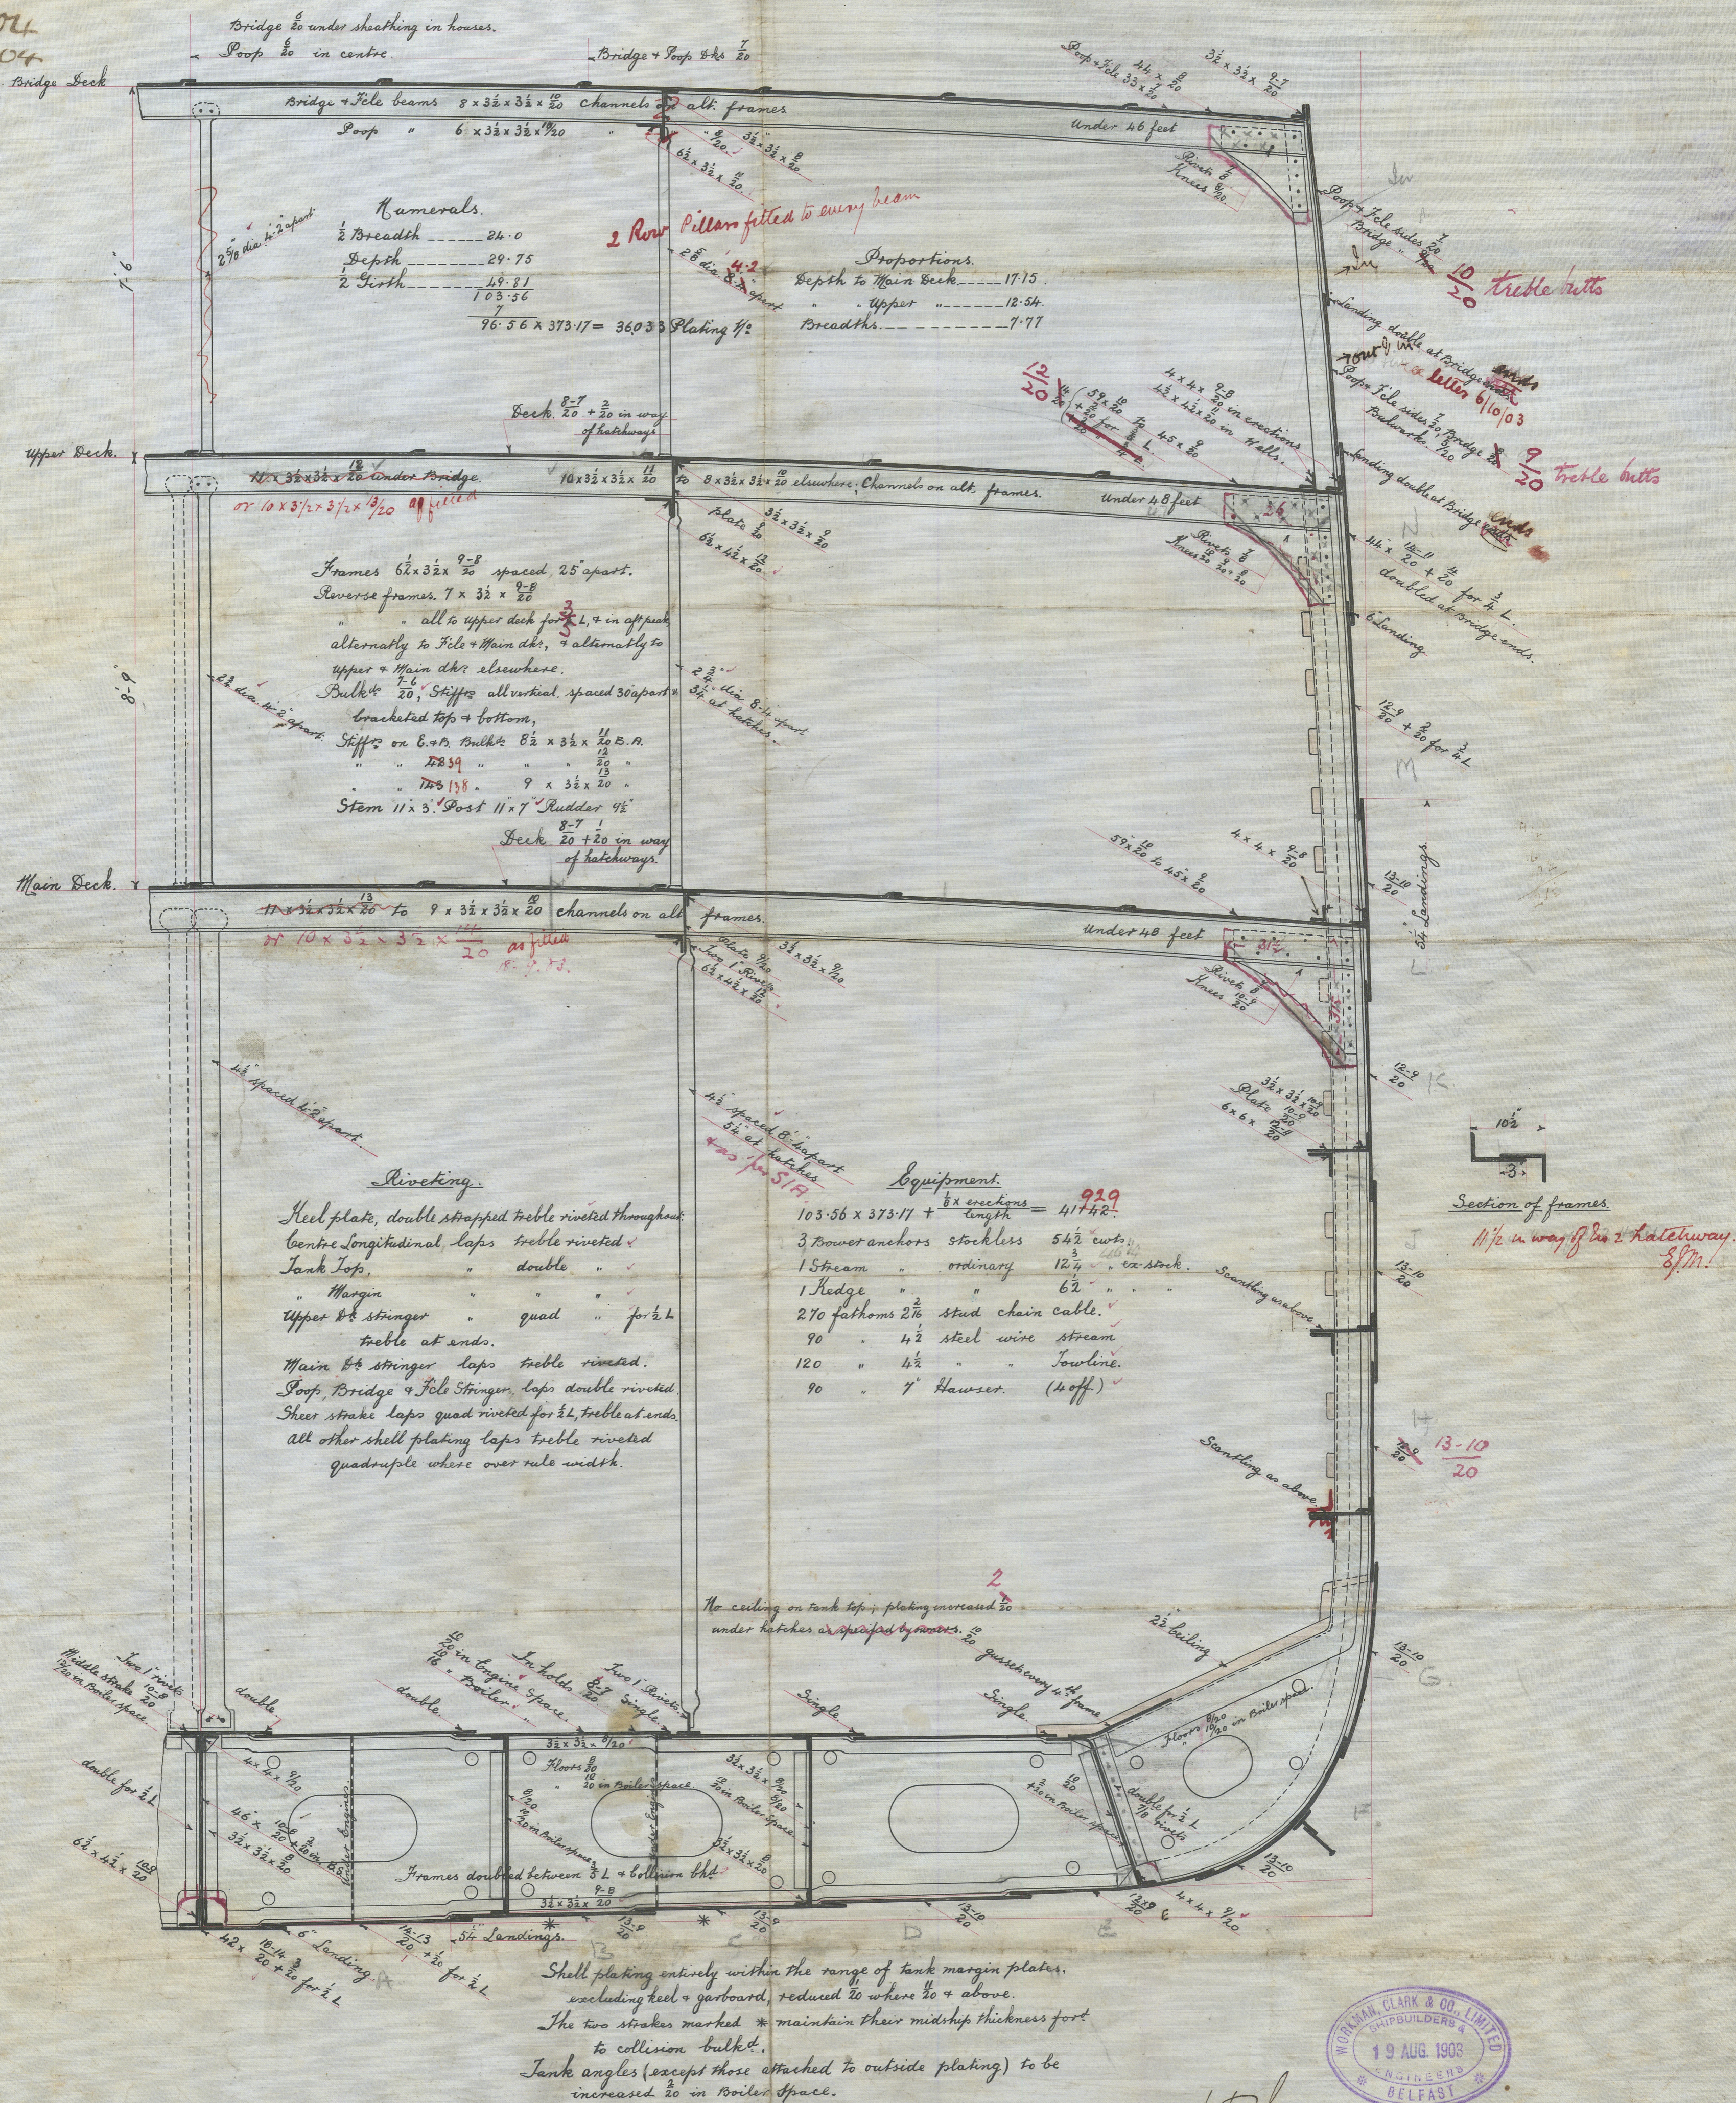

Messrs Workman Clark & Co

S.S. No 204

Midship Section

Royal Mail Steam
Packet Co

S.S. Parana

Parana
Bel. No 5753



© 2020

Lloyd's Register
W640-02174
Foundation