


W649-0216 (1/2)
For Enclosure to
Messrs. Lloyd's Surveyors.

Longitudinal Section No 209 S.S.

Scale 1/8 inch = 1 foot.

As Built.

Horizontal Class 800
502.22
Profile plan shown
on no. 209 S.S.
and 10 D.22
2272 of 1881

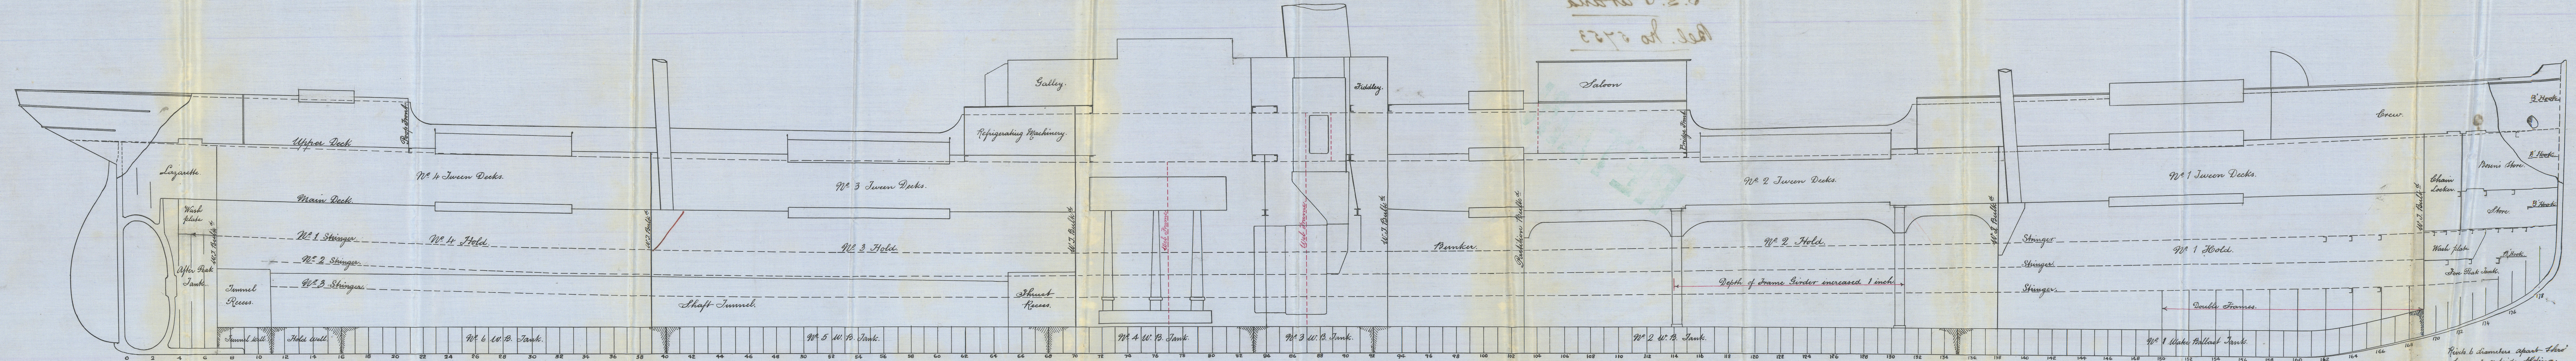

Frames 6 diameters apart thro' frames & plating in tank.

Frames 6 diameters apart thro' frames & outside plating.



W649-0216 (1/2)

Workman Clark & Co Ltd

S.S. 207.

Profile plan showing
lengths of erections as built

S.S. Patana

Bel. no 5753



© 2020

Lloyd's Register
Foundation