

65-0055(12)

Plan of MODIFICATIONS TO PILLARS & GIRDERS
For Enclosure to
Messrs. BRITISH INDIA STEAM
NAVIGATION COY.



MODIFICATIONS TO PILLARS & GIRDERS DUE TO VESSELS
BEING INSULATED

N° 437

NO W. SHERA

N°S 437 to 440. TRUNK TOP TO SHELT' DK.
N°S 436 TO 437 BETWEEN UPPE' & SHELT' DKS. ONLY
FOR GRD' AT MAIN DK. N° 436 SEE SPECIAL PLAN

NOTE: THIS PLAN TO BE WORKED TO IN
CONJUNCTION WITH PLAN OF
"PILLARS & GIRDERS"

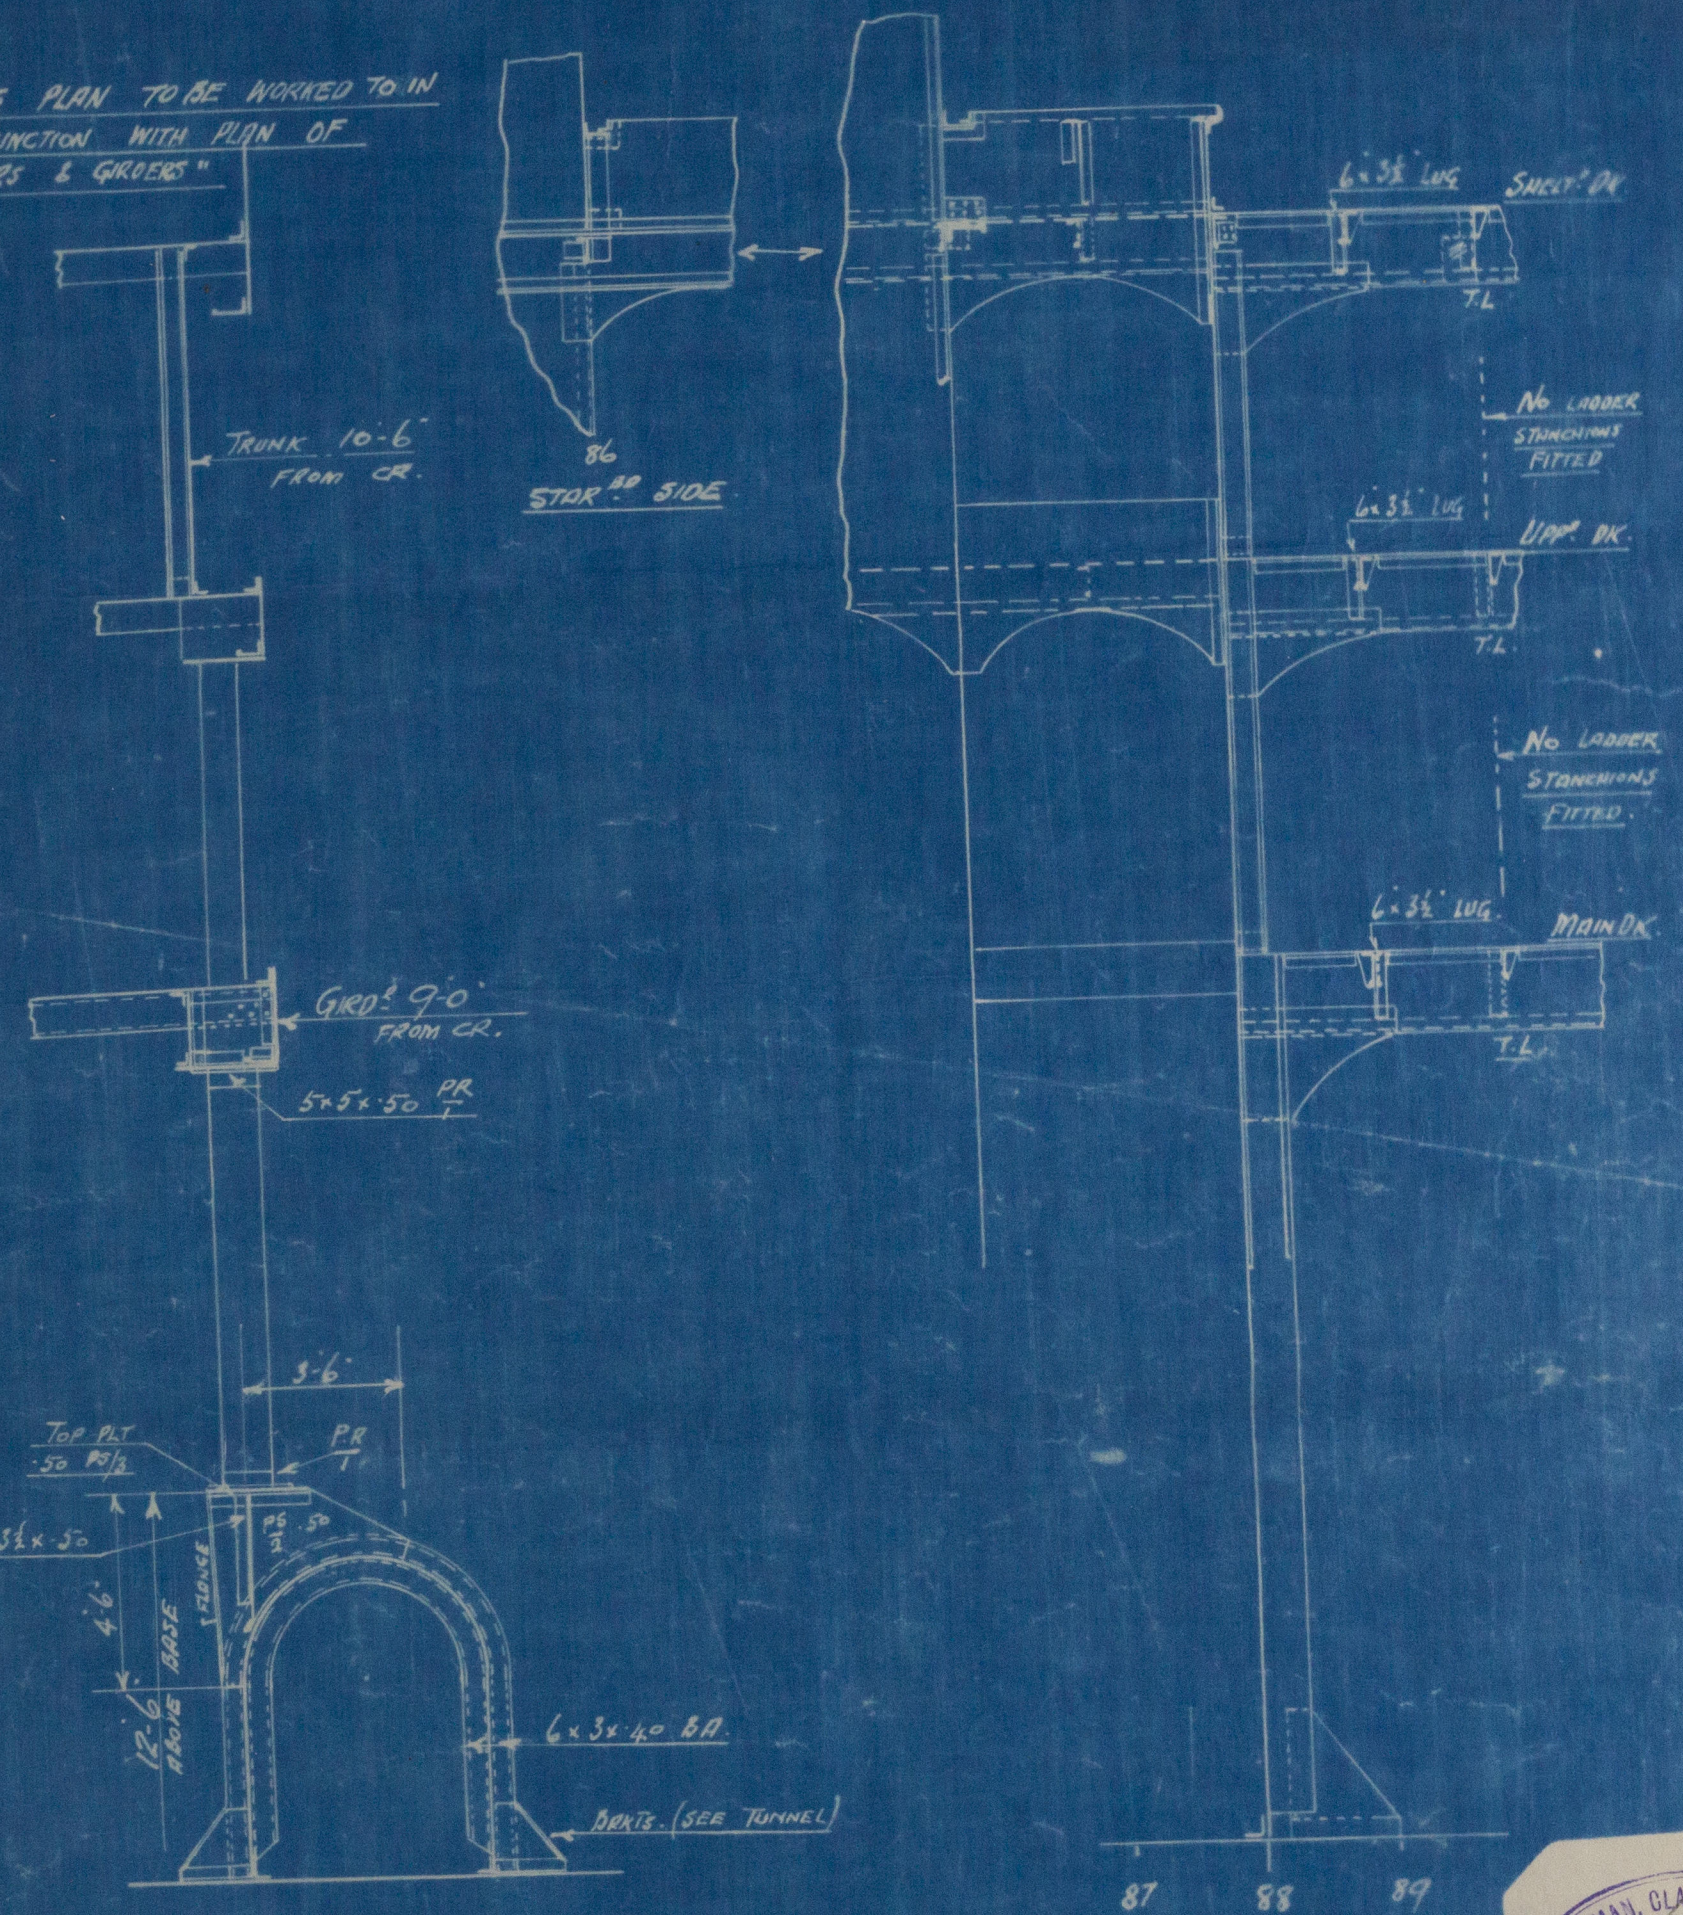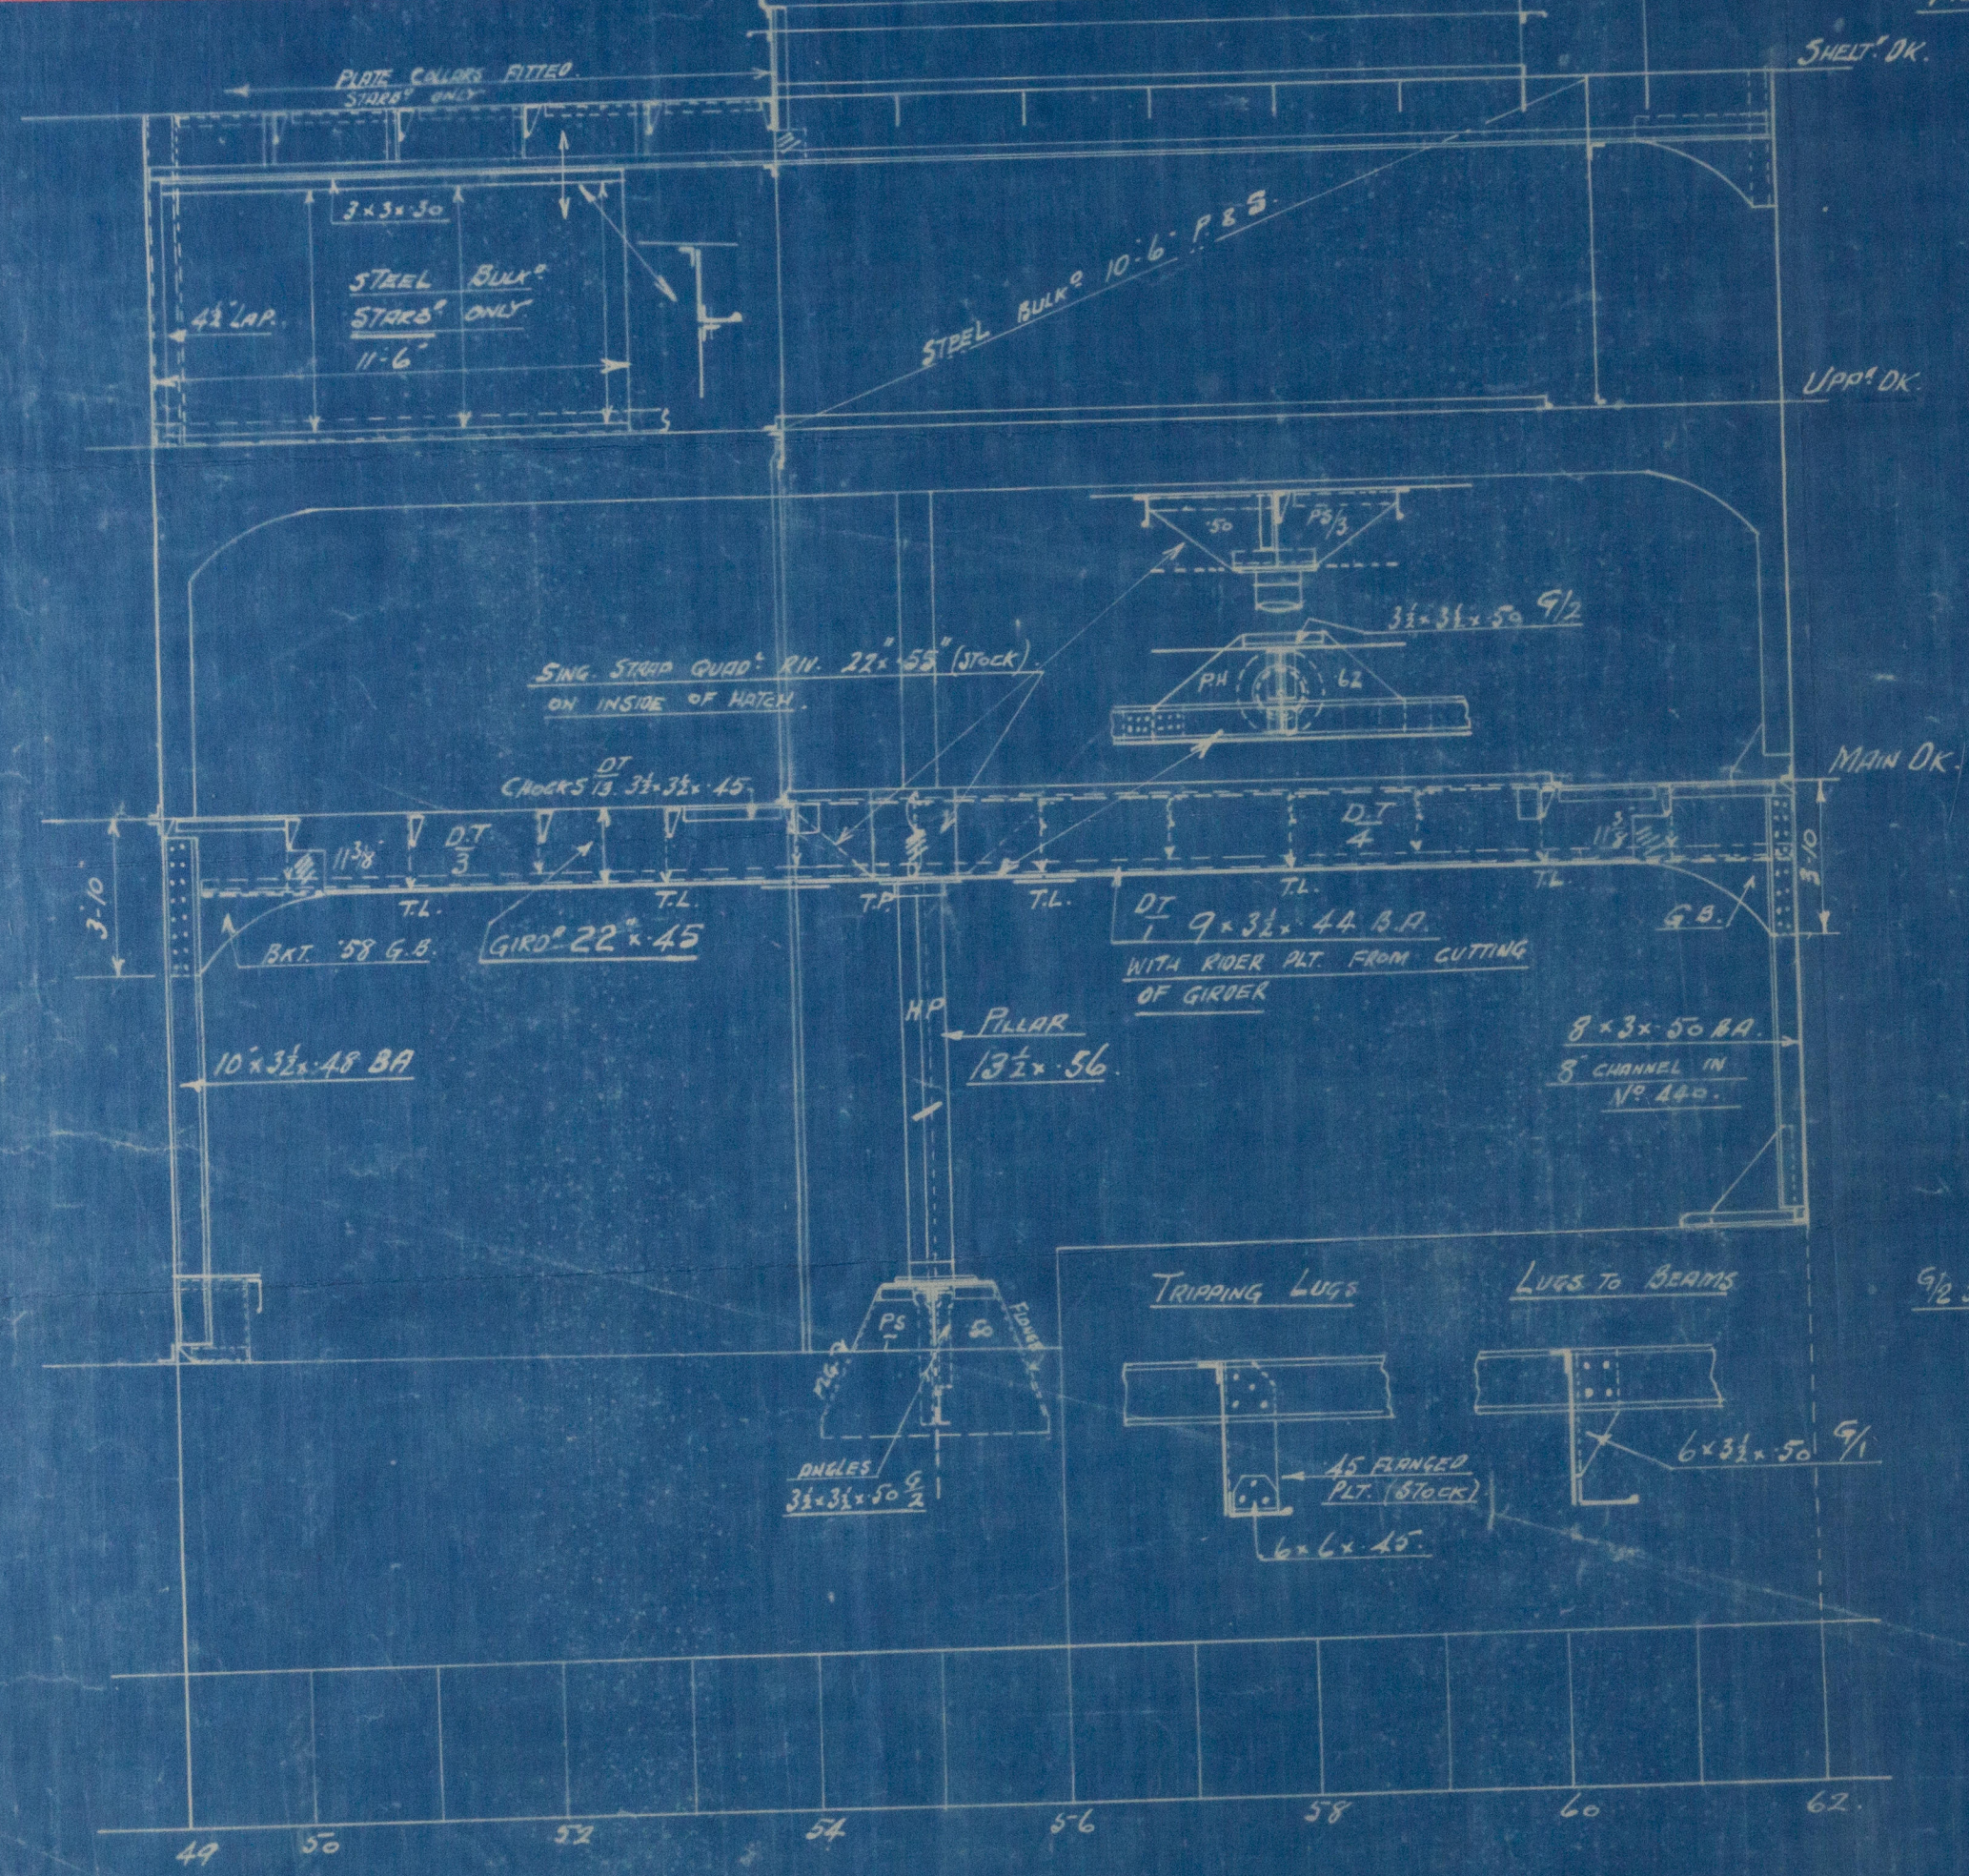

SECTION AT PILLAR
LOOK'G FORWARD

WORKMAN, CLARK & CO., LIMITED
SHIPBUILDERS &
ENGINEERS
BELFAST
13 APR. 1923

65-0055(12)

Rowshera

Modifications to Plans
& Guides;

W/65-0055



© 2021

Lloyd's Register
Foundation