

23.3.07

PROFILE.



SCALE 1/8" = 1 FOOT.

Beams marked A. Built 12" x 30", 1 angle 6" x 4" x 20"
 B. Plate 13" x 30", 4" 6" x 4" x 20" with large gusset.
 C. Beams 12" x 30", Built 2 angles 3 1/2" x 3 1/2" x 20"
 2/3 L. 11" x 30" 2 3 1/2" x 3 1/2" x 20"
 1/2 L. 9 1/2" x 30" 2 3 1/2" x 3 1/2" x 20" or 9 1/2" x 3 1/2" x 20" Channels.
 D. Bridge Deck Beams 10" x 3 1/2" x 20" Built Angles.

Bridge Deck Beams 1/2" x 3" x 20" Built Angles.
 1/2" 6" x 3" x 20"

Upper Deck Beams
 Midship Beams Built Angles 9" x 3 1/2" x 20"
 Half 1/2" x 3" x 20"
 End Beams 2/3 L. 1/2" x 3" x 20"
 Bridge Deck Beams 10" x 3 1/2" x 20" or 9 1/2" x 3 1/2" x 20"
 1/2" 8" x 3 1/2" x 20"

Lower Deck Beams 10" x 30" Built 2 angles 3 1/2" x 3 1/2" x 20"
 End Beams 2/3 L. 8 1/2" x 30" 2 3 1/2" x 3 1/2" x 20"

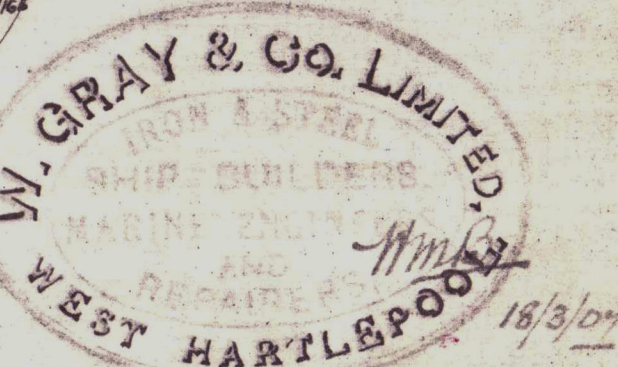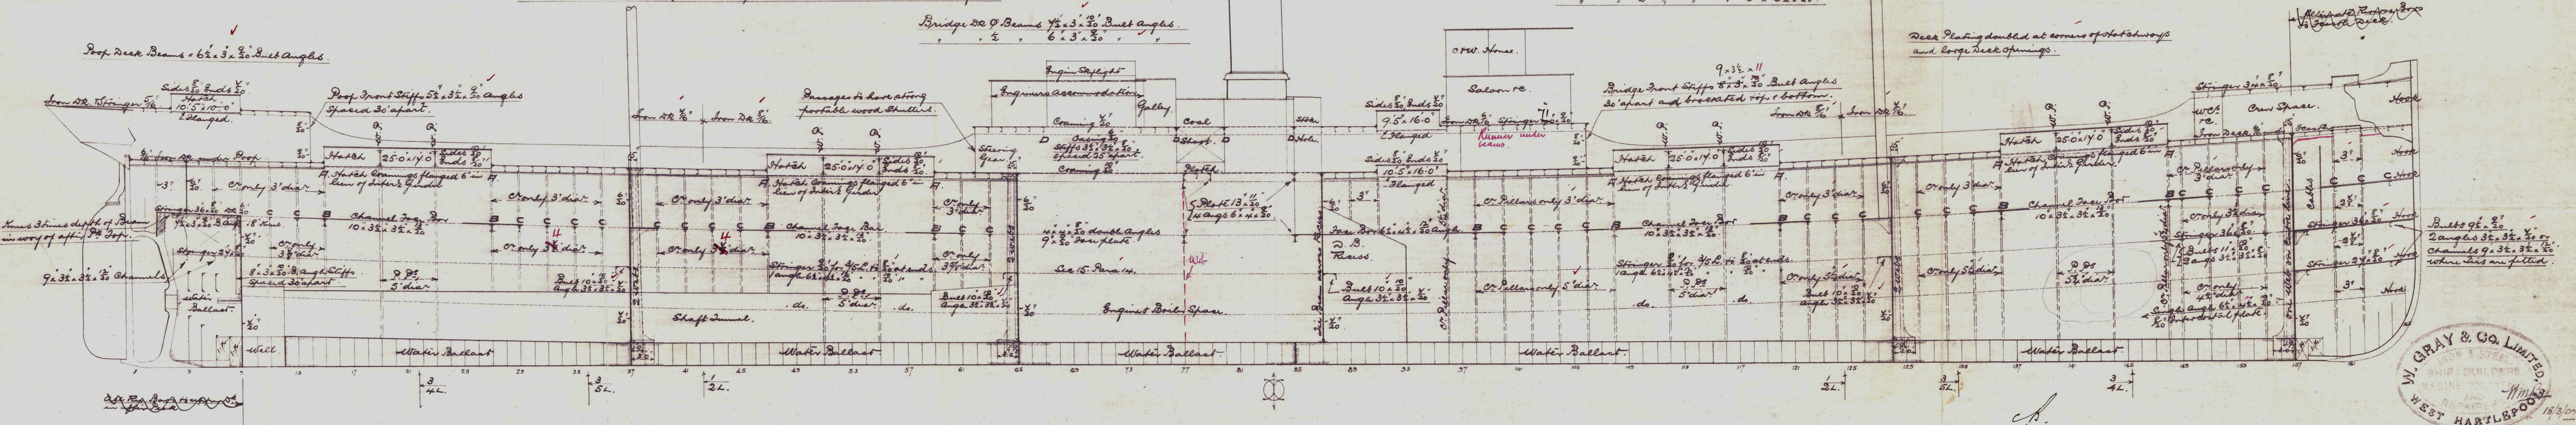

23.3.07

750.

W Gray Cold

No 750

Profile

ss. Maylands.

Hpl Report No. 13350.

WG5-0113



© 2021

Lloyd's Register
Foundation