

Lloyd's Register of British and Foreign Shipping.

(Report on Vessel No. _____ Port *Newcastle-on-Tyne*.)

No. *6577* SHIP FORGINGS ~~OR CASTINGS~~.

The words FORGINGS or CASTINGS, IRON or STEEL, should be struck out as may be required.

I have to report that the undermentioned Iron or Steel Forgings or Castings, manufactured by *Palmer's Shipbuilding & Iron Co. Limited* of *Jarrow-on-Tyne* for the Vessel No. *361*, being built by *J. Readhead & Sons* of *South Shields* have been inspected by me as set forth below, and found to be, so far as can be seen, *satisfactory*.


Mark on Forgings.

Lloyd's
No. *11660B*
T.H.C.

J. H. Cooke
23.4.02.

	STERN FRAME.	RUDDER FRAME.	STEM.
Material*	<i>Scrap</i>	<i>Scrap</i>	<i>Scrap</i>
How made	<i>Forged & smithed</i>	<i>Forged & built</i>	<i>Forged</i>
Dimensions	<i>11" x 5 1/2"</i>	<i>Head 9" Heel 6 1/2"</i>	<i>10" x 2 1/4"</i>
Progress on Inspection	<i>Forged & smithed & machined</i>	<i>Forged & smithed & machined</i>	<i>Forged & smithed</i>
Date when Inspected	<i>July 22nd to Oct 28 1901</i>	<i>Oct 21, 1901 to Jan 30 1902</i>	<i>October 23 & 28-1901</i>

SKETCHES OF FRAMES SHOWING POSITION AND DESCRIPTION OF WELDS OF FORGINGS, OR PARTICULARS OF TESTS APPLIED TO CASTINGS.

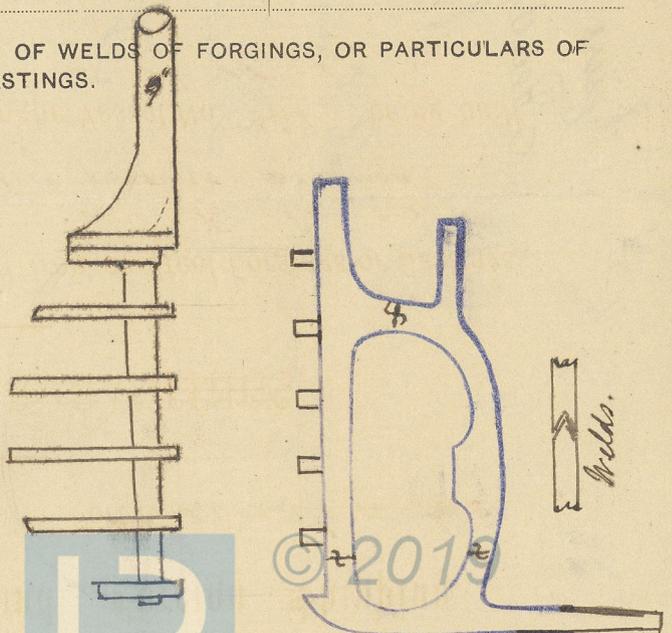

Fee (if any chargeable) £ : :

To be paid at _____

* If of Iron, state whether scrap or puddled Iron.