


Kureha Maru
Gka 2382.

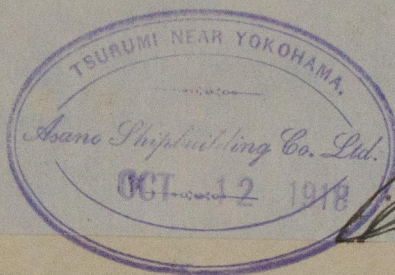

[Signature]

| | |
|--|---------------------------|
| Ship's Name or No. NOS.7-15 & SISTER SHIPS | |
| Name of Drawing | MIDSHIP SECTION (REVISED) |
| P. No. | Sending No. 94 |

RETAIN



© 2019

Office Copy

Lloyd's Register
6650-0840
Foundation