

S.S. N^o 575.

350'0" x 46'9" x 28'0" MOULDED.

SCALE 1/6" = 1 FOOT

Top of main deck beams to top of upper deck beams 10'0"


Main deck plating - 5/16" with beams on alternate frames.
Bulks overlapped & double riv. for 1/2 ft. single at ends.

Upper deck plating - 5/16" with beams on alternate frames.
Bulks overlapped & double riv. for 1/2 ft. single at ends.

Shutter Deck - 5' x 5' with the plates as per plan.



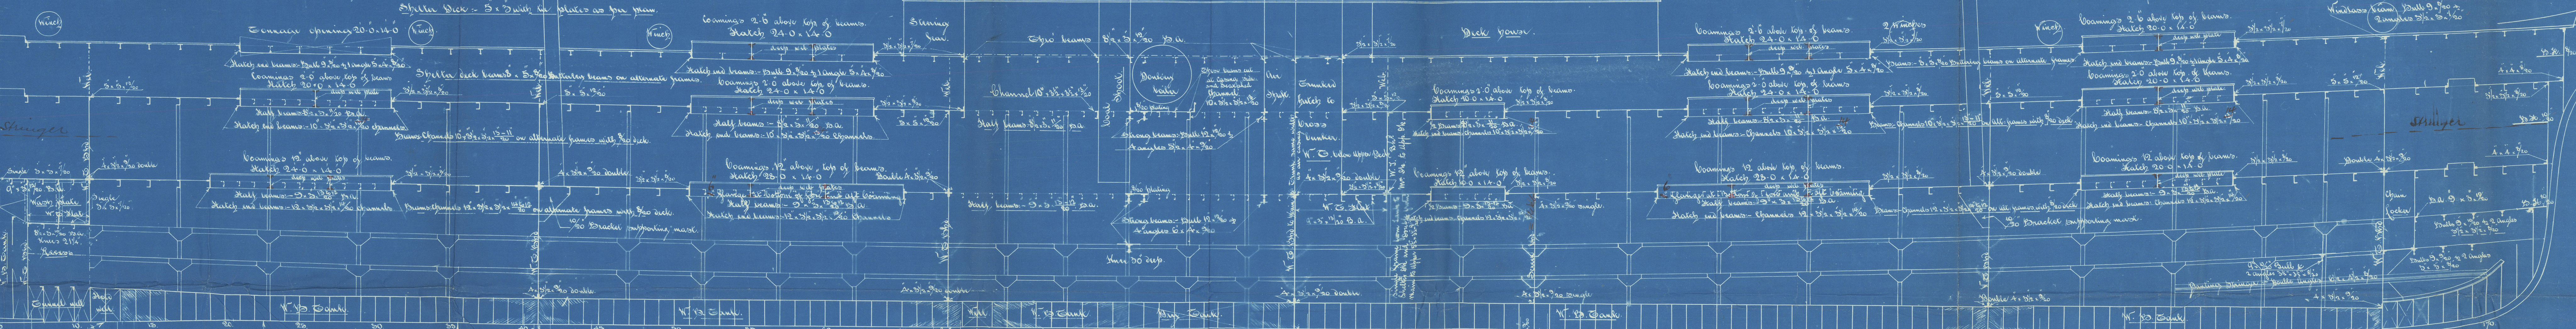


Beam Lines


Shutter Deck
Buttling beams - 20' deep, 2 1/2" x 10"
Sho' B.A. - do - 22 1/2"
Shutter Deck - do - 22 1/2"

Upper Deck
Channel beams - 20' deep, 2 1/2" x 10"
Sho' B.A. - do - 22 1/2"
Shutter Deck - do - 22 1/2"

Main Deck
Channel beams - 20' deep, 2 1/2" x 10"
Sho' B.A. - do - 22 1/2"
Shutter Deck - do - 22 1/2"

Buttling Shingles
Butt beams - 20' deep, 2 1/2" x 10"
Sho' B.A. - do - 22 1/2"

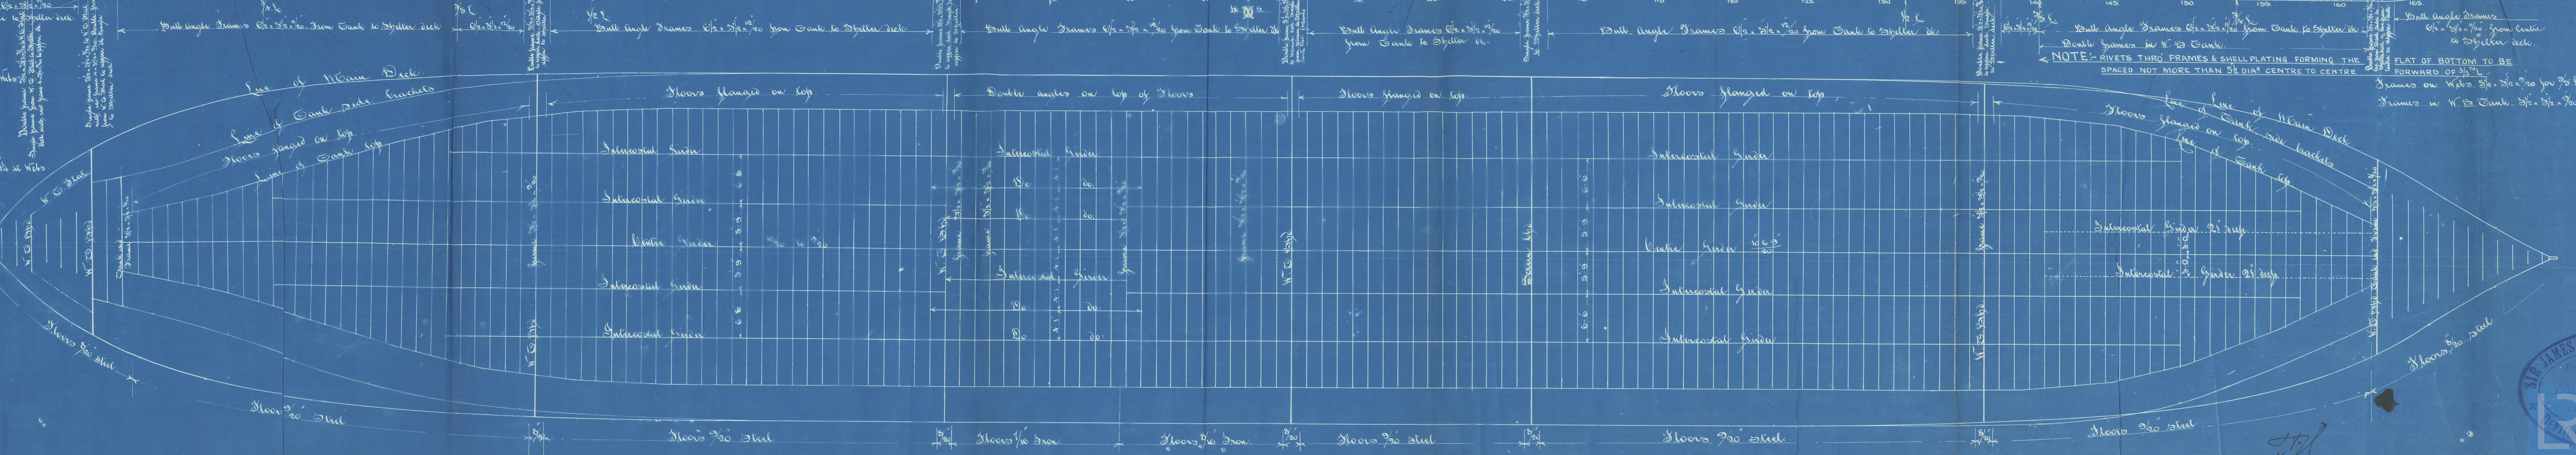

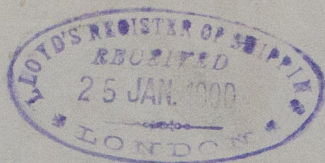

Further Arrangement




Profile

S/S No. 575

Sir James Caird & Co. Ltd.

S. S. "Pille de Majunga"

Registered. No. 20434

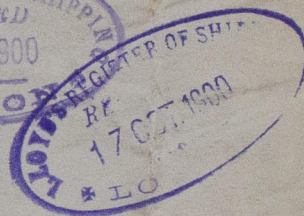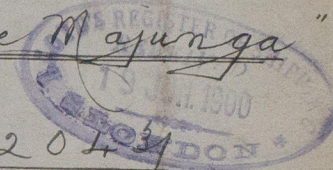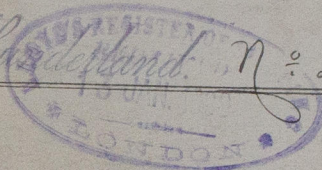

W650-0131

RETAIN

©2019

Lloyd's Register
Foundation