

S.S.N° 575

575

Midship Section

Sir J. Laing & Sons Ltd


— 79575 —

Midship Section

as Built.

S.S. "Ville de Majunga"

Sunderland, No.

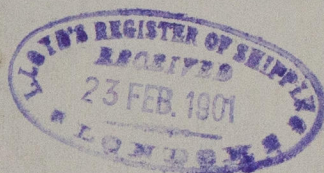

W650-0132

RETAIN



© 2019

Lloyd's Register  
Foundation