


LIMITS OF TENSILE STRENGTH OF MATERIAL		
SHELL PLATES	29 TO 33 TONS	SIEMENS MARTIN STEEL
BUTTRIPS GRATES (DOUBLE)	28 TO 32 TONS	
OTHER PLATES	26 TO 30 TONS	
FURNACES	26 TO 30 TONS	
MAIN STAYS	28 TO 32 TONS	
SCREWED STAYS	26 TO 30 TONS	
RIVET BARS	26 TO 30 TONS	

ALL RIVET HOLES BORED IN PLACE.

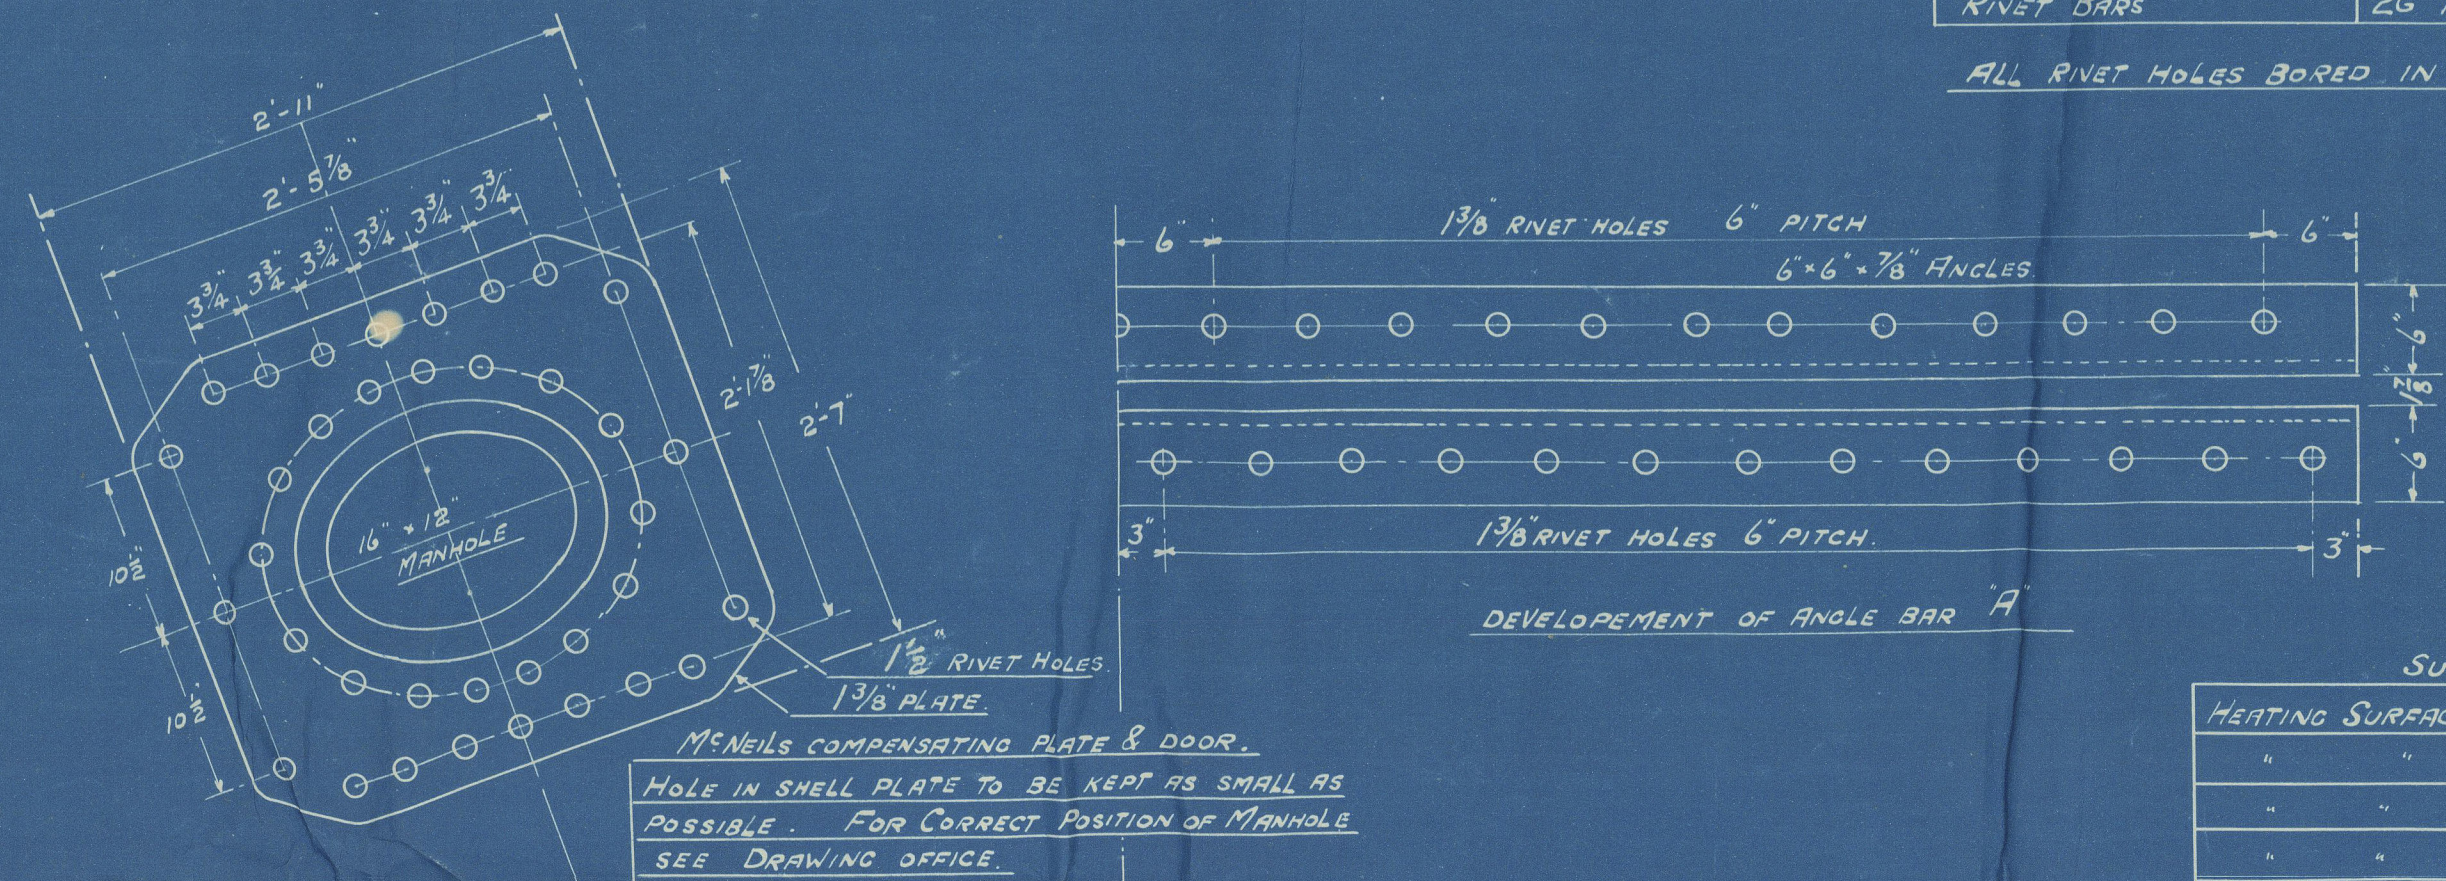

Glasgow
Wm W Henderson & Co
Main Boilers
No 504

Amended

Amended

app with 503

12/4/20

SS Hogarth

Glas Rpt No 41586.

RETAIN



© 2020

Lloyd's Register
Foundation

Wb52-0164