

3.5.19

— PROFILE & DECK PLANS —

S.S. N° 504








SCALE 1/8" = 1 FT.

DIMENSIONS 442' 0" x 55' 0" M<sup>2</sup> x 38' 0" M<sup>2</sup> TO SHELTER DECK

TO CLAS 100 A.I. AT LLOYD'S SHELTER DECK.

PLAN OF PILLARS & GIRDERS TO BE SUBMITTED.

*Also include stiffeners at king of stanchions to Quinquer's satisfaction*

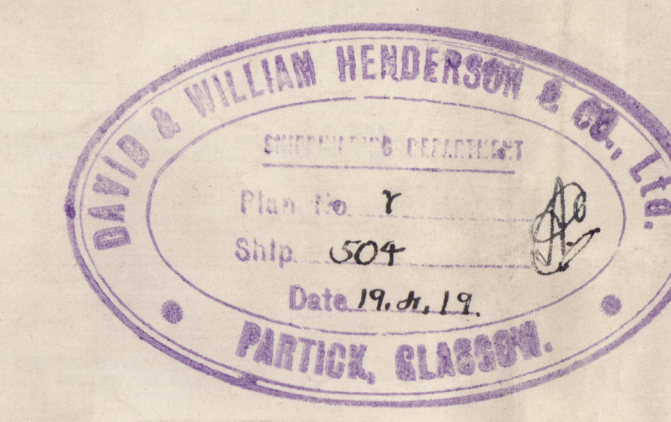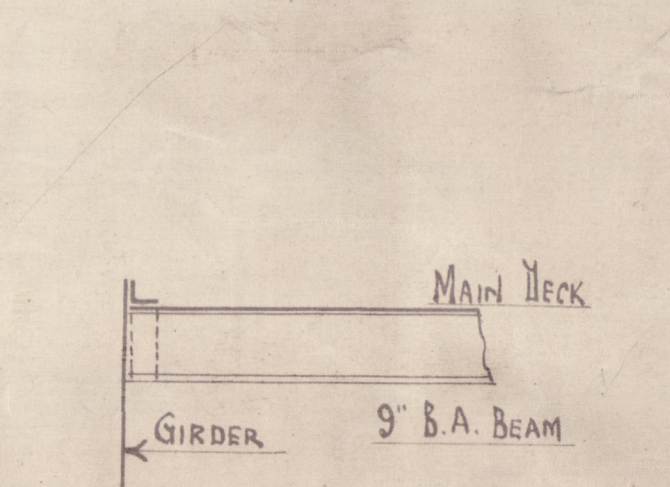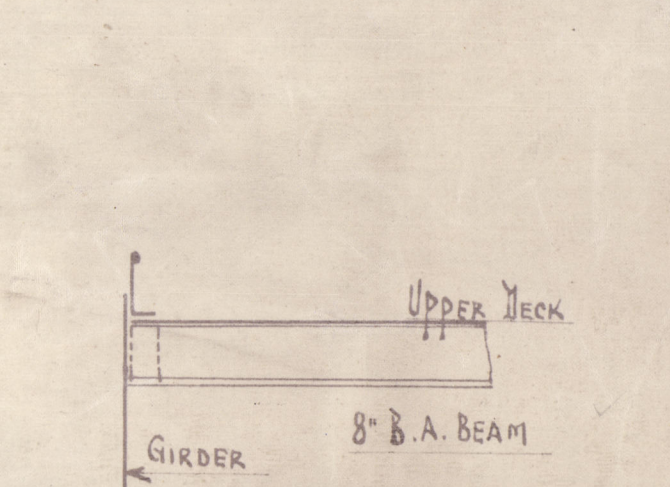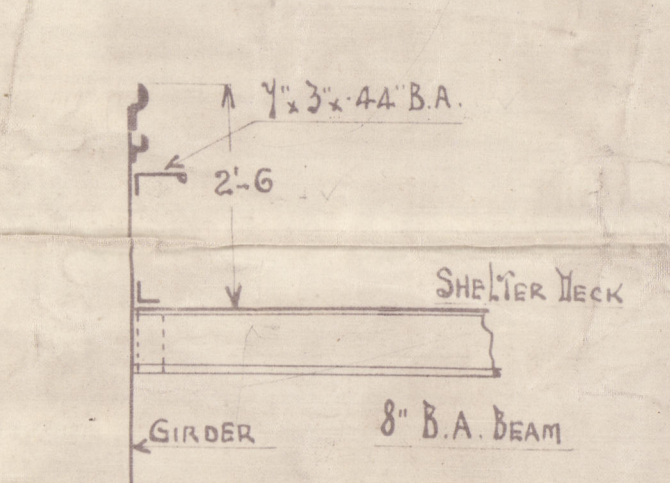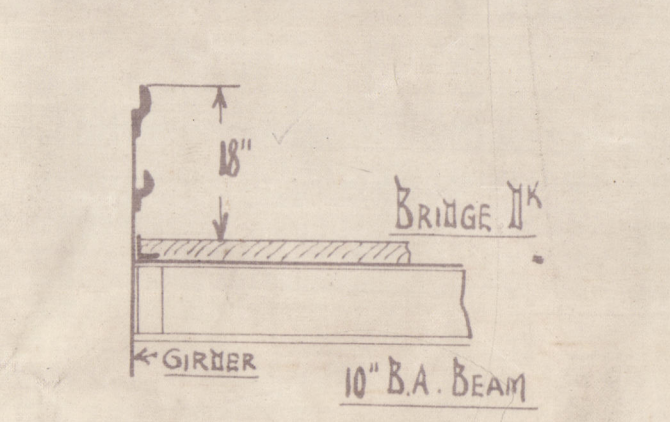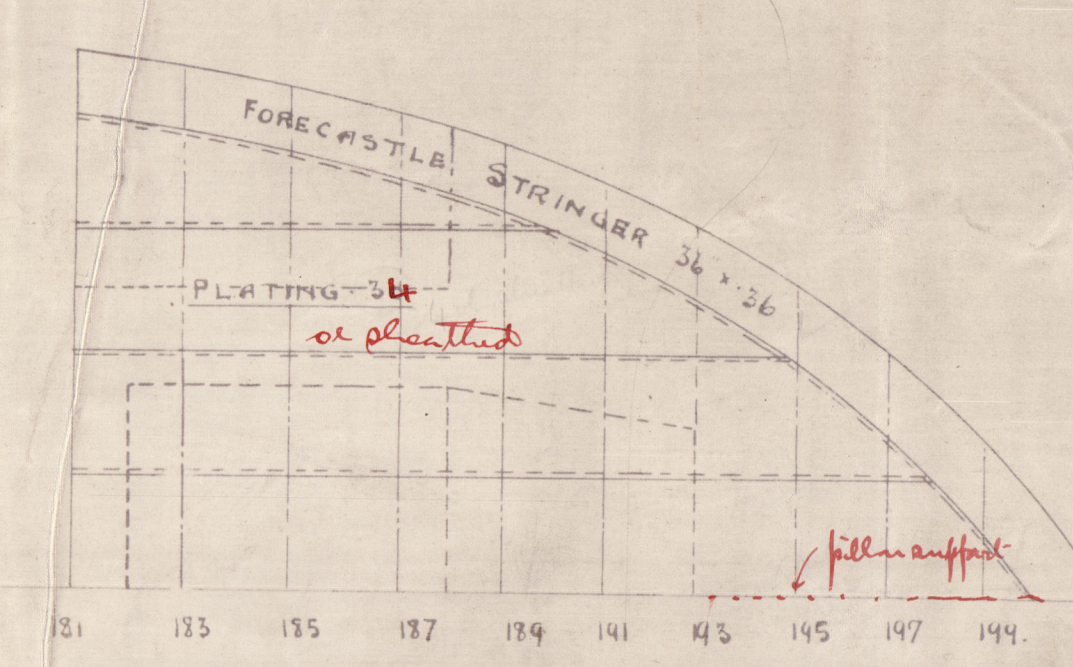 


Typical Section Thru Hatches  
SCALE 1/2" = 1 FT.



N<sup>o</sup> 504.

Profile + Deck  
Plans

Don Henderson

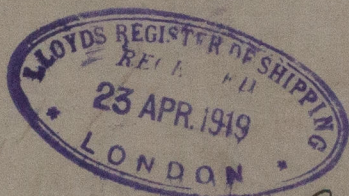

S/S. Hogarth (504)  
Glasgow Apr 4/1919

RETAIN



© 2020

Lloyd's Register  
Foundation