


W653-0035 1/2

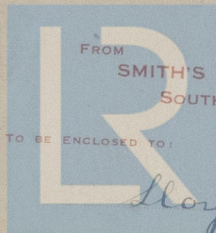

FROM

SMITH'S DOCK COMPANY, LTD.,

SOUTH BANK-ON-TEES, S.O.

TO BE ENCLOSED TO:

Lloyds

m'eto


© 2021

SHIPBUILDING DEPT.

Lloyd's Register
Foundation

S. S. "Hartley"
Smith's Dock's No 797.

Midship Section of Vessel
as built.

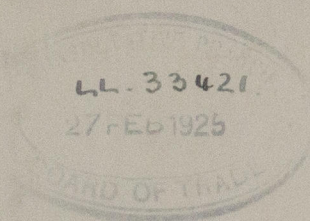

S.S.
MDB. RPT. No. 12876

RETAIN



© 2021

Lloyd's Register
Foundation

W653-00352