






5/5 "HARTLEY" PROFILE & DECK PLANS.

STEEL SCREW STEAMER.

DIMENSIONS:- LENGTH B.P. 280'0". BREADTH MID 41'3". DEPTH MID 22'3".

Scale:- 1/8" = 1 FOOT.

TO CLASS 100 A.I. AT LLOYDS.

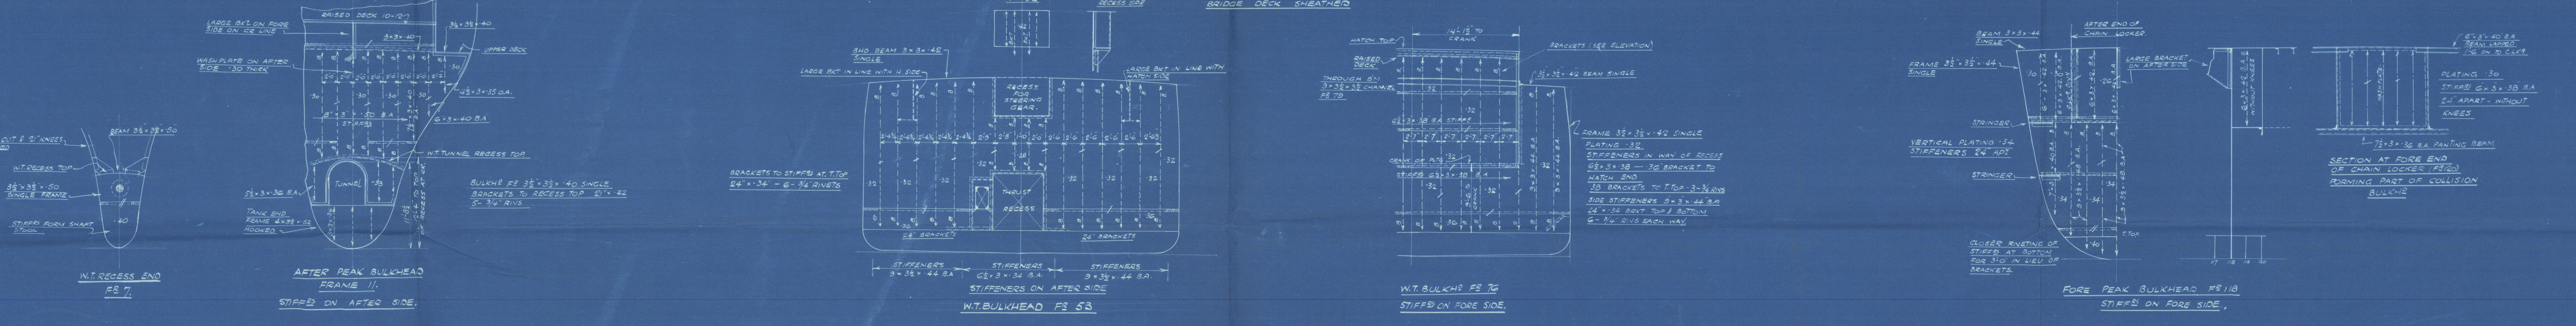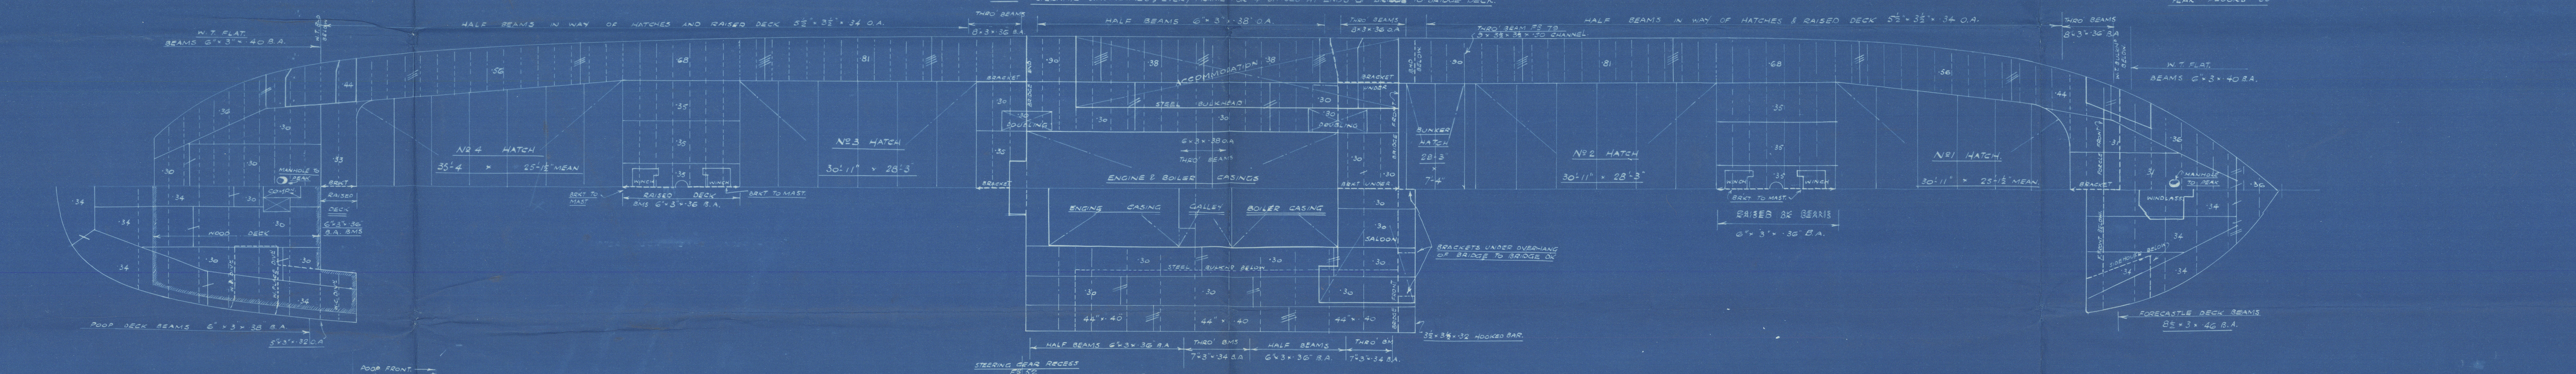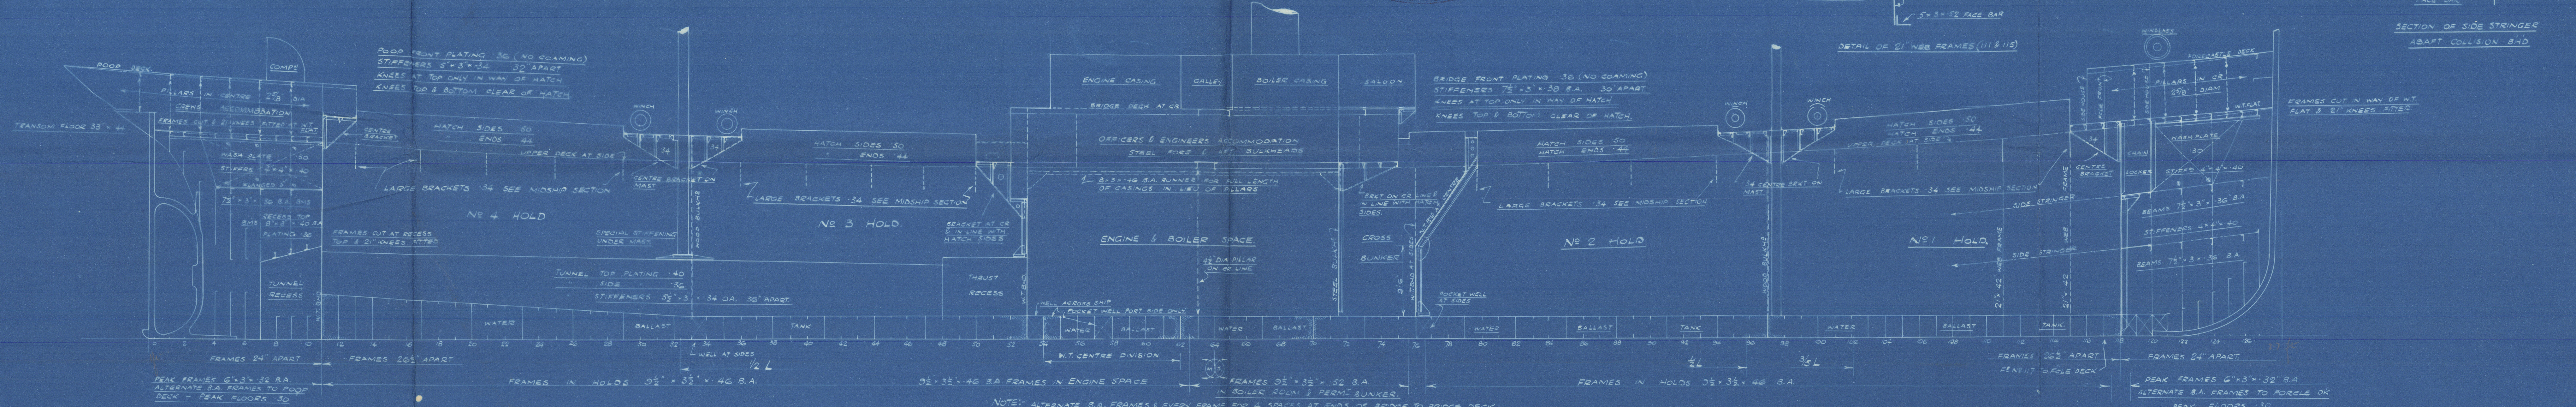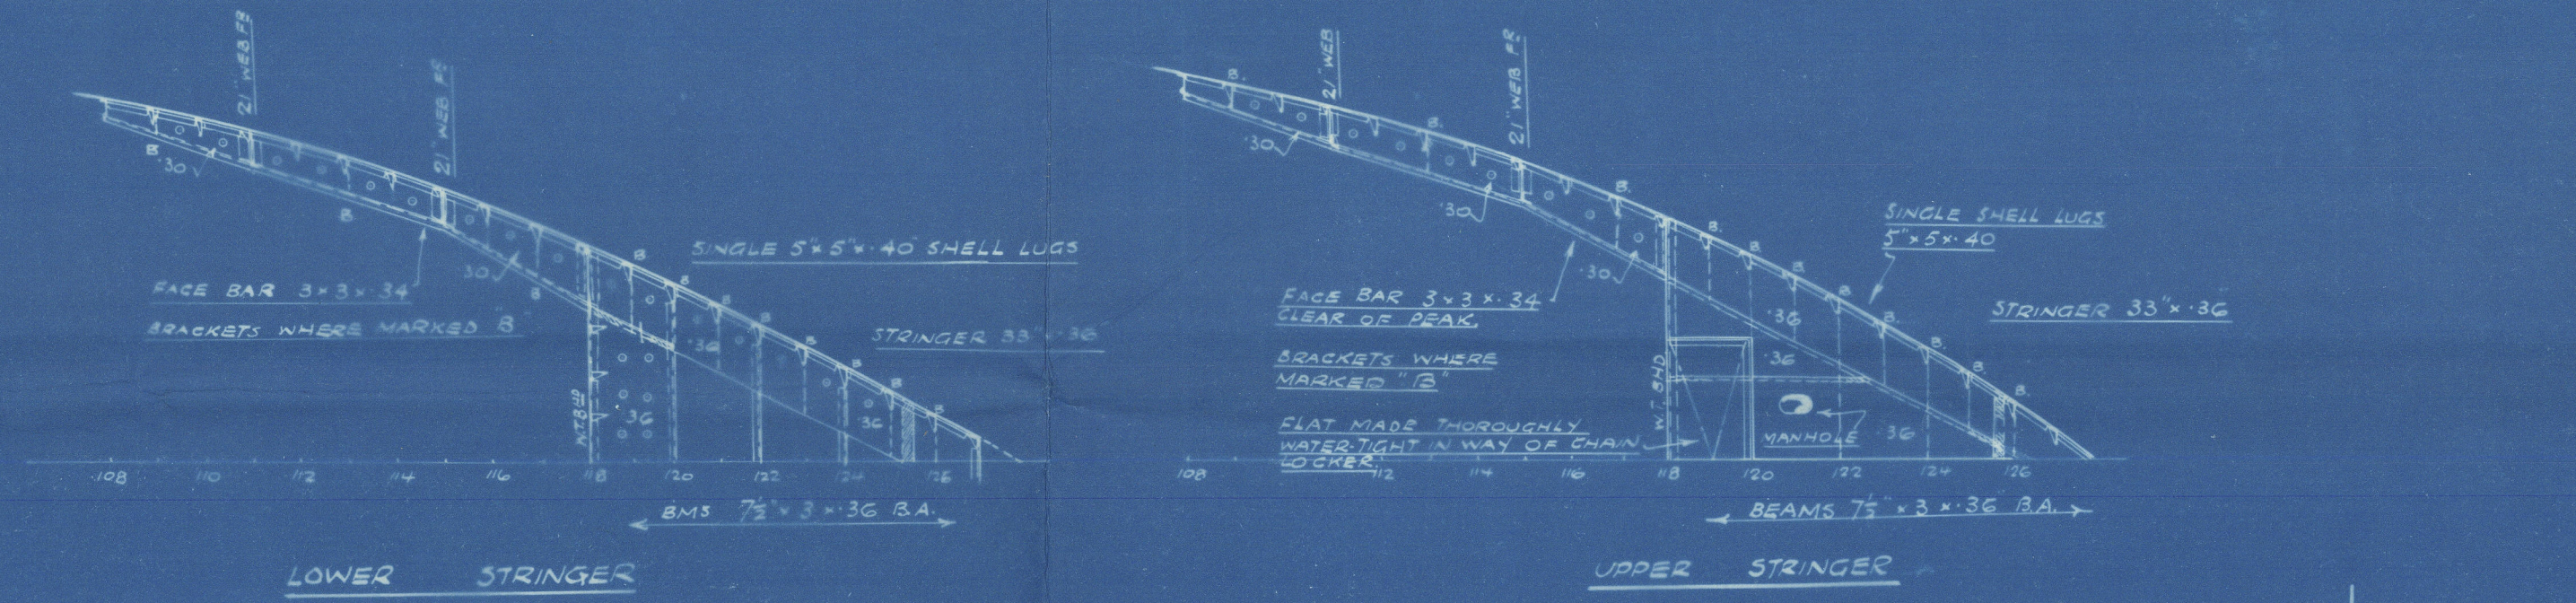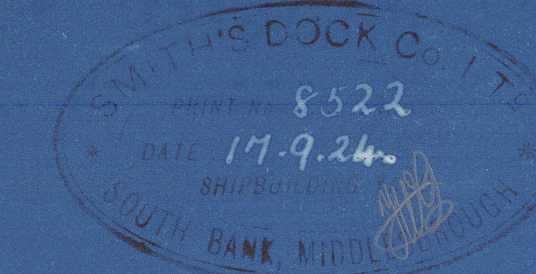

W653-0036 1/2

SHIPBUILDING DEPT.

FROM

SMITH'S DOCK COMPANY, LTD.,

SOUTH BANK-ON-TEES, S.O.

TO BE ENCLOSED TO:


Lloyds.

Lloyd's Register
Foundation

S. S. Hartley
Smith's Dock No 797

Plan of Profile & Decks
of vessel as built.

S.S.
MDB. RPT. No. 12076.

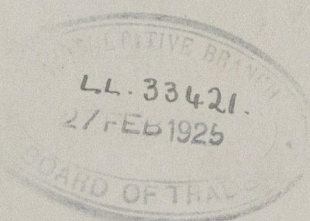

RETAIN



© 2021

Lloyd's Register
Foundation

W653-0036