


S.S. "MARALIE"


Mid:- 141.0' x 23'-6" x 10'-10"

PROFILE

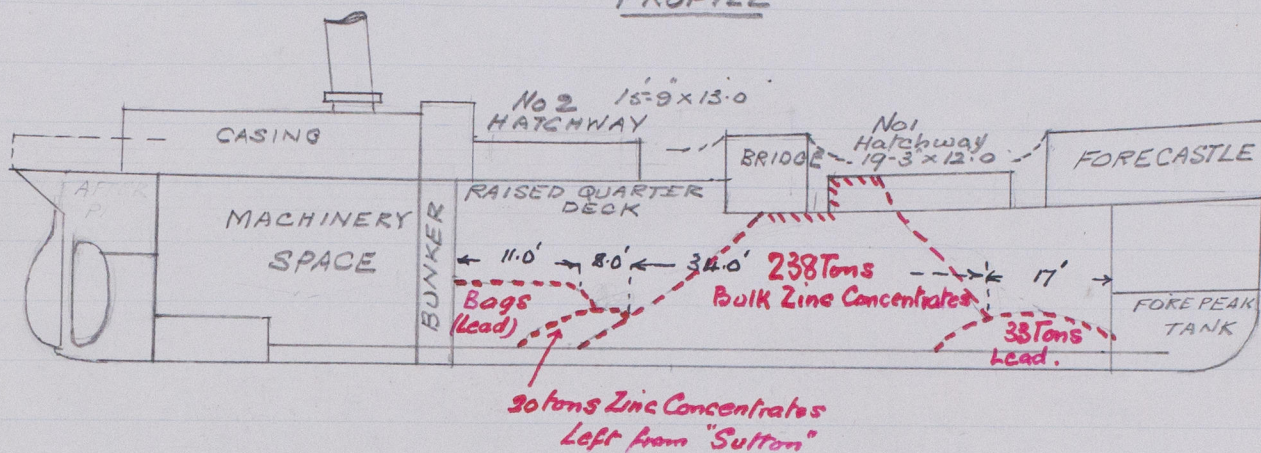


Loading of vessel at Aberystwyth with Zinc and Lead Concentrates

Section

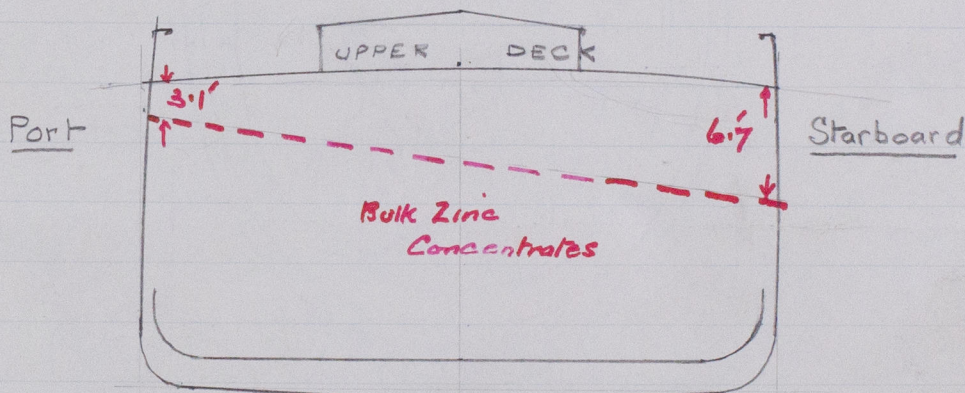


Position of Cargo when vessel arrived at Milford Haven.

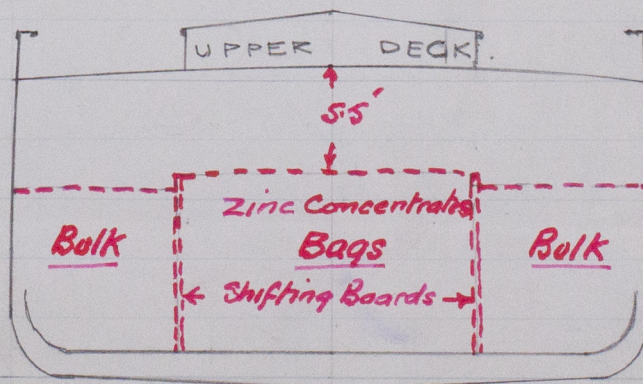

Position of cargo when vessel left Milford Haven for Antwerp

W654-0003

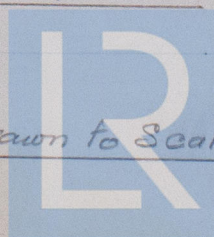

© 2020

Not drawn to Scale

Lloyd's Register Foundation

S. W. B.
37-4-26