





MIDSHIP SECTION


DUNDEE S. B. Co. LD.

N<sup>o</sup>. 289, 302,

S. S. "MONEYSPINNER"

S. S. "PLODDER"

DUN. RPTS. N<sup>o</sup>. 8045, & 8105

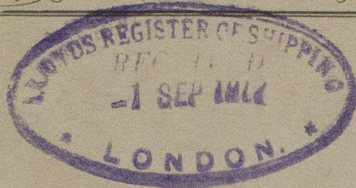

No. 1

RETAIN



© 2020

Lloyd's Register  
Foundation

W654-0054



*Merchants Section*

*N<sup>o</sup> <sup>289</sup>~~302~~ Dundee*



© 2020

Lloyd's Register  
Foundation