



(289) 8/1/17  
Boz) 3/1/17

BULKHEAD No 5  
PLATING 34 TO 30  
STIFFS 6 1/2 x 3 1/2 x 40 AA  
SPACED 24 APART  
FRAME 4 1/2 x 4 1/2 x 44  
BEAM 4 x 3 x 30

BULKHEAD No 31  
PLATING 30 TO 26  
STIFFS 7 1/2 x 40 3/4  
SPACED 30 APART  
FRAME 4 1/2 x 4 1/2 x 42  
BEAM 3 1/2 x 3 1/2 x 30  
TANK WALE 3 1/2 x 3 1/2 x 30

BULKHEAD No 8  
PLATING 26  
STIFFS 4 1/2 x 3 x 30  
SPACED 30 APART  
FRAME 4 1/2 x 4 1/2 x 44  
BEAM 3 1/2 x 3 1/2 x 30

SEE SEPARATE  
PLAN FOR No 302

289  
- No 302 -

— PROFILE & DECK PLANS —

— DIMS. 200-0 B.P. x 32-0 MLD. x 15-1 MLD. MAIN DK. —

— SCALE 1/8" = 1 FOOT —

BULKHEAD No 55

PLATING 34 TO 30

STIFFS BELOW PLAT 6 1/2 x 3 1/2 x 40 AA

RAVING PLAT 4 1/2 x 3 x 36 AA

HORIZONTAL STIFFS 6 1/2 x 3 1/2 x 40 AA


DECK ANGLE 3 1/2 x 3 1/2 x 40

FRAME ANGLE 4 1/2 x 4 1/2 x 42

Wall R. 1/2 No. 9

1202

May 23<sup>rd</sup> /16

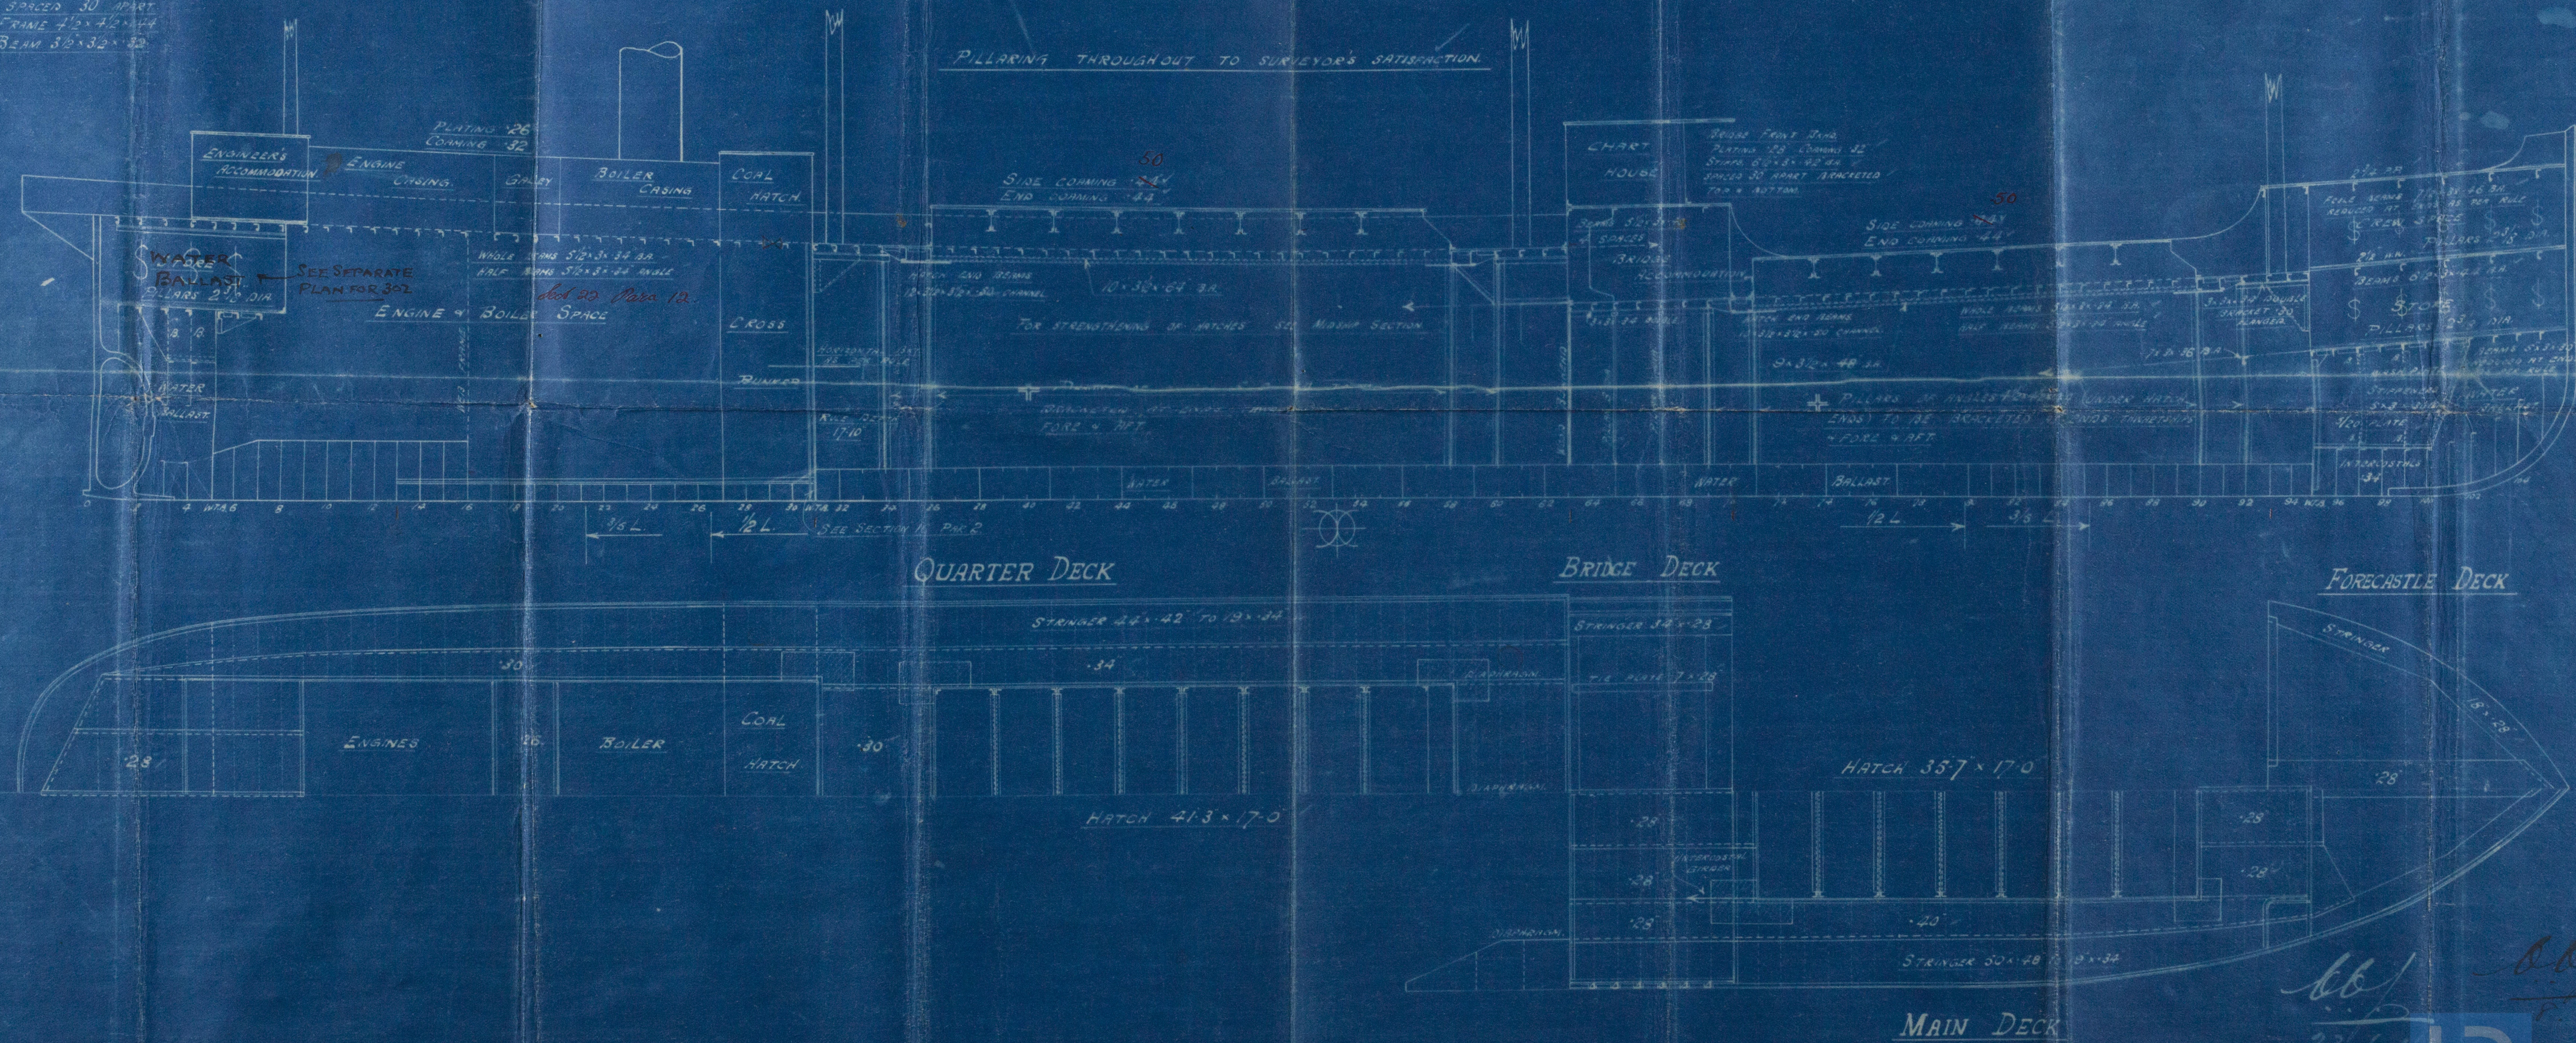



W. 541

ELEVATION


DUNDEE S. B. Co. Ld.

Yos. N<sup>o</sup>: 289, 302

S. S. "MONEYSPINNER"

S. S. "TLODDER"

DUN. RPTS. N<sup>o</sup>: 8045, 8105

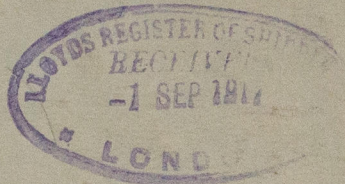

h. 2



RETAILED



© 2020

Lloyd's Register  
Foundation

W654-0055



Elevation

289

DUNDEE . N<sup>o</sup> ~~302~~



© 2020

Lloyd's Register  
Foundation