

SCALE $\frac{1}{8} = 1$ FOOT




Bartram & Sons

No 187 = SS Benarty

Profile & Decks
as built

Sunderland. No 21030.

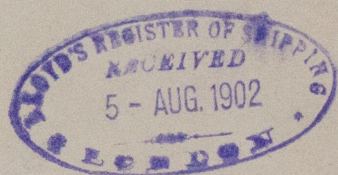

RETAIN



© 2020

Lloyd's Register
Foundation
W654-0125