


Std. assigned  
 1 1/2" Cof. base  
 1 1/2" X 1 1/2"  
 3" WNA  
 2 1/4" STHT DR. LINE  
 1/4" DR. DR. DR.

approved  

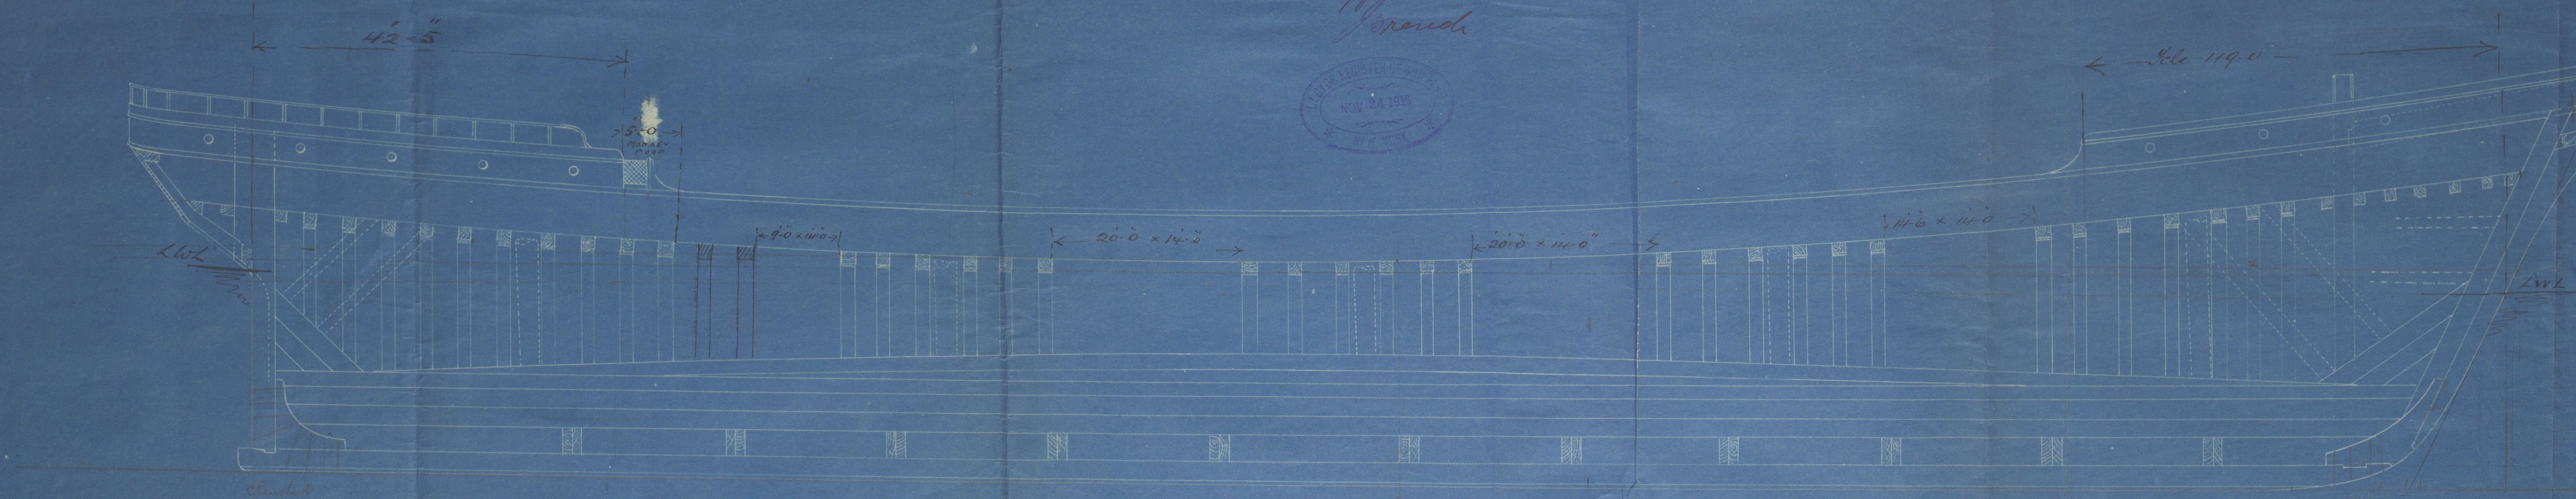

Aux. S. S. 5 Masted Schooner  
 "H. C. Hansen"  
 No. 3

LENGTH O.A. 260 FEET  
 BLAM MOULDED 43' DEPTH MOULDED 22'

Seaborn Shipyards Co.  
 Tacoma, Wash.

SCALE 1/8" = 1 FOOT




Lloyd's Register  
 Foundation



Seaborn Shipyard Ltd  
Profile  
Vessel No. 3

Aux Twin Screw. 5 m. Wood Schooner,  
"H. C. Hansen"

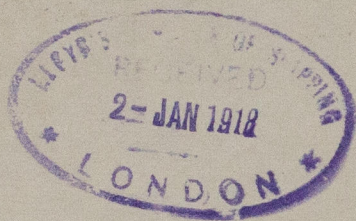

RECEIVED



© 2020

Lloyd's Register  
Foundation

W656-0292