


3 OFF



TEST " 360 " "

28/2/08

TUBES	1788.62 #
FURNACES	17076 "
COMBUSTION CHAMBERS	180.22 "
TUBE PLATES	61.39 "
TOTAL IN ONE BOILER	2200 "
" " 3 BOILERS	6600 "
TOTAL GRATE SURFACE	173.25 #
	57.75

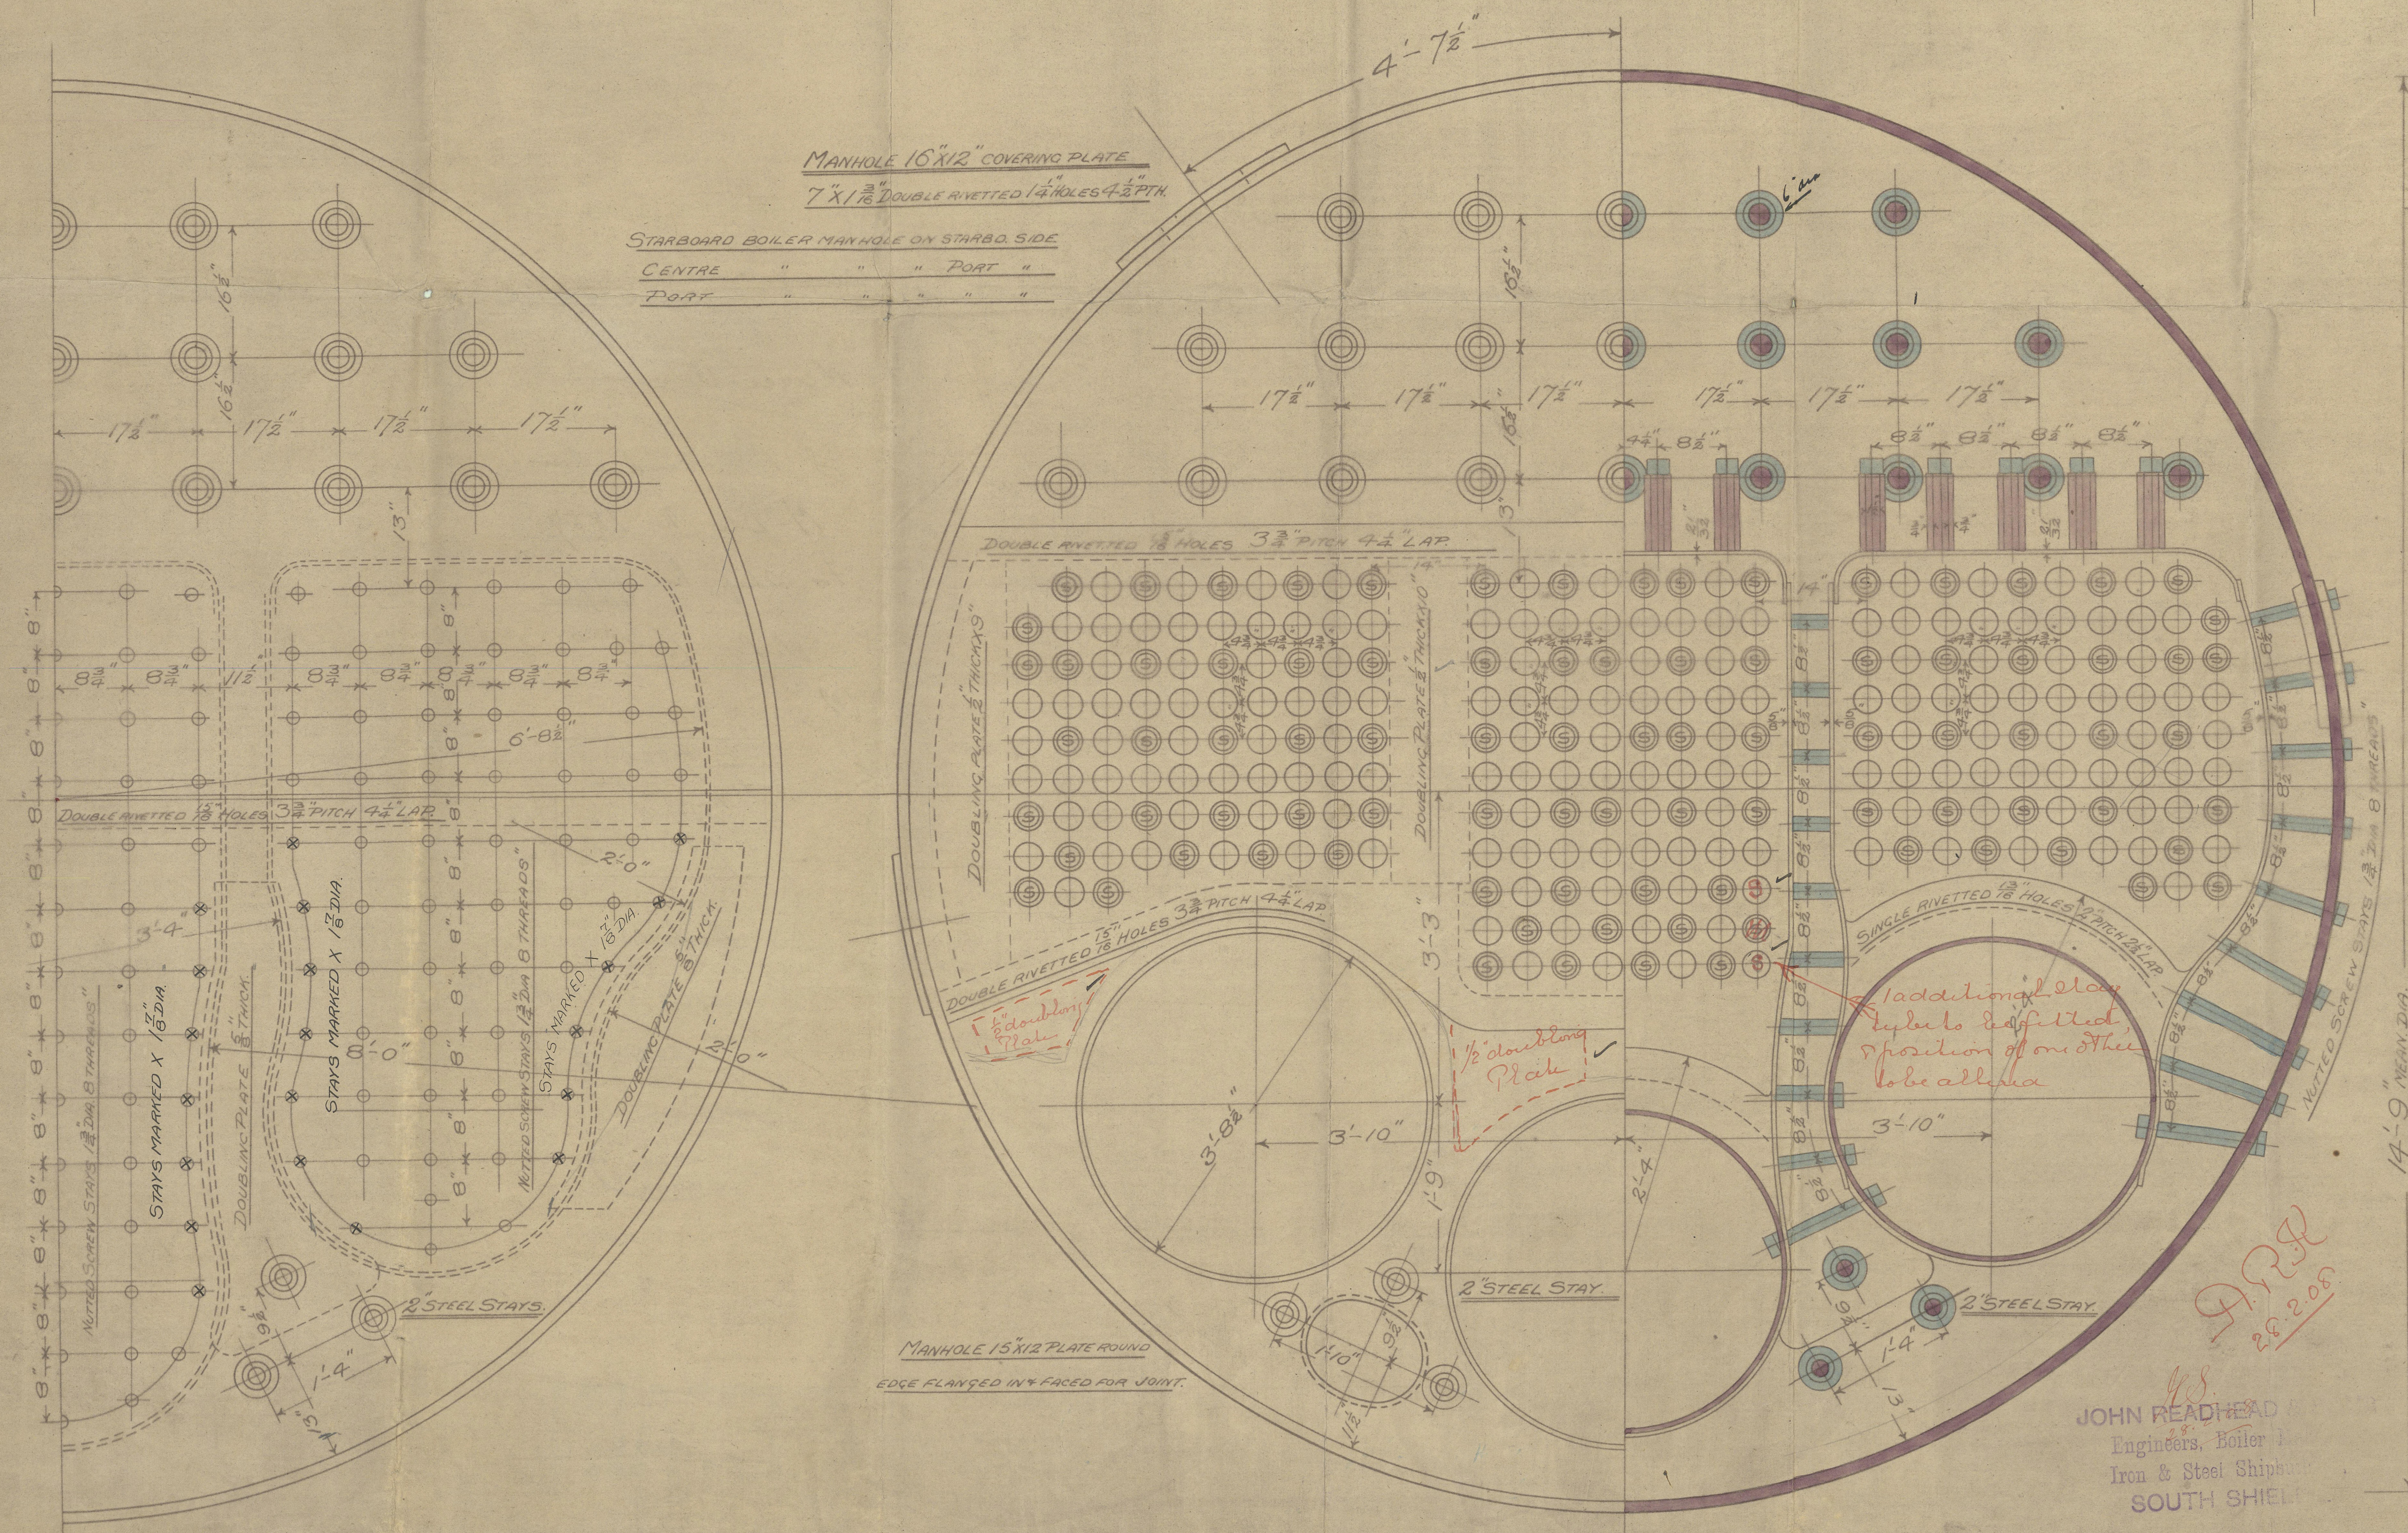

ENGINE N<sup>o</sup> 1857

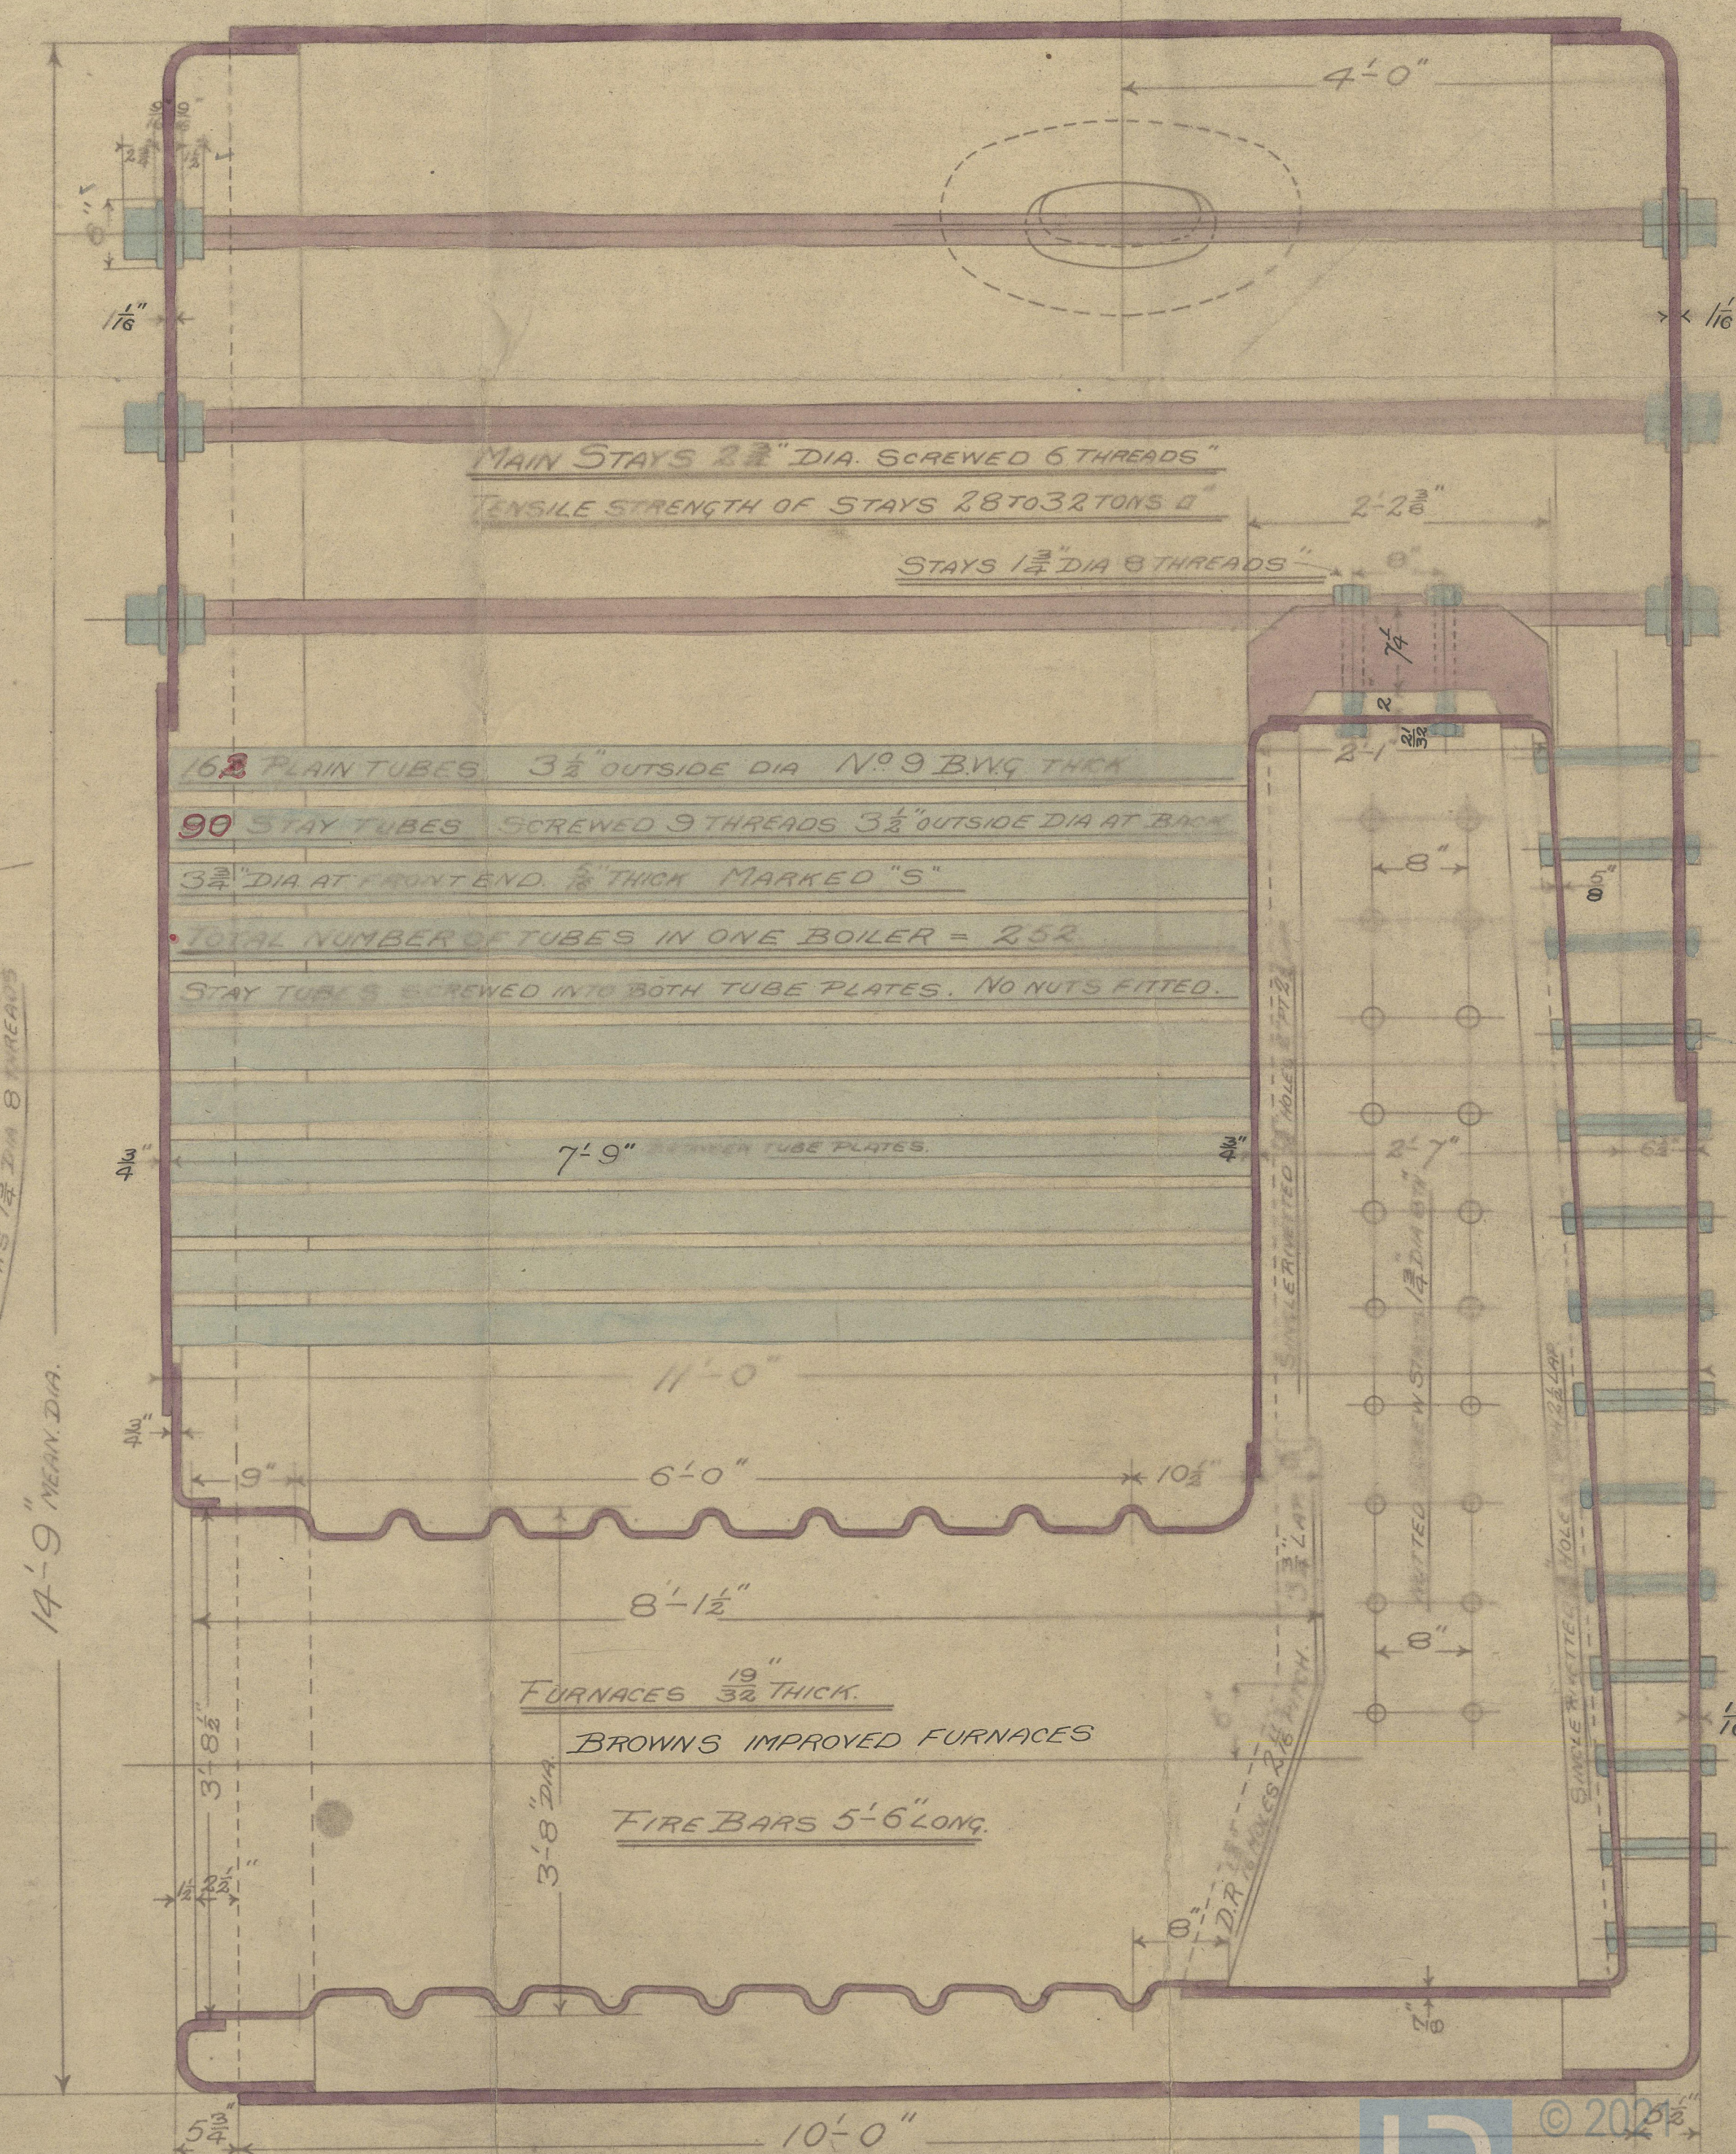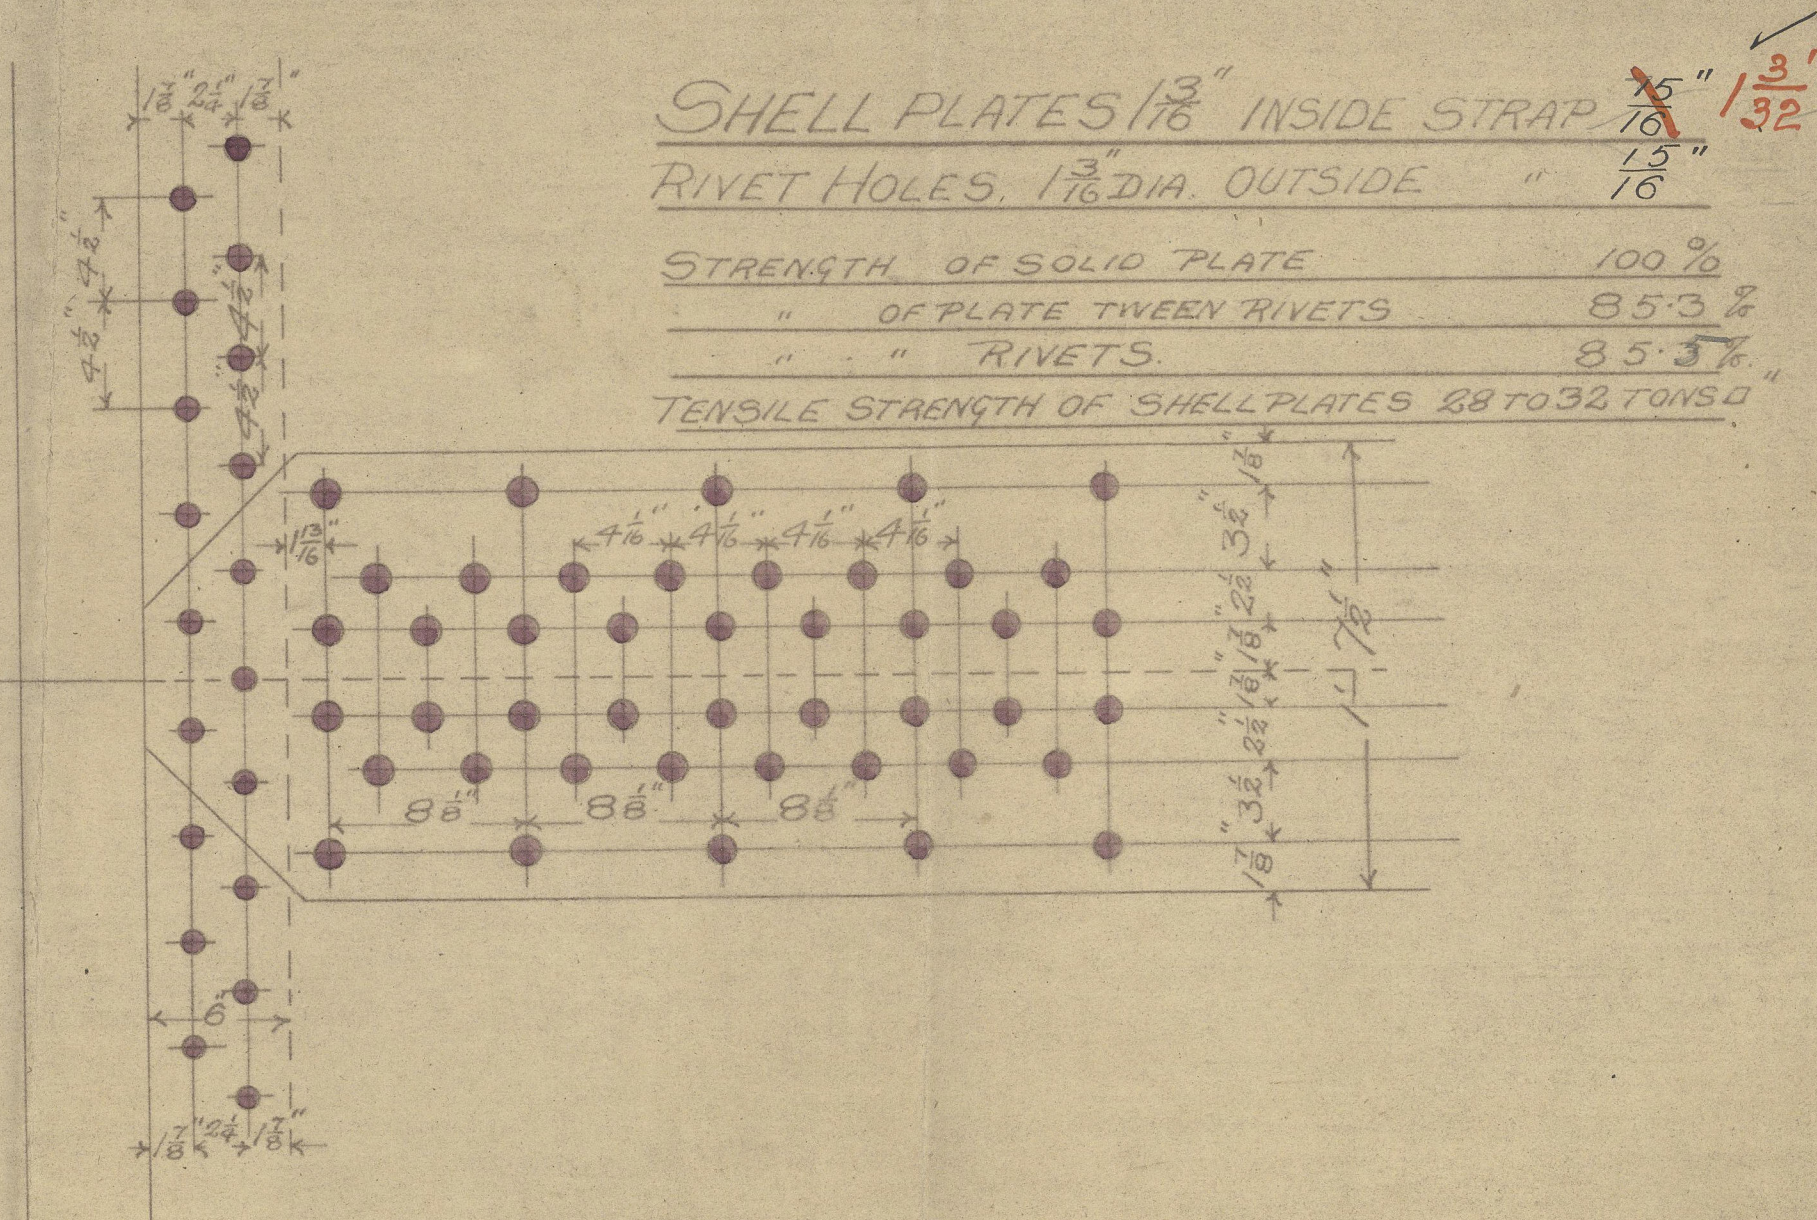



Newcastle

J. Readhead Esq.

M. Bles to 1857

For Ship to 407

N. P. 180th o.


(1)

No. 7766  
Lloyd's List  
360 lbs.  
30.9.08. W.L.

J. P. "Harford"

Newcastle Report

SP<sup>2</sup> 55990

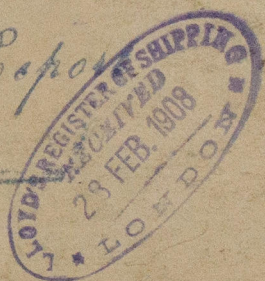

RETAIN



© 2021

Lloyd's Register  
Foundation

W657-01710

25/2/08