




PLAN N°31  
13.12.09 7-12-09  
24.12.09 22-12-09  
7.1.10  
4.2.10  
4.6.10

N<sup>os</sup> 338.9.40.  
STEEL SCREW STEAMERS  
MIDSHIP SECTION  
TO CLASS 100 ALL LLOYD'S WITH SHELTER DECK.  
SCALE 1/8" = 1 FOOT.

MOULDED DIMENSIONS 44' X 55.93' X 29.64' TO UPPER D<sup>s</sup> 37.64' TO SHELTER D<sup>s</sup>

FOR CHILLED MEAT TRADE  
TONNAGE COEFFICIENT 175

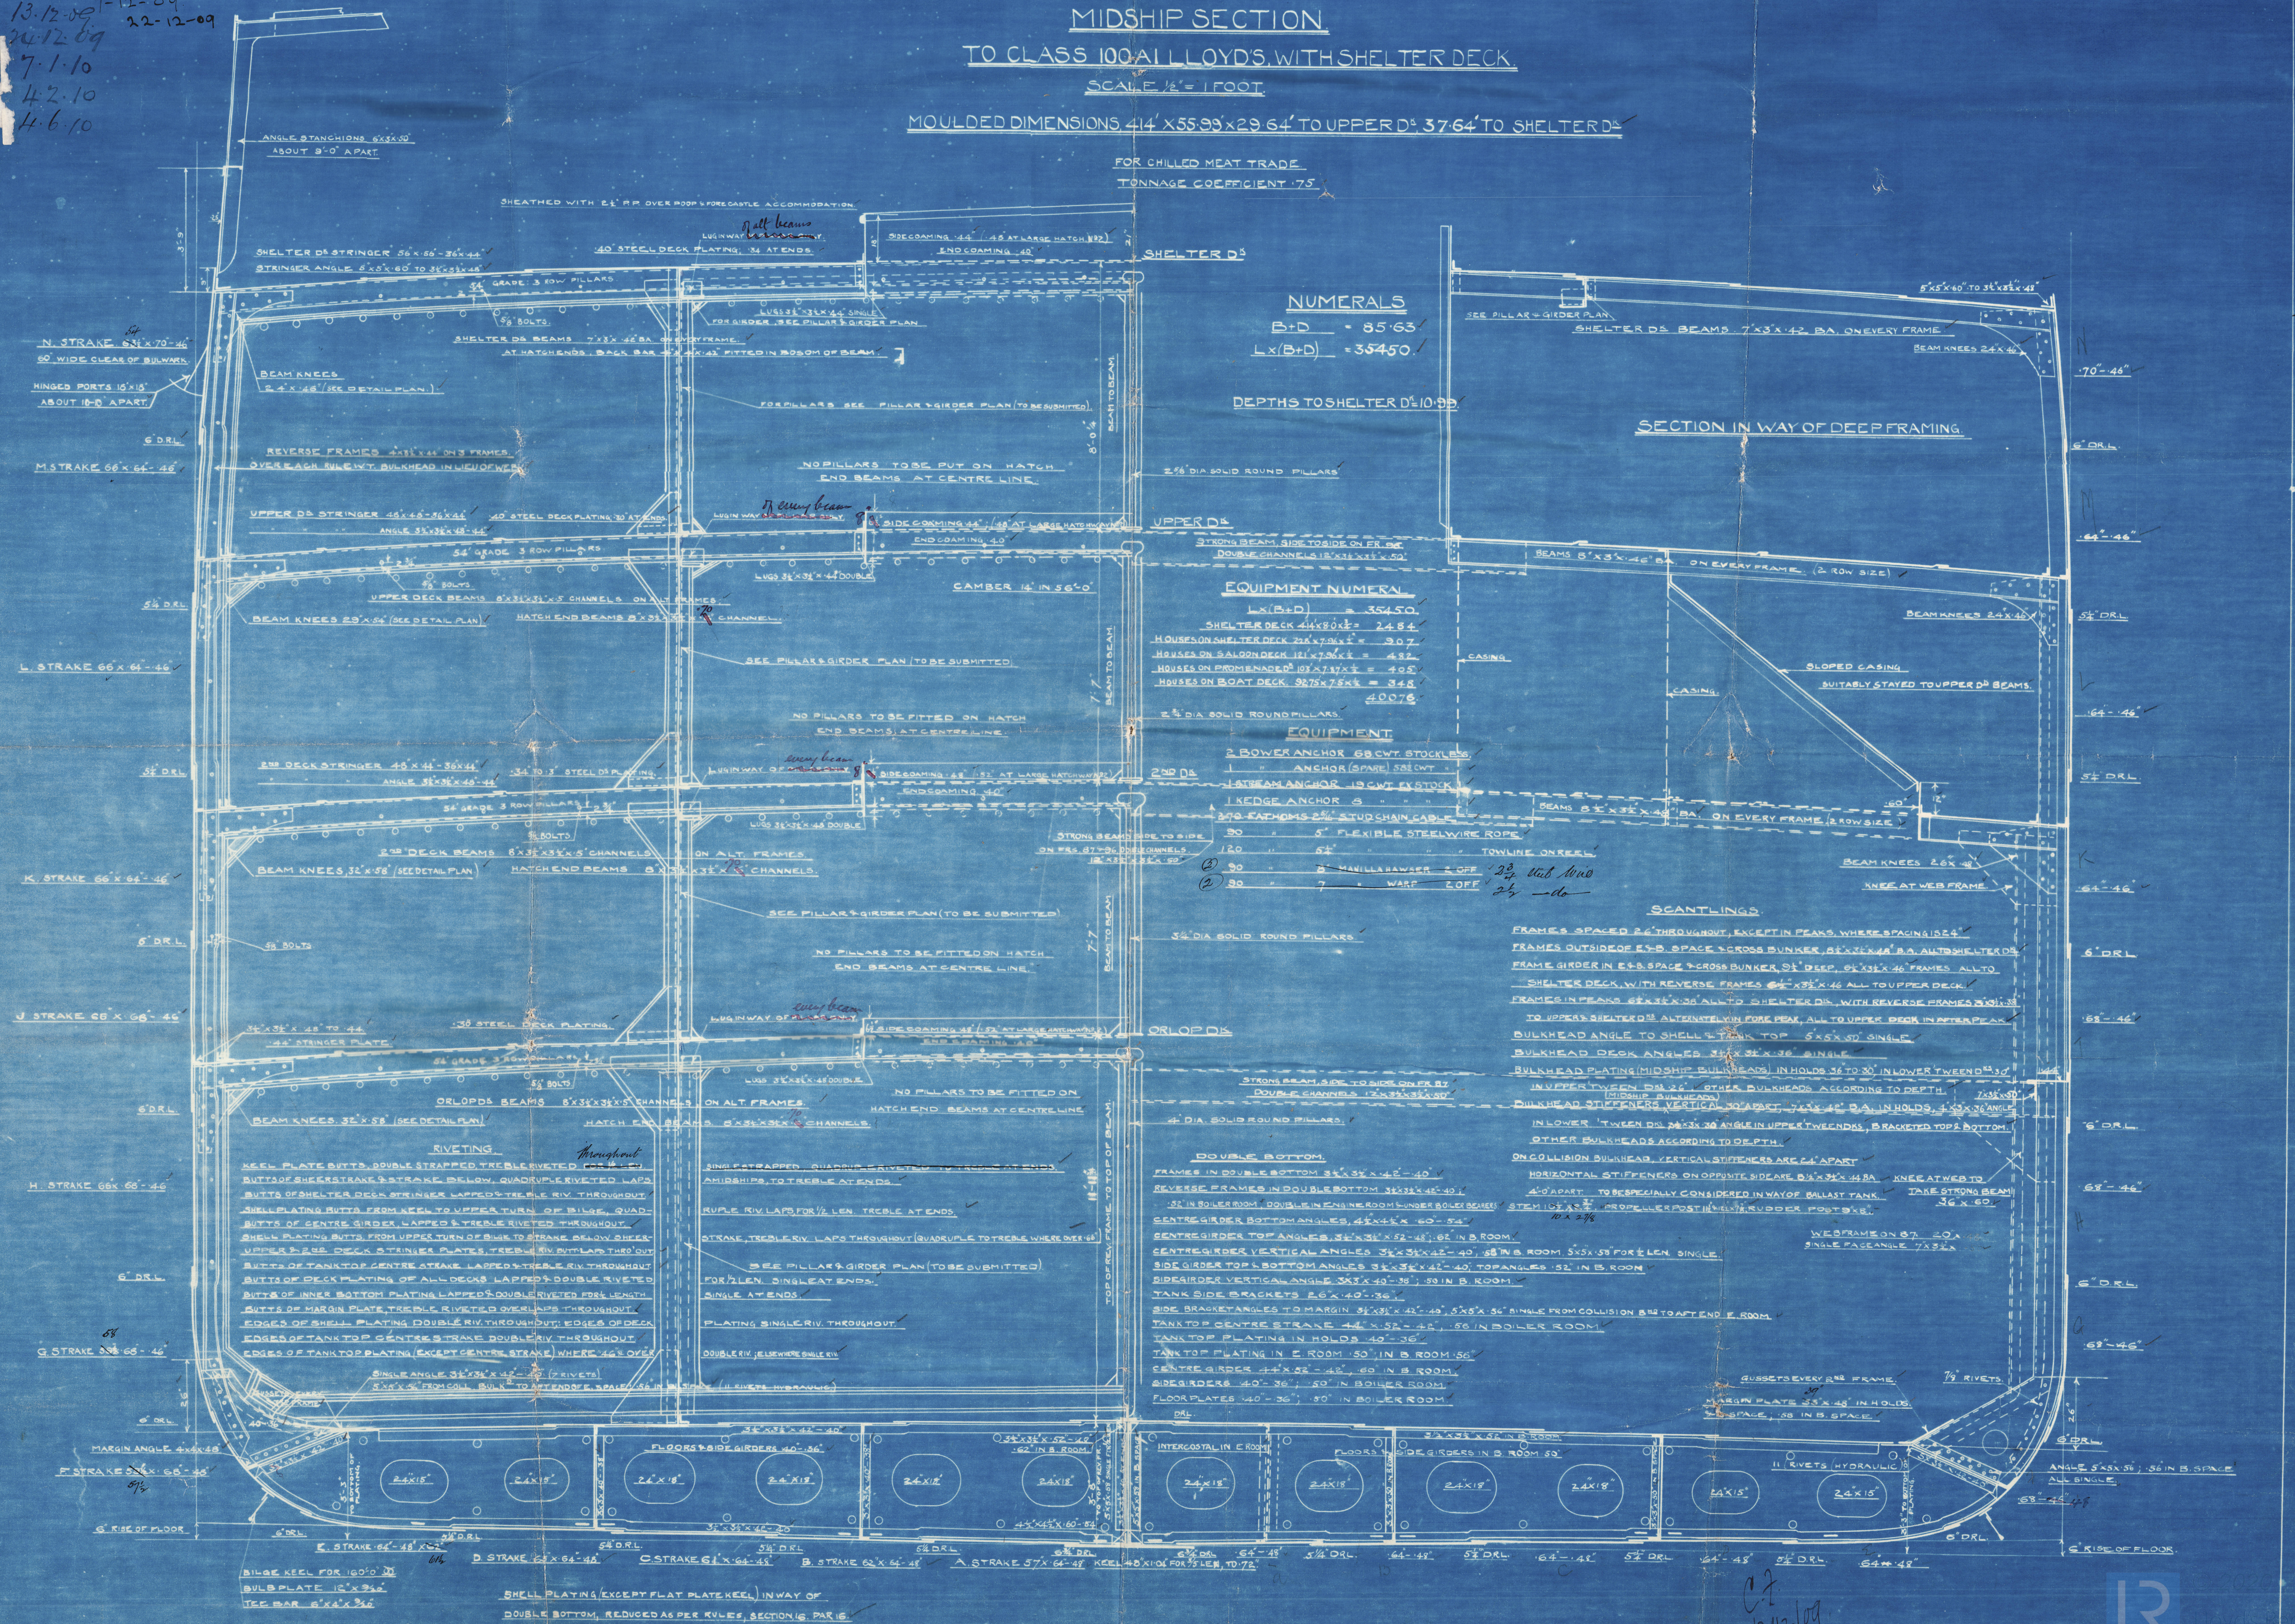

NUMERALS  
B+D = 85.63  
Lx(B+D) = 35450

DEPTHS TO SHELTER D<sup>s</sup> = 10.55

EQUIPMENT NUMERALS  
Lx(B+D) = 35450  
SHELTER DECK 44'x80' = 2484  
HOUSES ON SHELTER DECK 24'x78' = 307  
HOUSES ON SALOP DECK 12'x78' = 482  
HOUSES ON PROMENADE 10'x78' = 405  
HOUSES ON BOAT DECK 9'75'x75' = 348  
40076

EQUIPMENT  
2 POWER ANCHOR 68 CWT STOCKLESS  
1 ANCHOR (SPARE) 58 CWT  
1 STEAM ANCHOR 19 CWT STOCKLESS  
1 KEDGE ANCHOR 5  
270 FATHOMS 2 1/2\"/>

SECTION IN WAY OF DEEP FRAMING

SCANTLING

FRAMES SPACED 24\"/>

DOUBLE BOTTOM  
FRAMES IN DOUBLE BOTTOM 34'x34'x42' - 40'  
REVERSE FRAMES IN DOUBLE BOTTOM 34'x34'x42' - 40'  
32\"/>

WELDED ON 20'x20'x1/2\"/>

C.7  
13/12/09





S. S. Highland Bae.

Li: Rpt 65057.


Midship Section

S. S. Highland Lock

Li: Rpt 65661

S. S. Highland Pipe  
Li: Rpt 66204.

338920

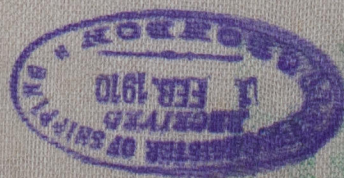

© 2020

Lloyd's Register  
Foundation  
W6581-0031