
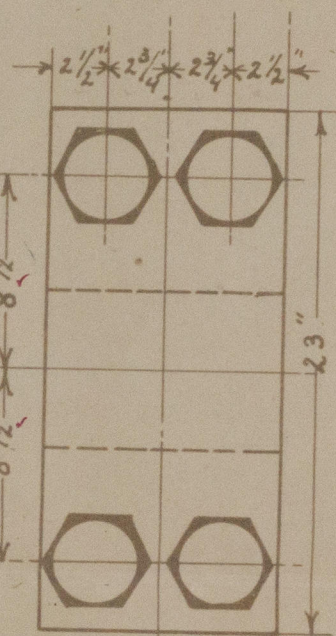
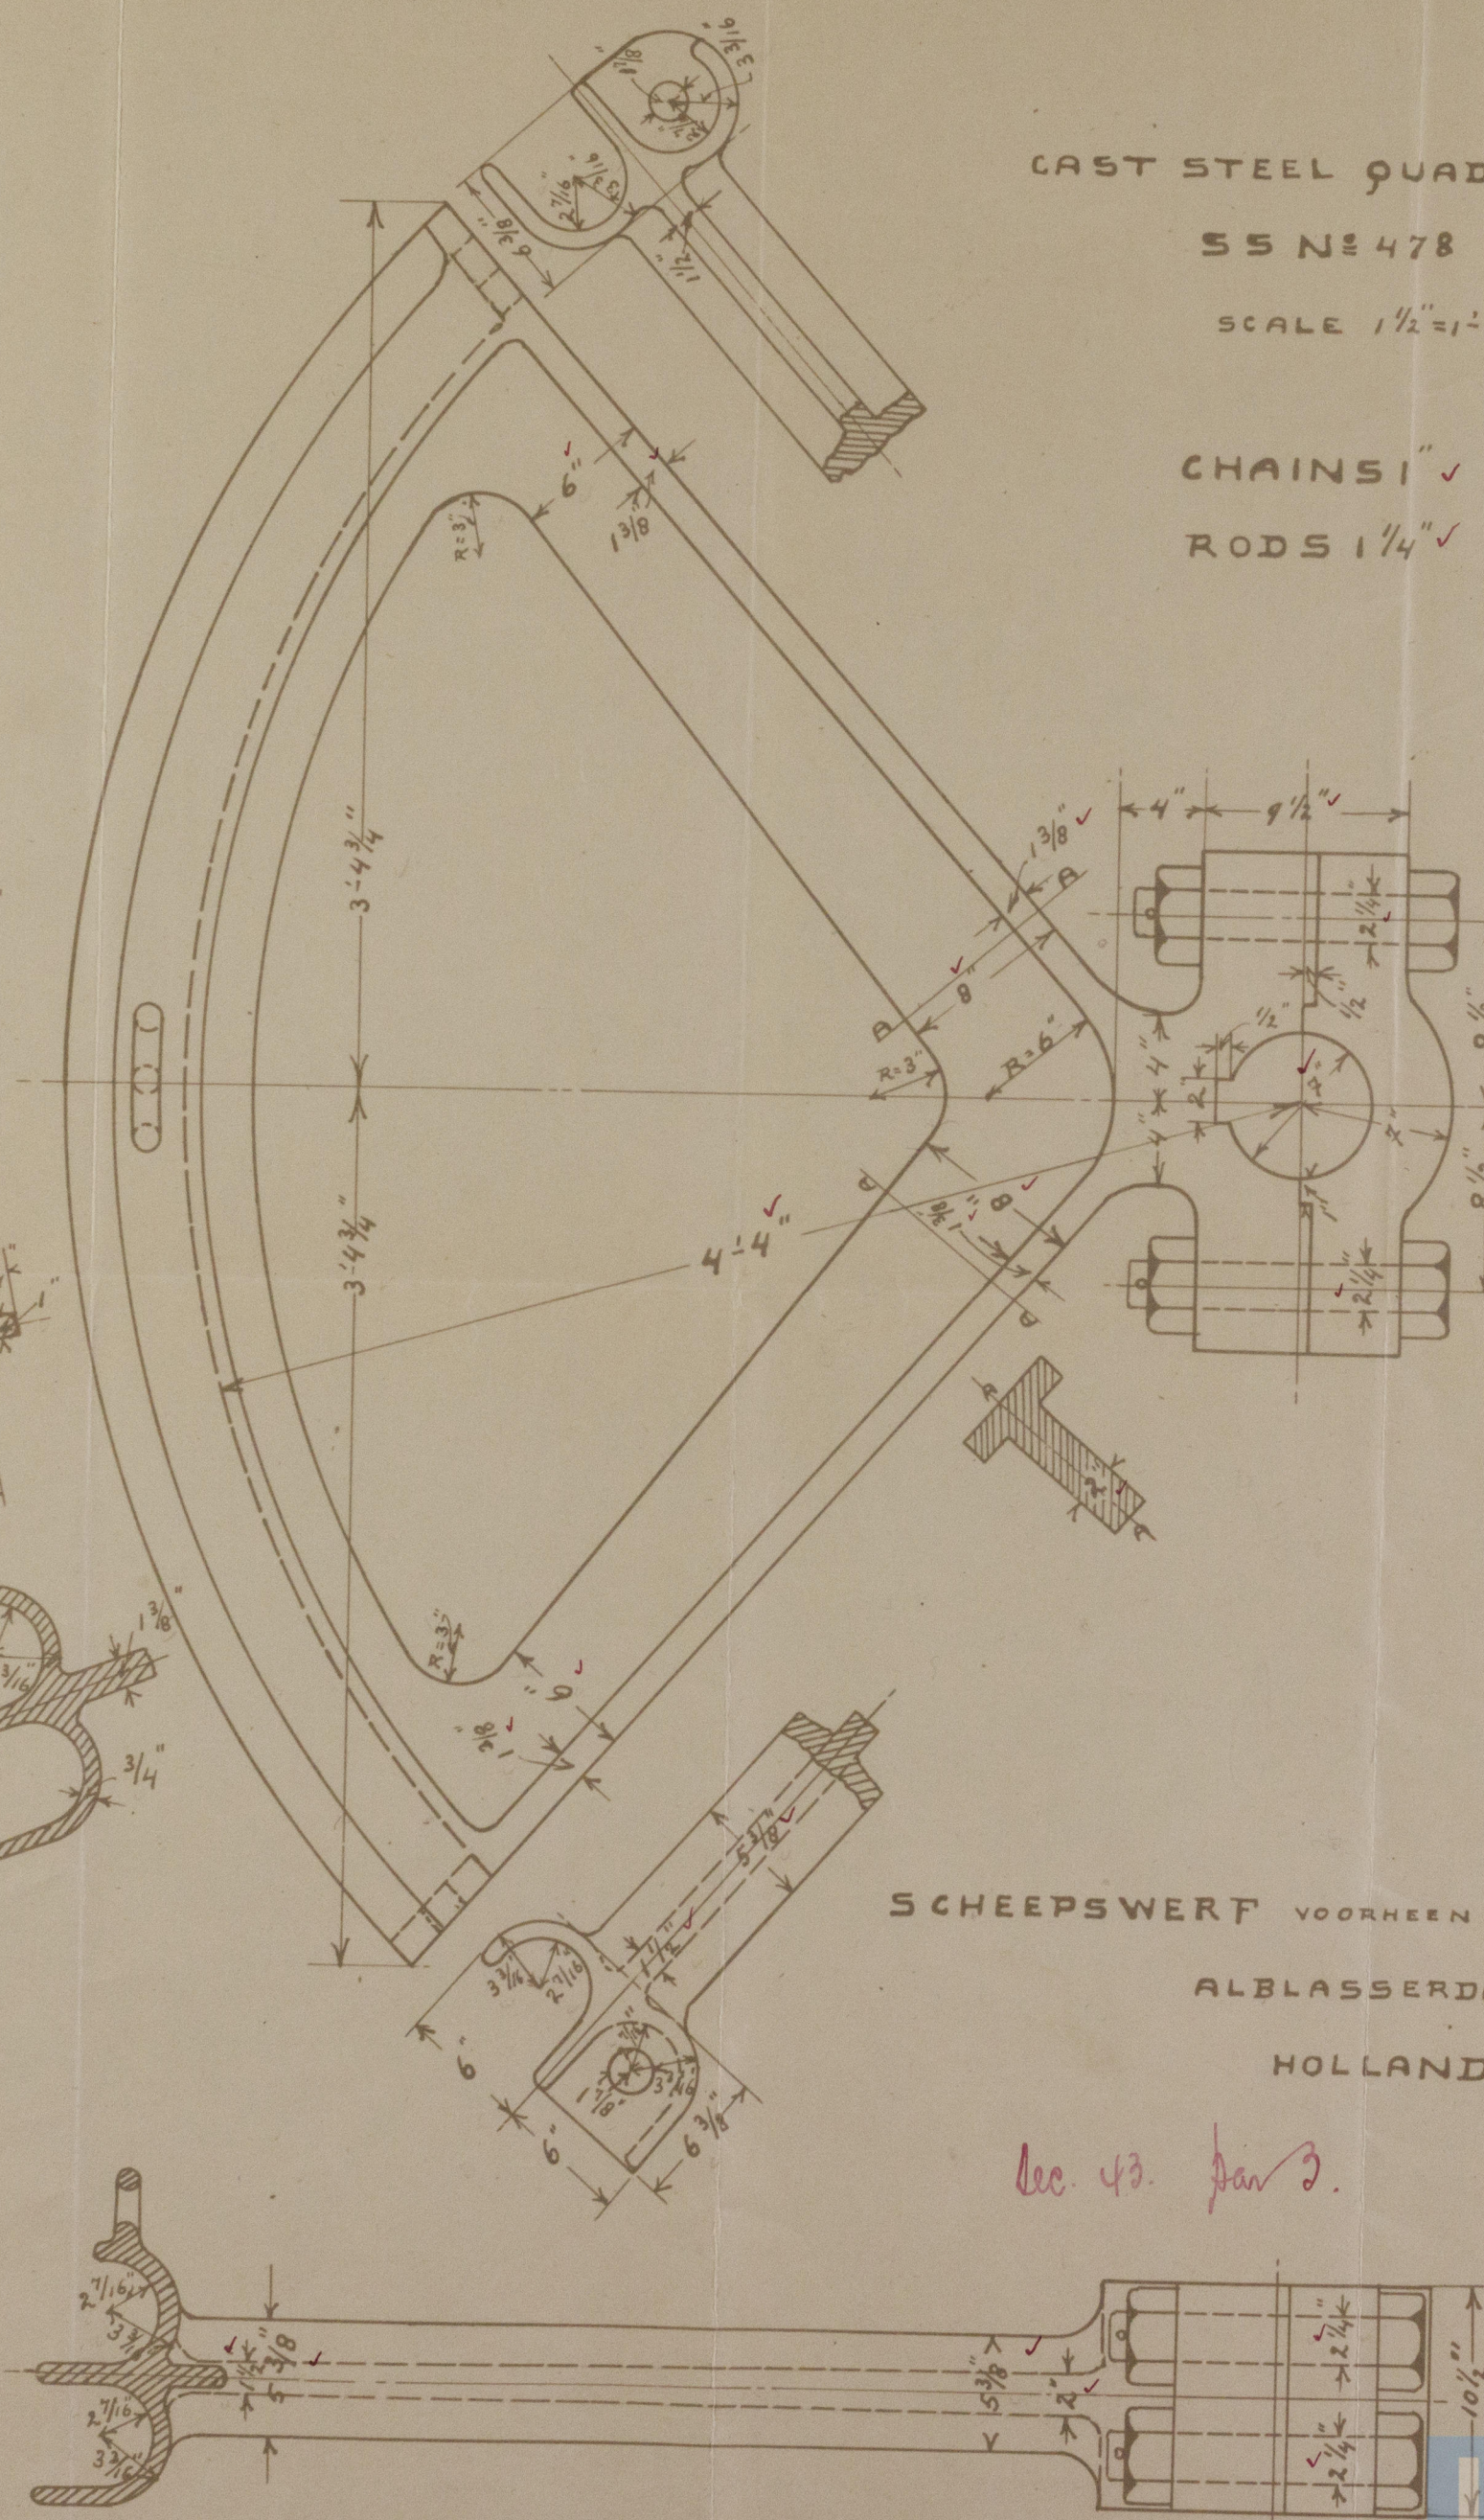
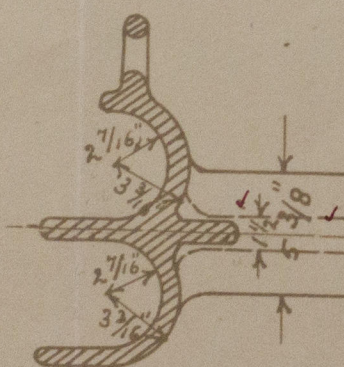
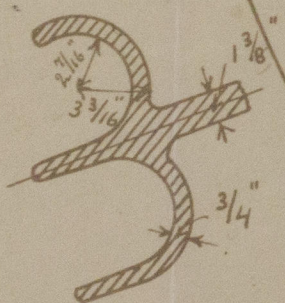


55 № 478

CHAINS 1" ✓

RODS  $1\frac{1}{4}"$  ✓

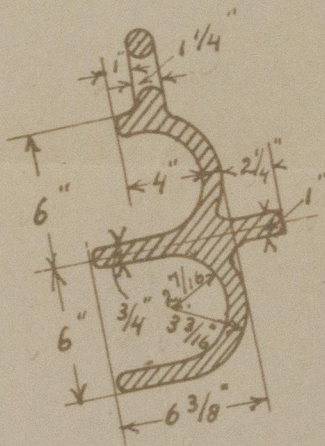

July 4. 6. 15

SCHEEPSWERF VOORHEEN JAN SMIT CZ

ALBLASSERDAM

HOLLAND

Dec. 43. Jan 2.



Lloyd's Register  
Foundation

U 66-00 26




478

Quadrant.

S.S. Sint. Jansland

Plan of. Quadrant.

Rotterdam report. no-10170

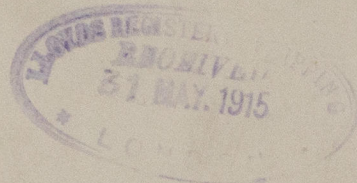

W66-0026



© 2021

Lloyd's Register  
Foundation